


No 53

Survey of 12 Acres in 14-1-16

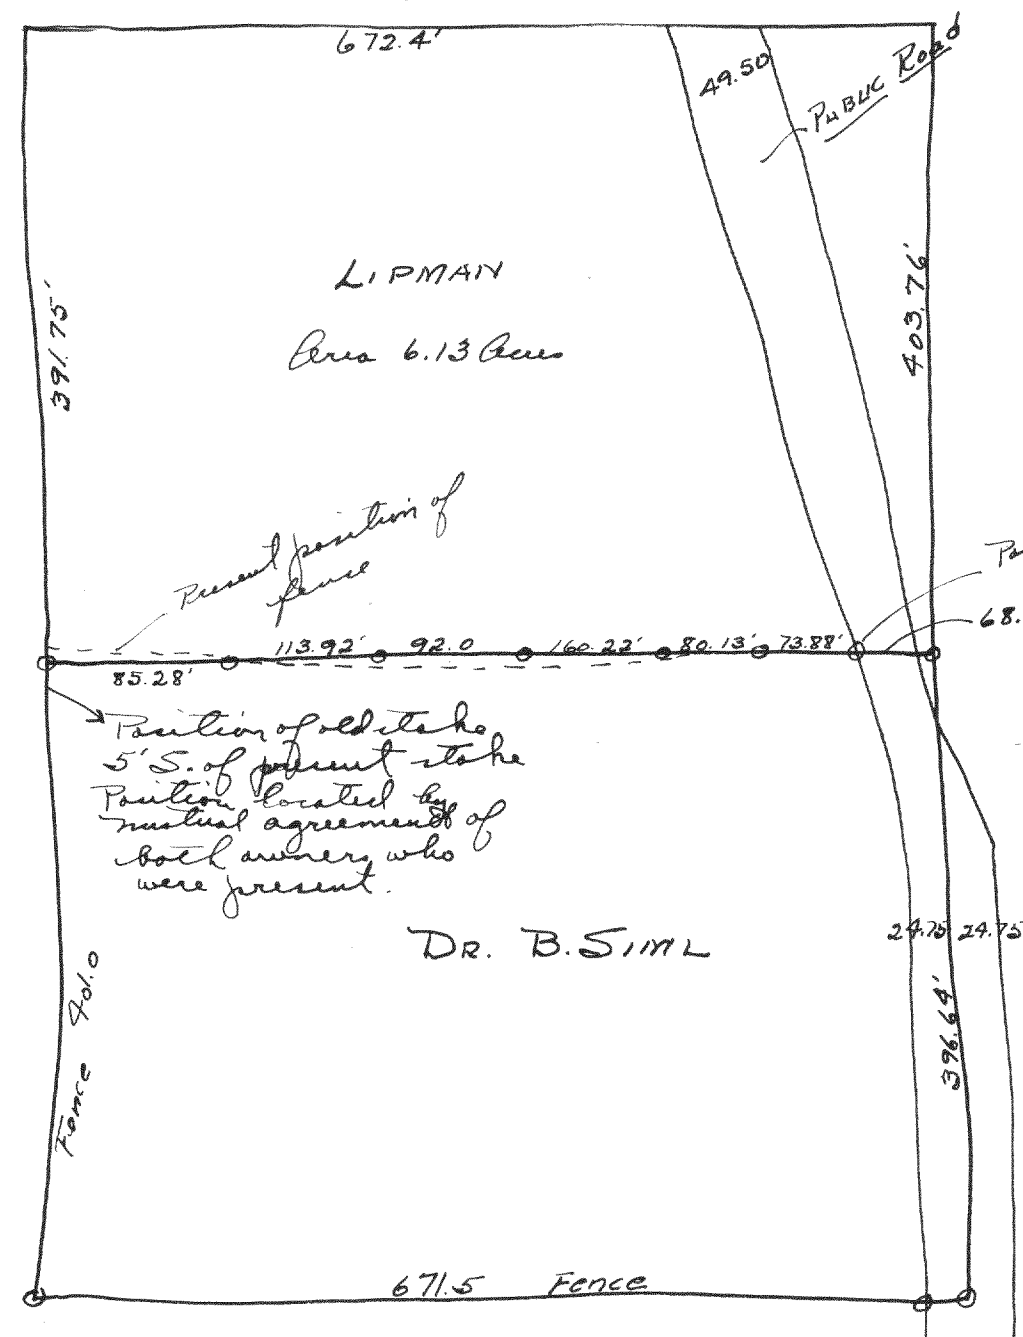


Survey for Dr. B. Siml in the SE $\frac{1}{4}$ of Sec 14-1-16 to locate the division line between his prop. and Mr. Lipman on the north. Both owners were present and a line was established between the two prop., though it varies from the recorded description a small amount.

Aug 7, 1933

Lloyd S. Jensen
C. S. S.

No. 54

Survey of Part of old O. F. Crp farm

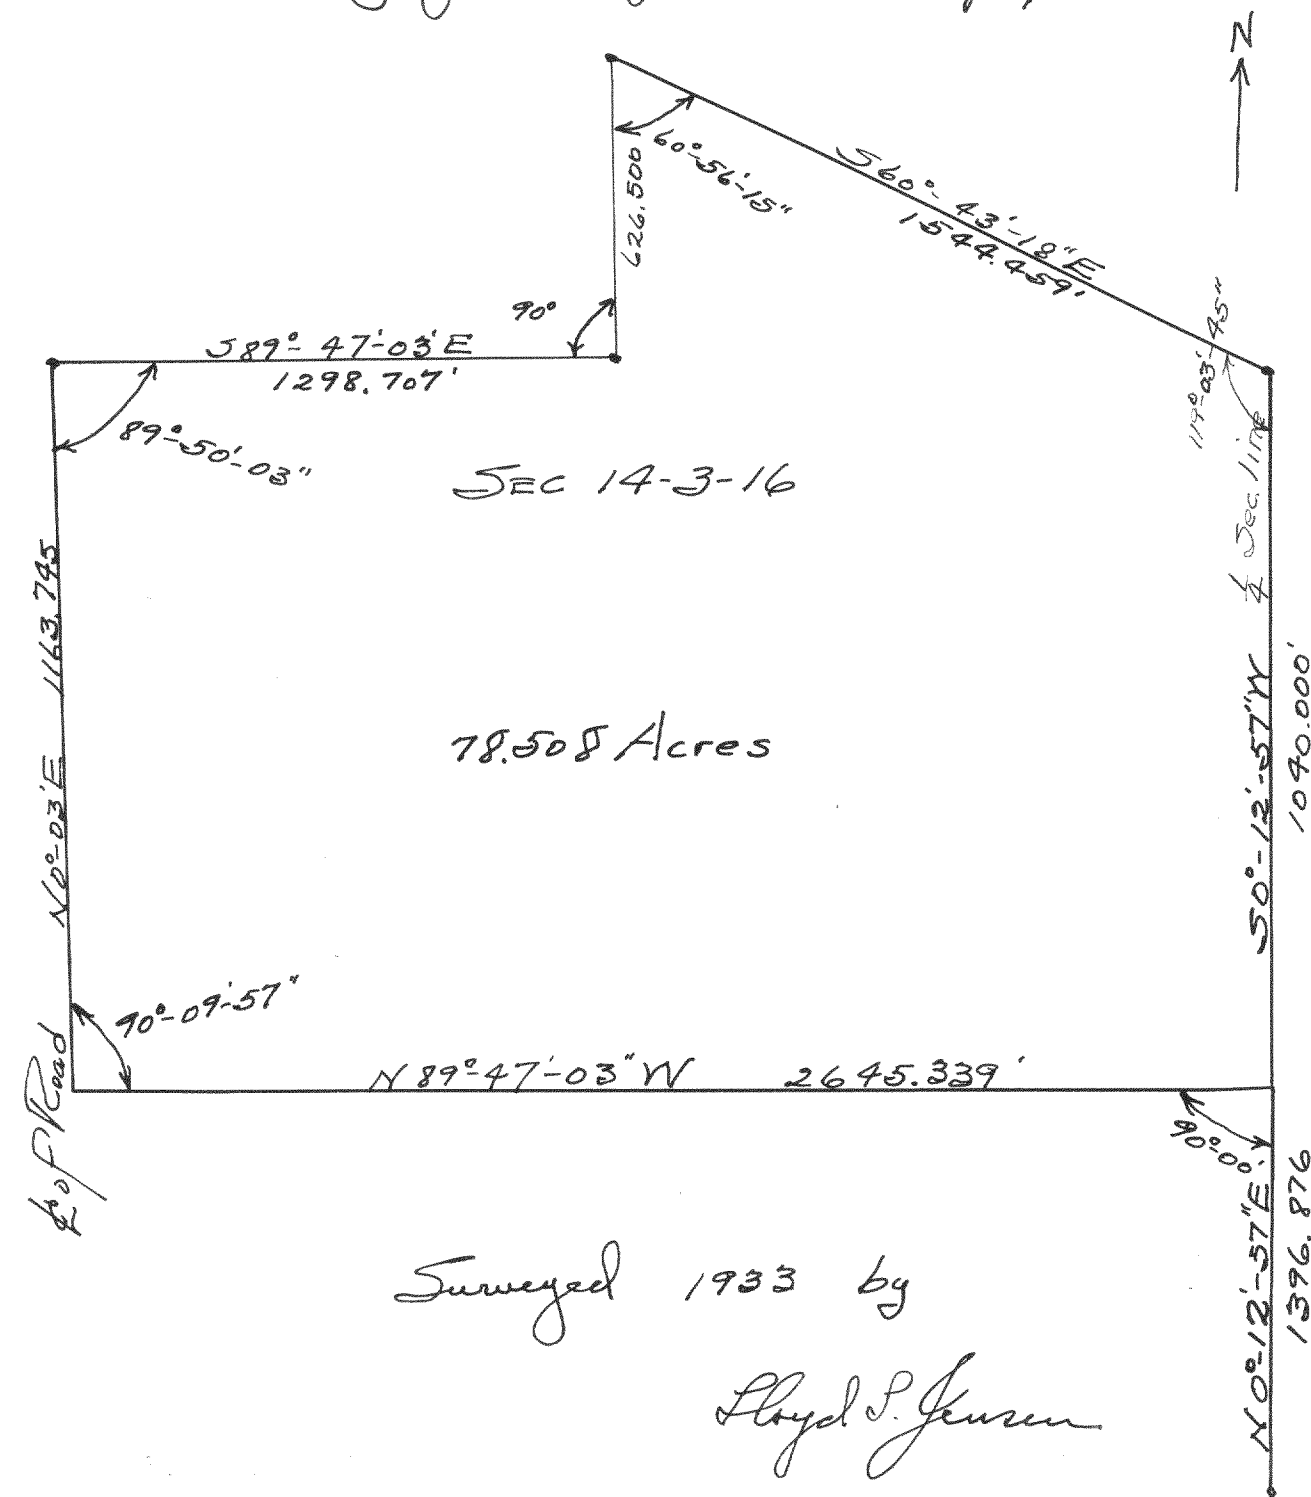

Surveyed 1933 by

Lloyd S. Jensen