


Township..... North of Range..... of 4 Principal Meridian
as presented by the courses and distances on the following plat, and annexed field-notes of survey:
Established the center of the section at the point of intersection of STRAIGHT quarter lines.
Established all quarter-quarter corners upon the section boundary at proportional distances between known section and quarter section corners, according to the original field-notes of the Government survey.
Established all lost corners at proportionate distances between known corners, according to the original field notes of the Government survey.

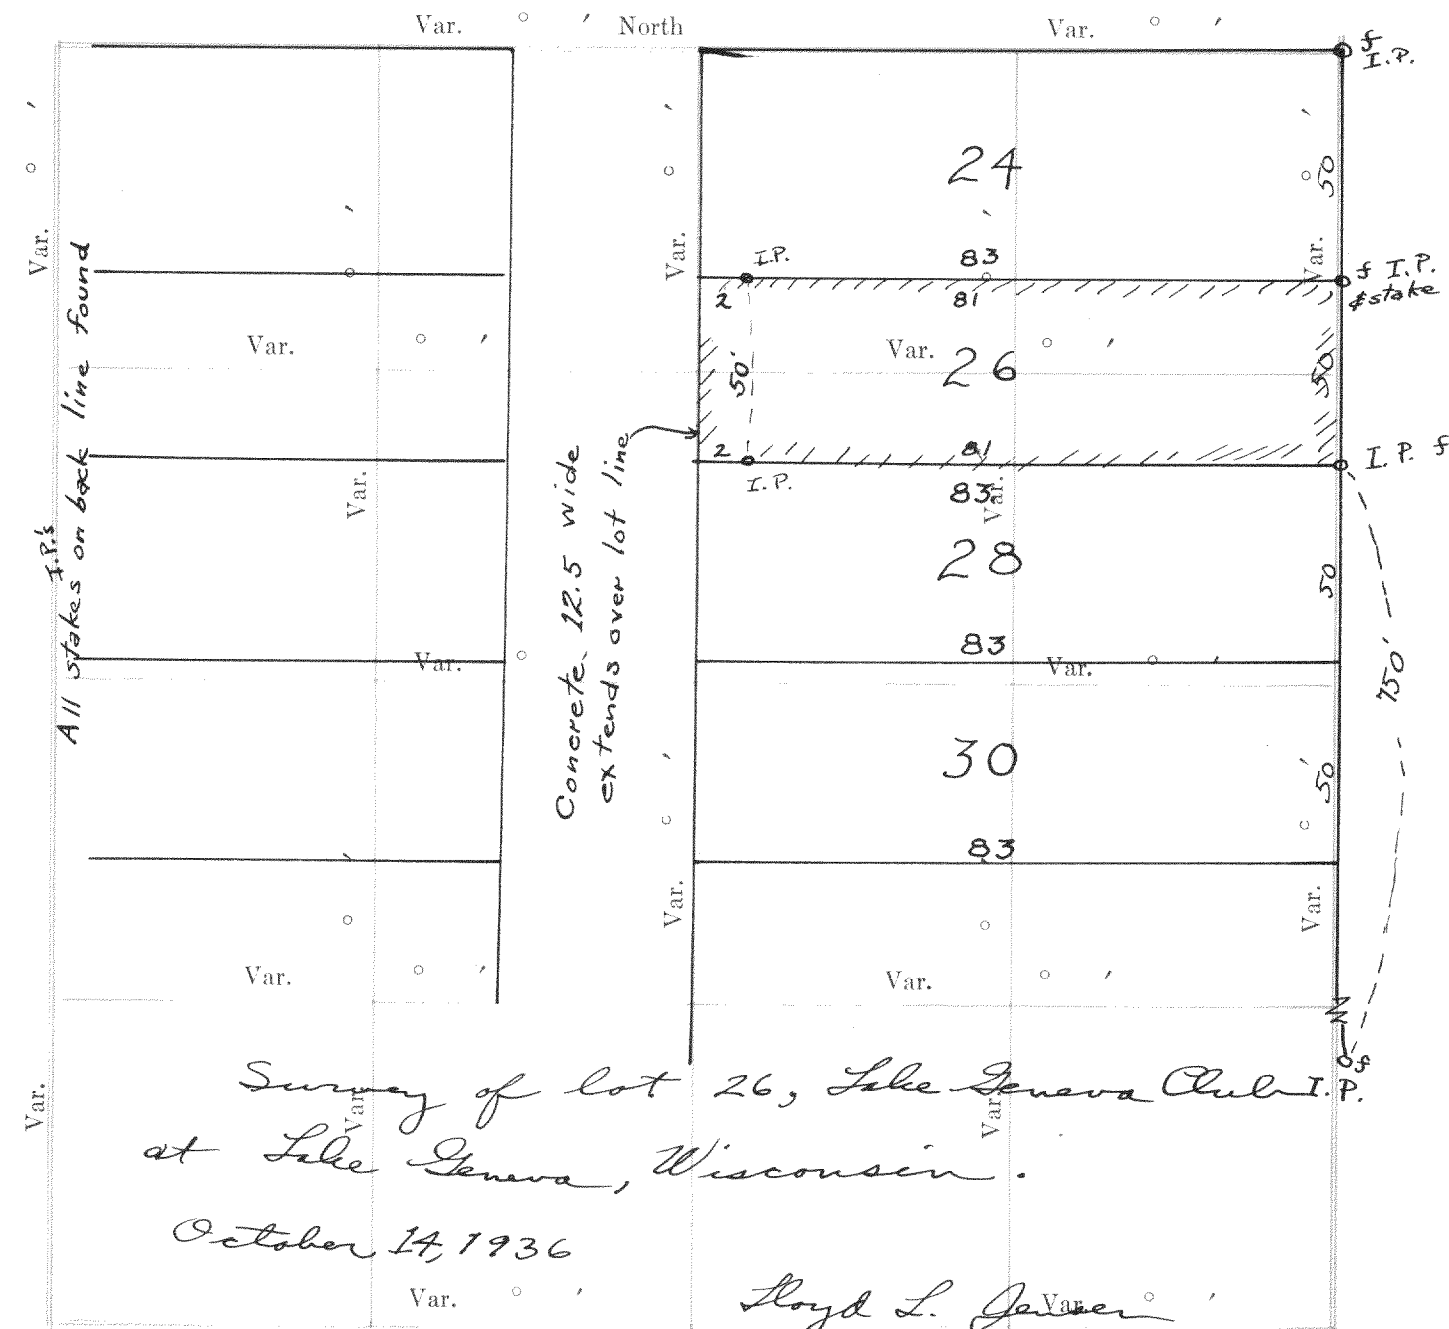

Plat of Section....., Township..... North, Range..... of 4 Principal Meridian Scale
80 chains to 6 inches. The figures in red ink are the lengths of the lines as stated in the field-notes of the
Government survey.


Declination of the Magnetic Meridian from the True Meridian.....
Surveyed and sub-divided..... A. D. 1....., in accordance
with the State Laws and Instructions of the Commissioner of the General Land office, and recorded on pages
..... of Register in the County Clerk's office.
Witness my hand this..... day of..... A. D. 1.....
..... SURVEYOR.

OF SECTION, QUARTER SECTION AND QUARTER QUARTER SECTION CORNERS

- GOVERNMENT CORNERS
- No.
1. N. W. Sec. Cor. identified,
 2. N. E. Sec. Cor. identified,
 3. S. E. Sec. Cor. identified,
 4. S. W. Sec. Cor. identified,
 5. N. $\frac{1}{4}$ Sec. Cor. identified,
 6. E. $\frac{1}{4}$ Sec. Cor. identified,
 7. S. $\frac{1}{4}$ Sec. Cor. identified,
 8. W. $\frac{1}{4}$ Sec. Cor. identified,
- Subdivision Corners
- No.

1. Center $\frac{1}{4}$ Sec. Cor.
2. North $\frac{1}{4}$ - $\frac{1}{4}$ s N. W. qr.,
3. East $\frac{1}{4}$ - $\frac{1}{4}$ s N. W. qr.,
4. South $\frac{1}{4}$ - $\frac{1}{4}$ s N. W. qr.,
5. West $\frac{1}{4}$ - $\frac{1}{4}$ s N. W. qr.,
6. Center $\frac{1}{4}$ - $\frac{1}{4}$ s N. W. qr.,
7. North $\frac{1}{4}$ - $\frac{1}{4}$ s N. E. qr.,
8. East $\frac{1}{4}$ - $\frac{1}{4}$ s N. E. qr.,
9. South $\frac{1}{4}$ - $\frac{1}{4}$ s N. E. qr.,
10. Center $\frac{1}{4}$ - $\frac{1}{4}$ s N. E. qr.,
11. East $\frac{1}{4}$ - $\frac{1}{4}$ s S. E. qr.,
12. South $\frac{1}{4}$ - $\frac{1}{4}$ s S. E. qr.,
13. West $\frac{1}{4}$ - $\frac{1}{4}$ s S. E. qr.,
14. Center $\frac{1}{4}$ - $\frac{1}{4}$ s S. E. qr.,
15. South $\frac{1}{4}$ - $\frac{1}{4}$ s S. W. qr.,
16. West $\frac{1}{4}$ - $\frac{1}{4}$ s S. W. qr.,
17. Center $\frac{1}{4}$ - $\frac{1}{4}$ s S. W. qr.,

No. 724

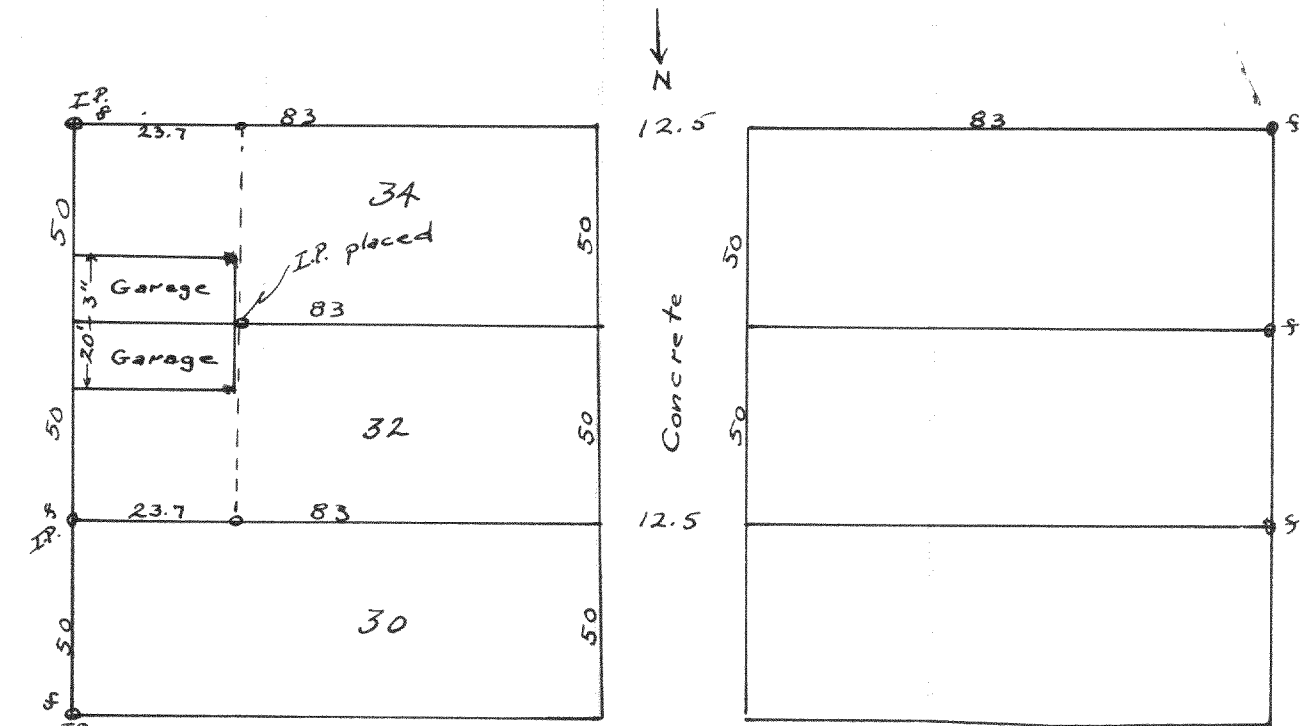

Survey for Mrs. Vera Sand at
Lake Geneva Club to locate lot line 34 & 32
in front of garages.

October 14, 1936

Lloyd L. Jensen
County Surveyor
By W. E. H.

NAMES OF SWORN ASSISTANTS


CHAINMEN

FLAGMEN

AXMEN

232

No. 725

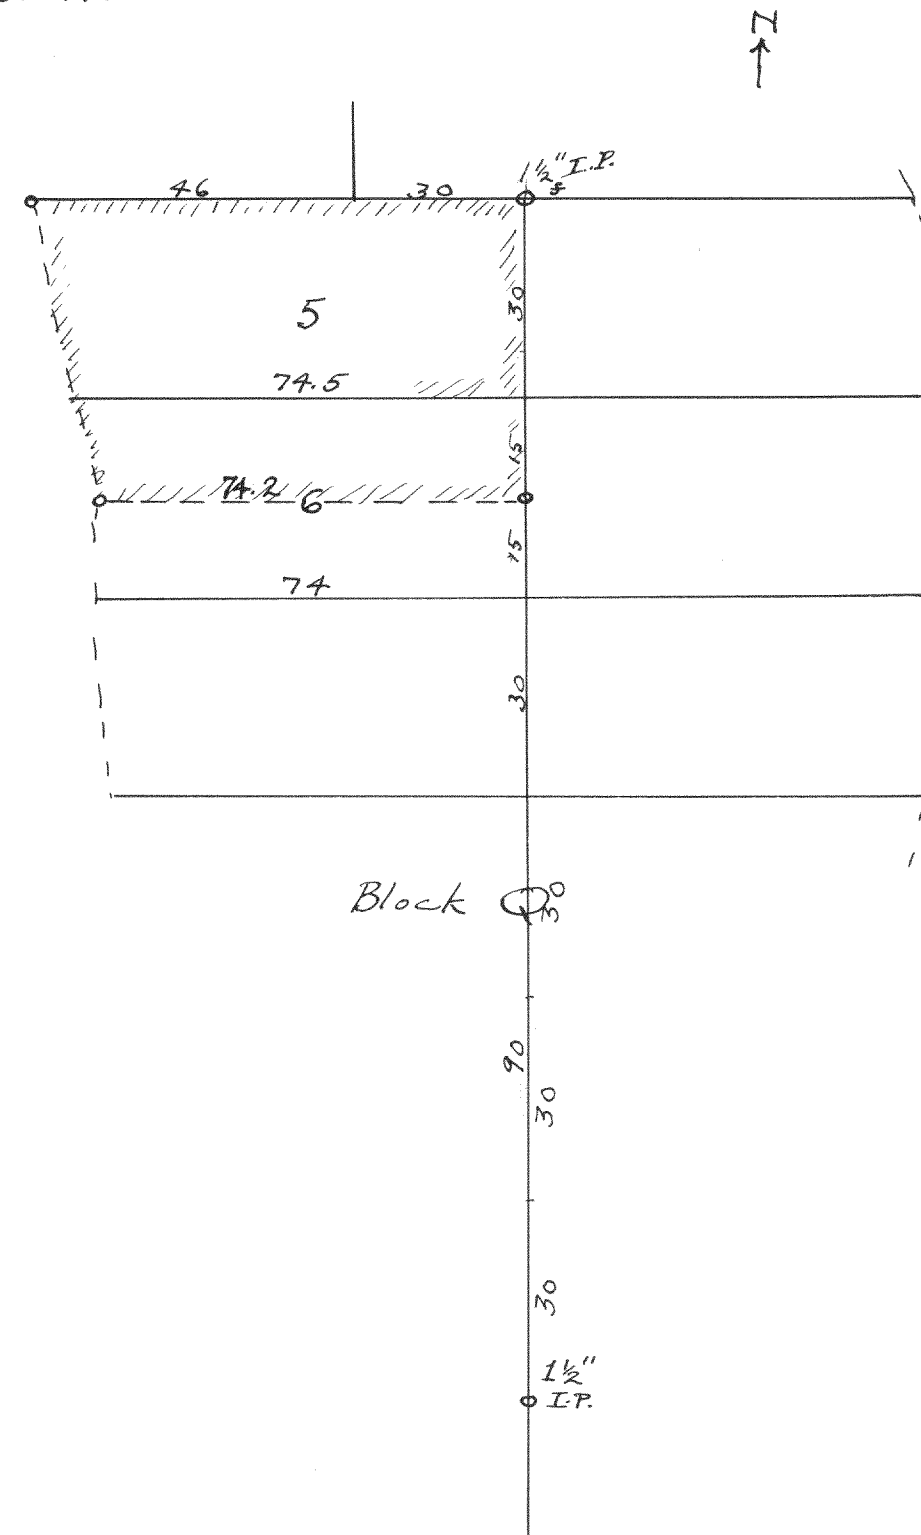


Survey of lot 5 & South $\frac{1}{2}$ of lot 6, Block Q
for Art. Anderson in the Assembly Grounds
at Lake Delavan, Wisconsin.

October 14, 1936

Lloyd L. Jensen
County Surveyor
By W. E. H.

No. 726

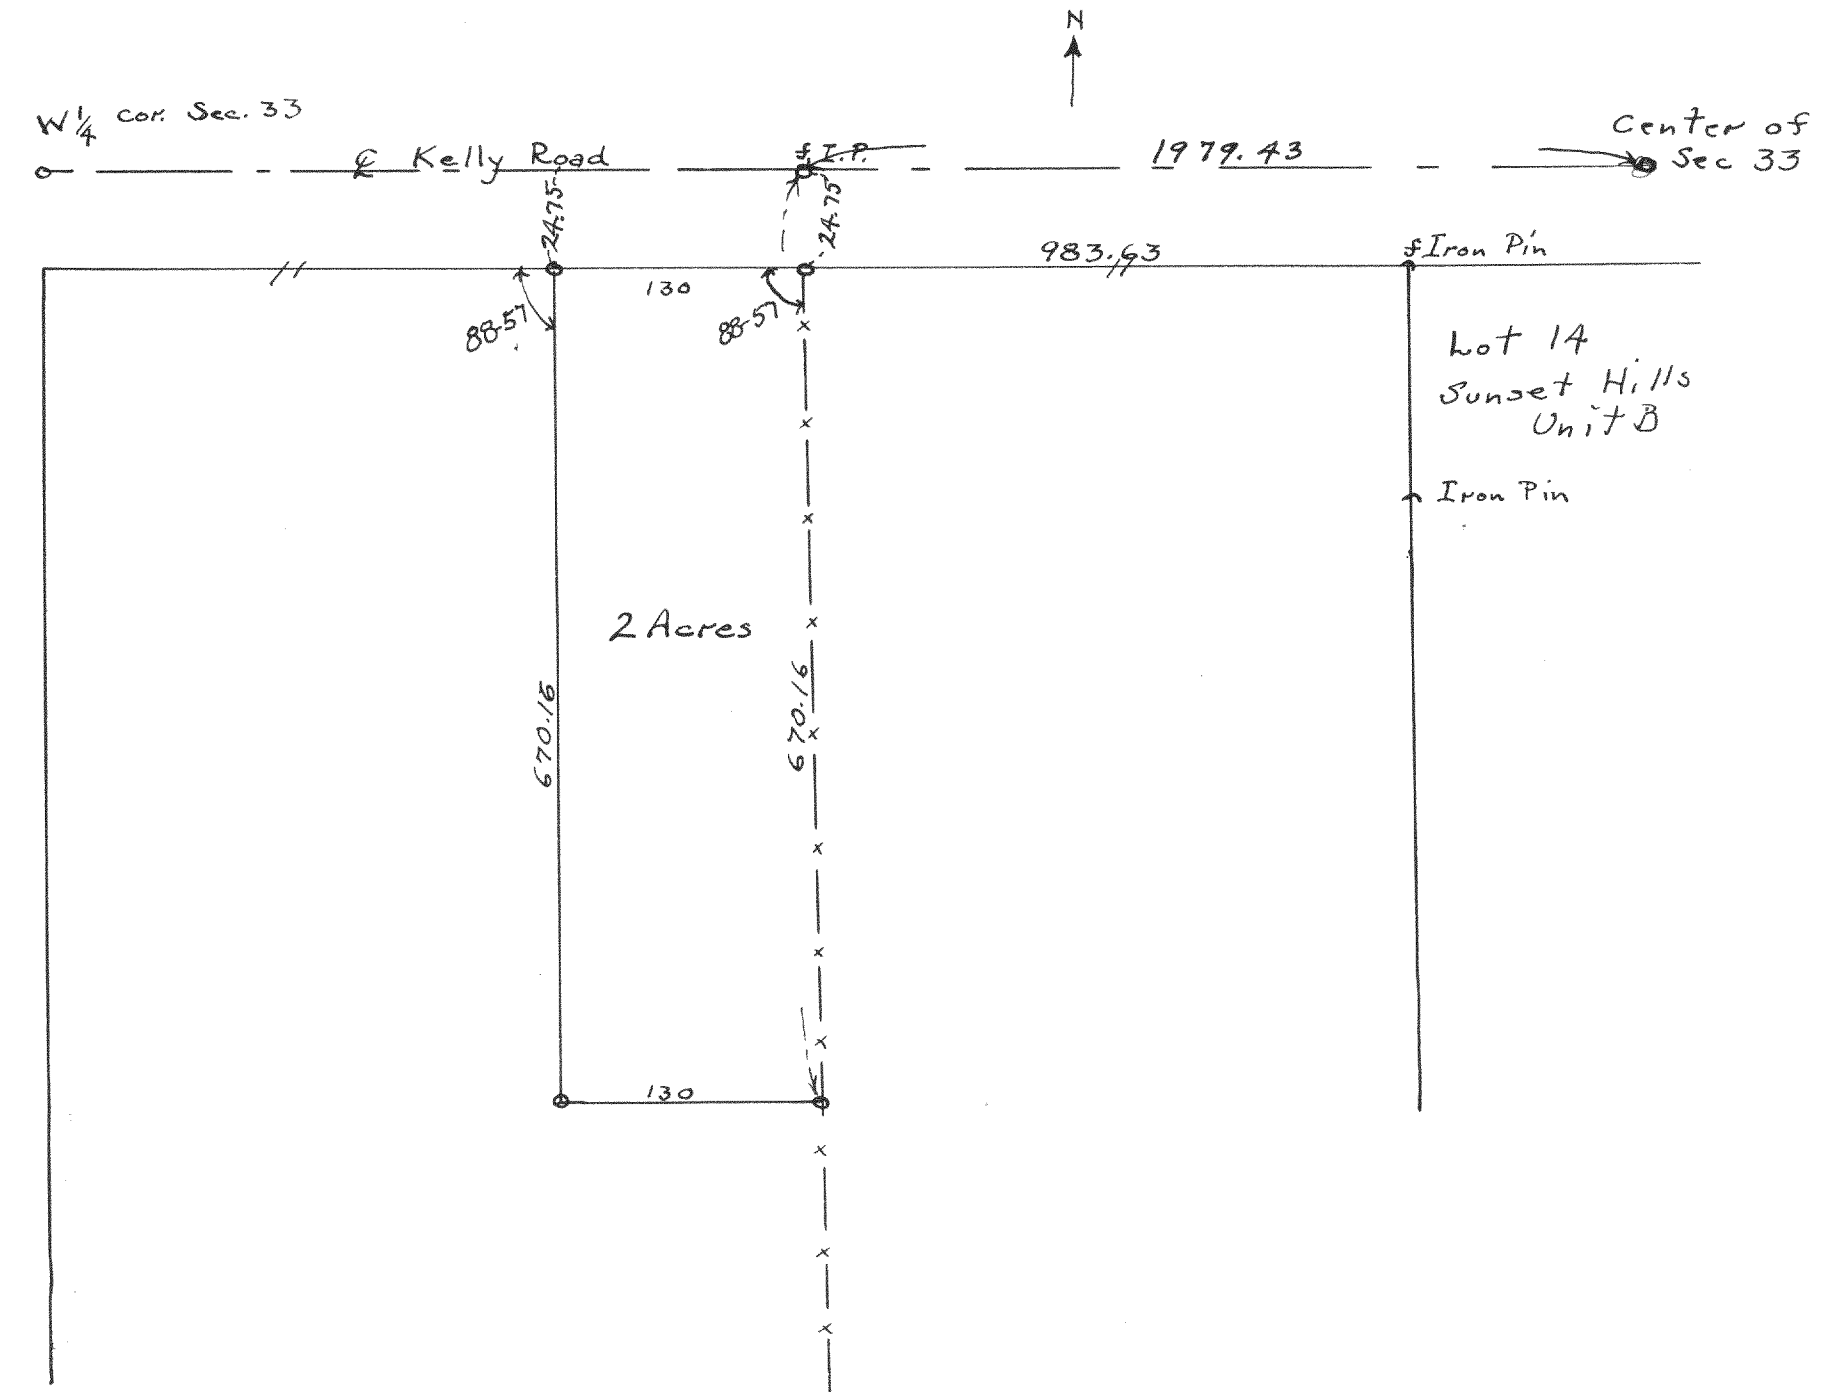

Survey for George Dayton of a
2 acres parcel in Sec 33, T2N, R17E
taken from 20 acres owned by Art Krouse.

Oct. 16, 1936

Lloyd L. Jensen
County Surveyor
By W. E. H.