


Township....., North of Range..... of 4 Principal Meridian
as presented by the courses and distances on the following plat, and annexed field-notes of survey:

Established the center of the section at the point of intersection of STRAIGHT quarter lines.

Established all quarter-quarter corners upon the section boundary at proportional distances between known section and quarter section corners, according to the original field-notes of the Government survey.

Established all lost corners at proportionate distances between known corners, according to the original field notes of the Government survey.

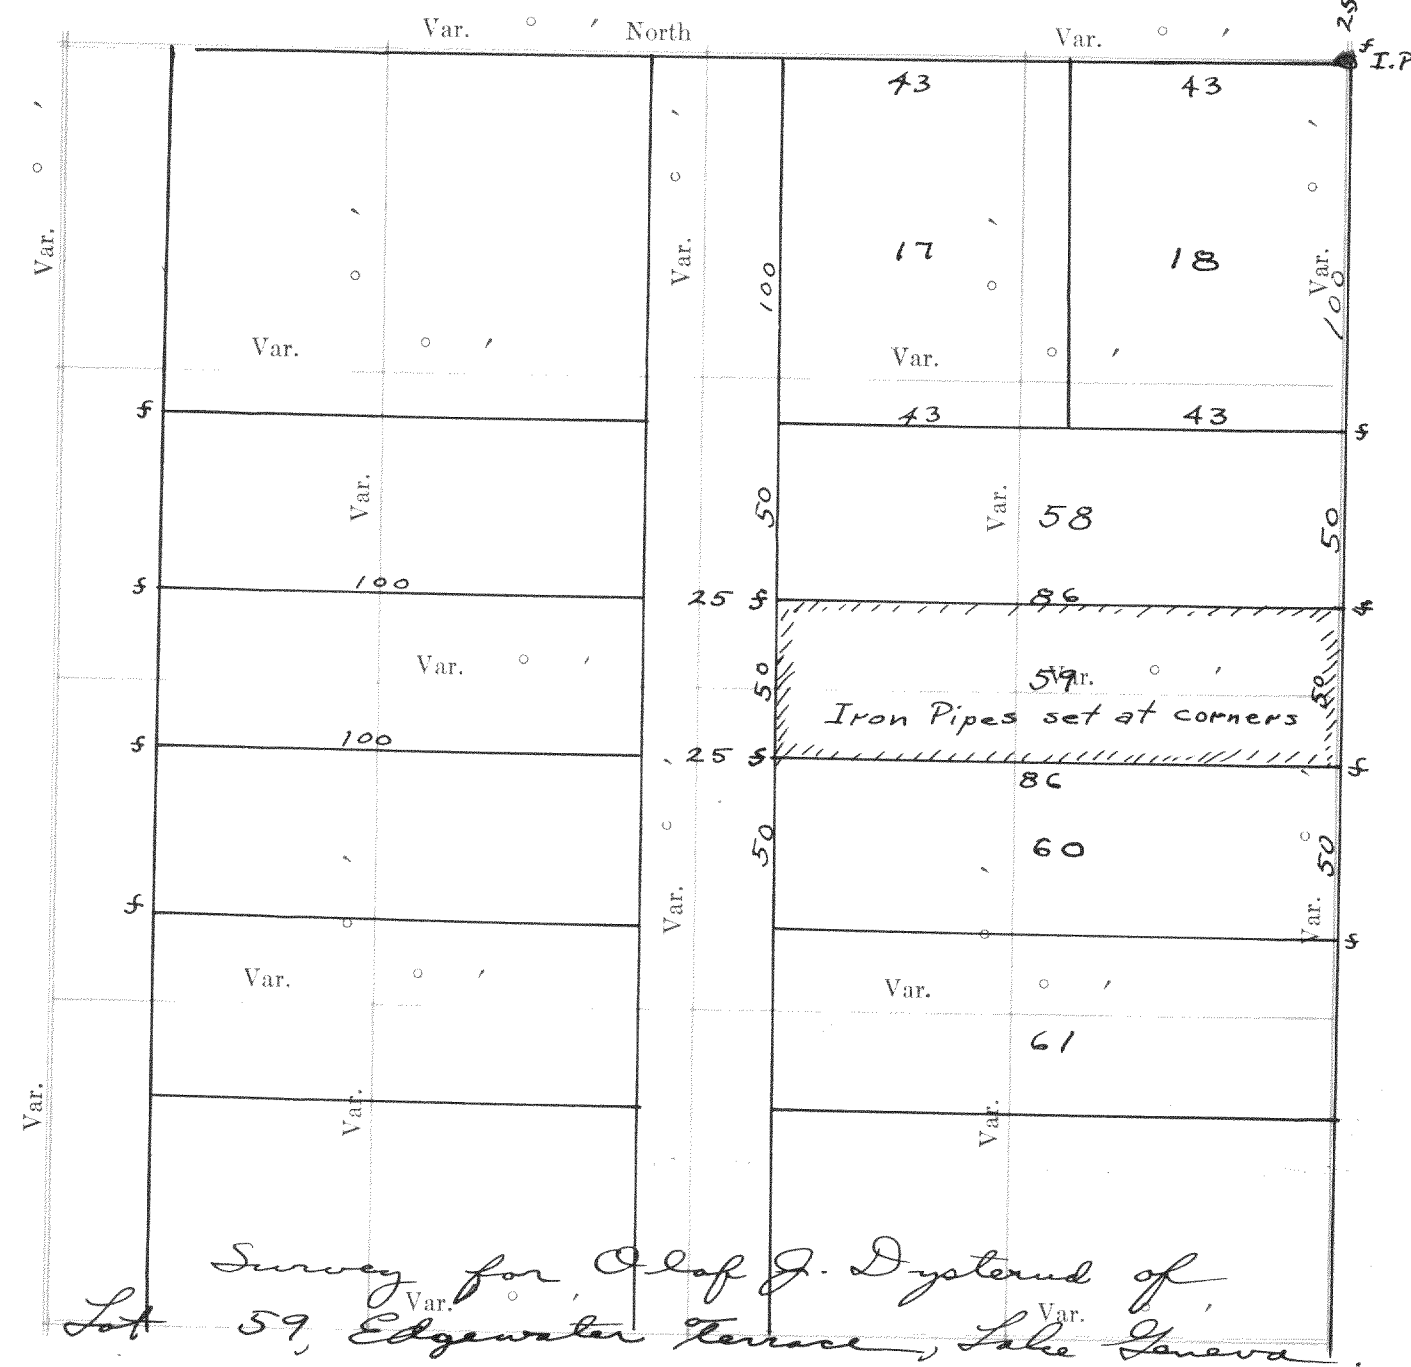

OF SECTION, QUARTER SECTION AND QUARTER QUARTER SECTION CORNERS

GOVERNMENT CORNERS

No.

1. N. W. Sec. Cor. unidentified
2. N. E. Sec. Cor. unidentified
3. S. E. Sec. Cor. unidentified
4. S. W. Sec. Cor. unidentified
5. N. $\frac{1}{4}$ Sec. Cor. unidentified.
6. E. $\frac{1}{4}$ Sec. Cor. unidentified.
7. S. $\frac{1}{4}$ Sec. Cor. unidentified.
8. W. $\frac{1}{4}$ Sec. Cor. unidentified.

Subdivision Corners

- No.
1. Center $\frac{1}{4}$ Sec. Cor.
2. North $\frac{1}{4}$ - $\frac{1}{4}$ s N. W. qr.,
3. East $\frac{1}{4}$ - $\frac{1}{4}$ s N. W. qr.,
4. South $\frac{1}{4}$ - $\frac{1}{4}$ s N. W. qr.,
5. West $\frac{1}{4}$ - $\frac{1}{4}$ s N. W. qr.,
6. Center $\frac{1}{4}$ - $\frac{1}{4}$ s N. W. qr.,
7. North $\frac{1}{4}$ - $\frac{1}{4}$ s N. E. qr.,
8. East $\frac{1}{4}$ - $\frac{1}{4}$ s N. E. qr.,
9. South $\frac{1}{4}$ - $\frac{1}{4}$ s N. E. qr.,
10. Center $\frac{1}{4}$ - $\frac{1}{4}$ s N. E. qr.,
11. East $\frac{1}{4}$ - $\frac{1}{4}$ s S. E. qr.,
12. South $\frac{1}{4}$ - $\frac{1}{4}$ s S. E. qr.,
13. West $\frac{1}{4}$ - $\frac{1}{4}$ s S. E. qr.,
14. Center $\frac{1}{4}$ - $\frac{1}{4}$ s S. E. qr.,
15. South $\frac{1}{4}$ - $\frac{1}{4}$ s S. W. qr.,
16. West $\frac{1}{4}$ - $\frac{1}{4}$ s S. W. qr.,
17. Center $\frac{1}{4}$ - $\frac{1}{4}$ s S. W. qr.

