


Record of Survey.

Township....., North of Range.....of 4 Principal Meridian
as presented by the courses and distances on the following plat, and annexed field-notes of survey:
Established the center of the section at the point of intersection of STRAIGHT quarter lines.
Established all quarter-quarter corners upon the section boundary at proportional distances between known section and quarter section corners, according to the original field-notes of the Government survey.
Established all lost corners at proportionate distances between known corners, according to the original field notes of the Government survey.

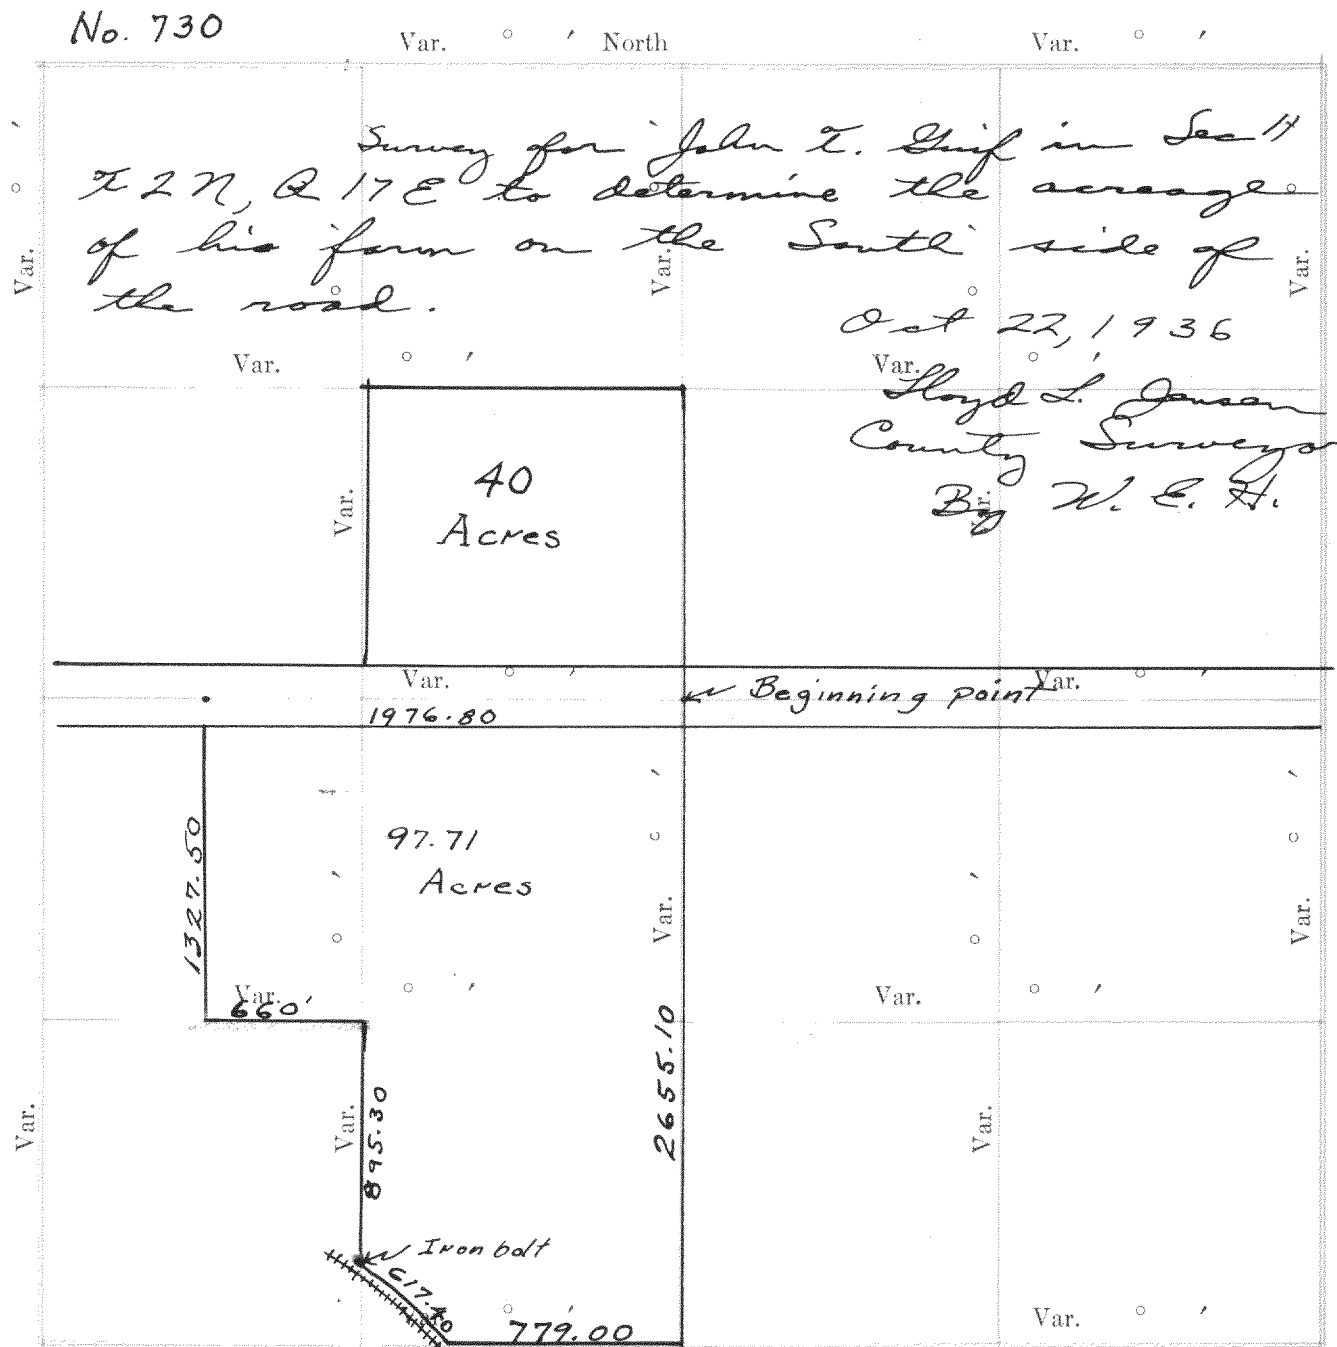

Plat of Section.....11....., Township.....2.....North, Range.....17 E.....of 4 Principal Meridian Scale 80 chains to 6 inches. The figures in red ink are the lengths of the lines as stated in the field-notes of the Government survey.

Declination of the Magnetic Meridian from the True Meridian.....


Surveyed and sub-divided.....A. D. 1....., in accordance with the State Laws and Instructions of the Commissioner of the General Land office, and recorded on pages.....of Register in the County Clerk's office.

Witness my hand this.....day of.....A. D. 1.....

.....SURVEYOR.

DESCRIPTION

OF SECTION, QUARTER SECTION AND QUARTER QUARTER SECTION CORNERS

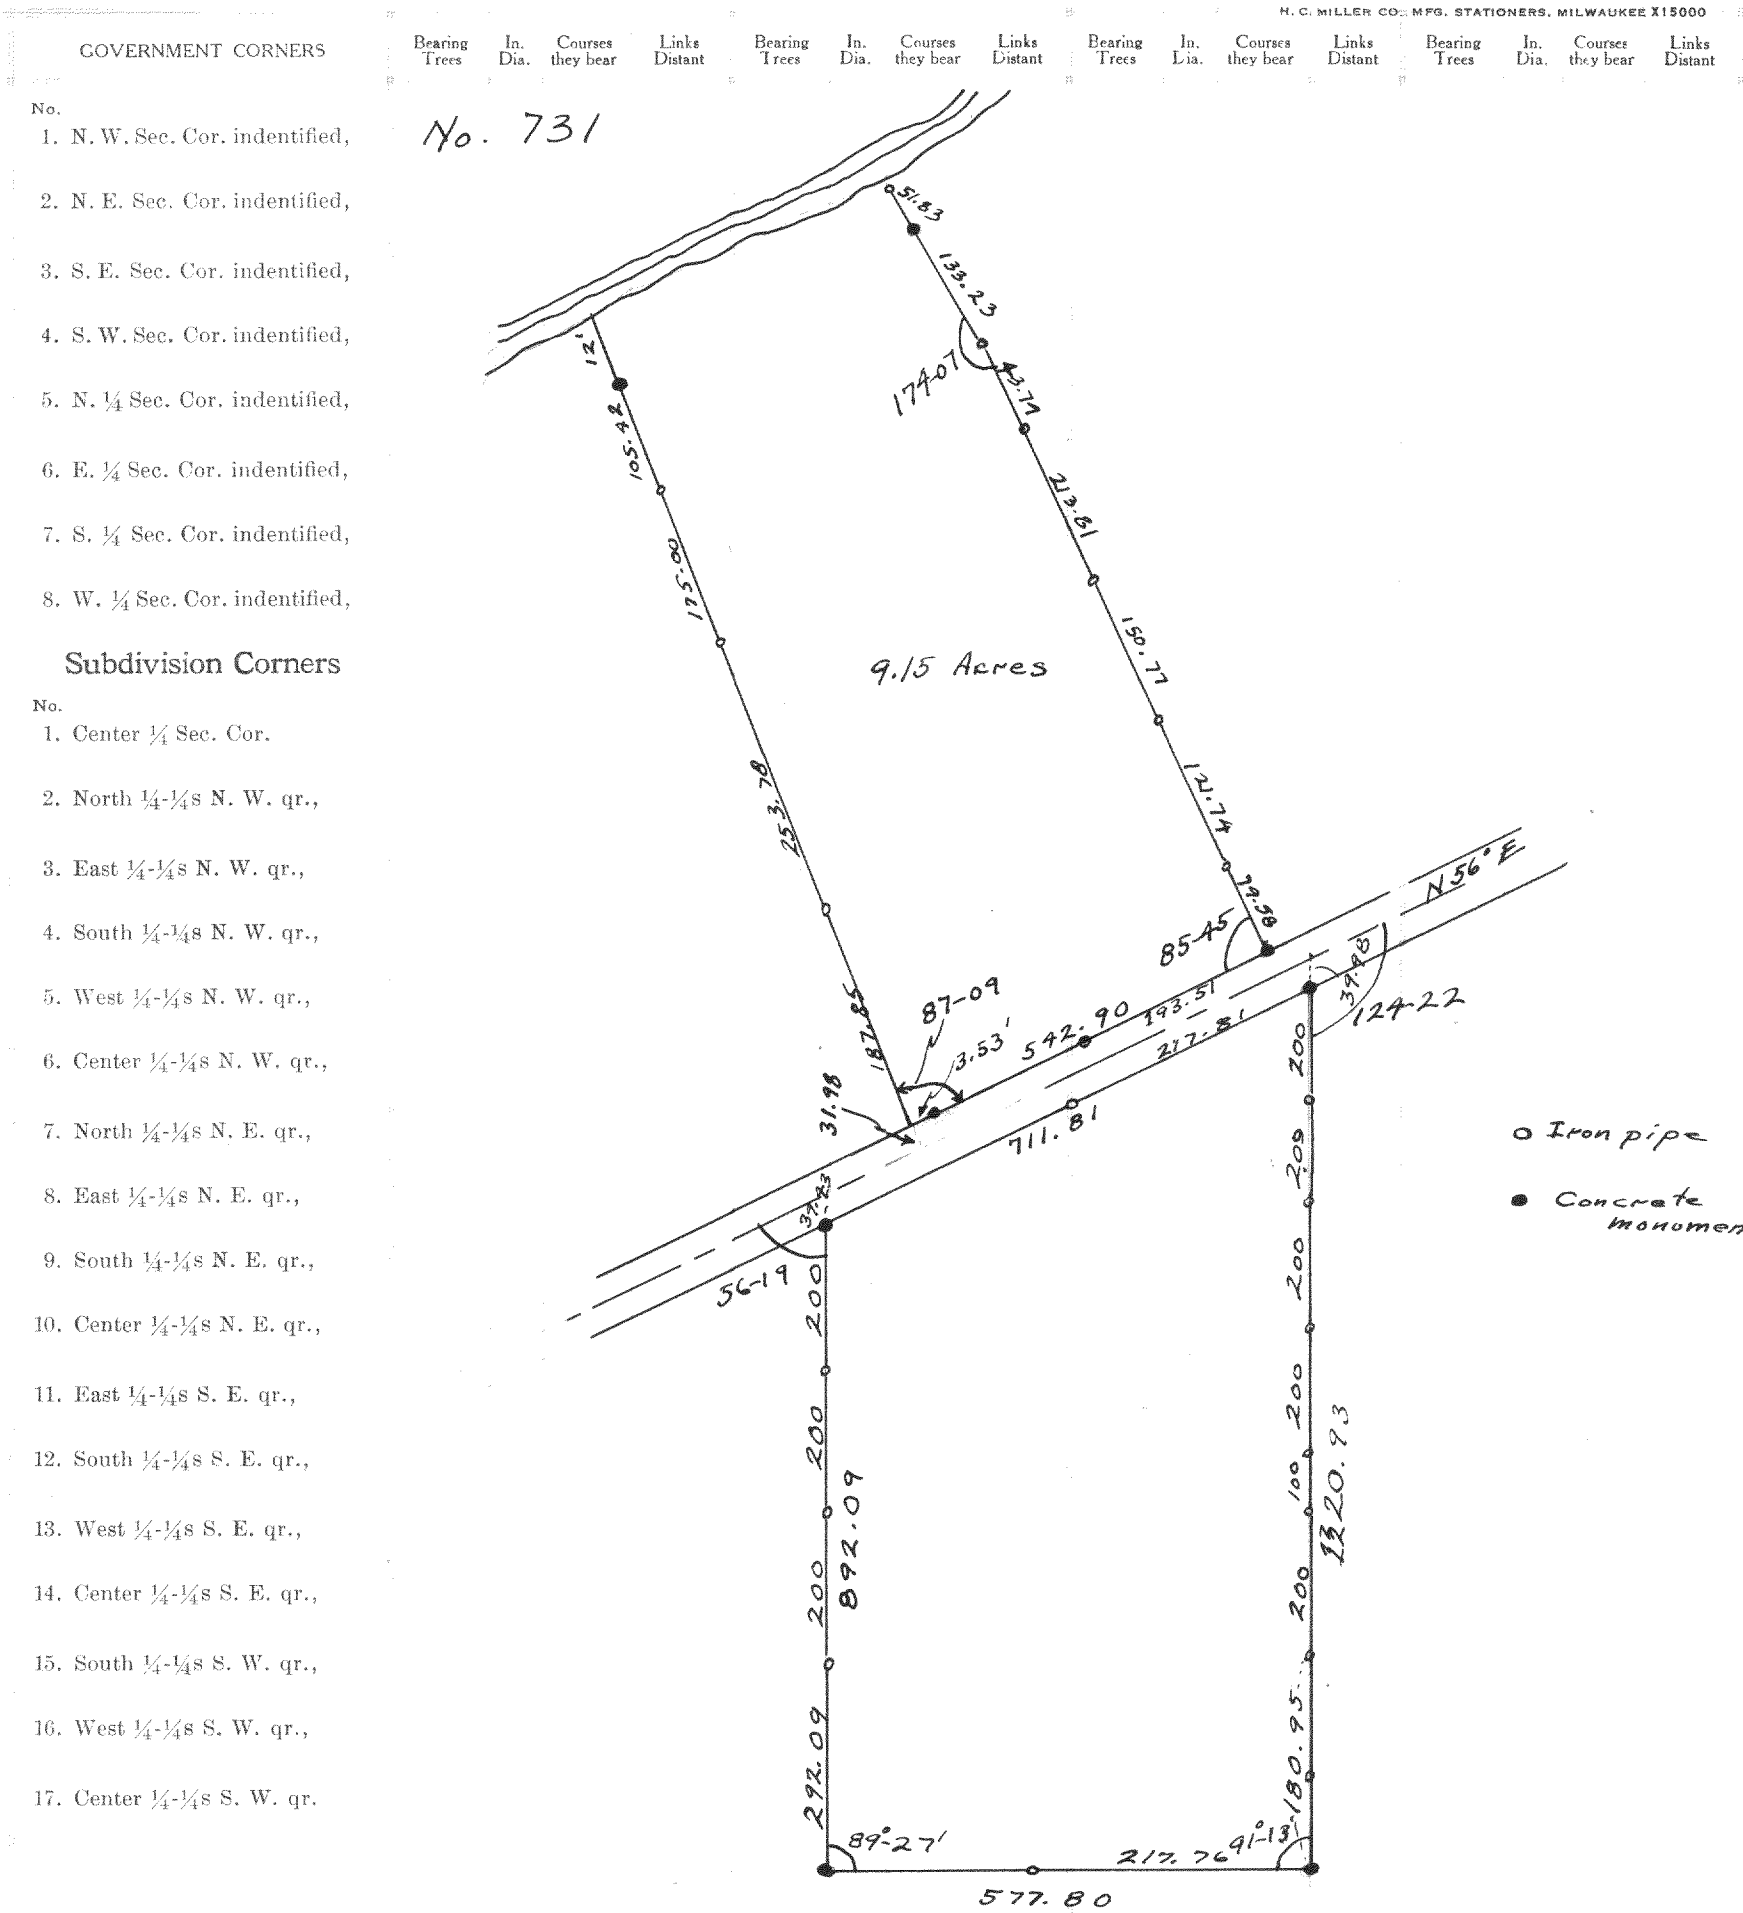

NAMES OF SWORN ASSISTANTS

CHAINMEN

FLAGMEN


AXMEN

Survey ordered by Homer Lasky at Delavan Lake, Wisconsin of Wall's property in Sec 33 of T2N, R16E.

Lloyd L. Jansen
County Surveyor
By W. E. H.


234 (aid for including "No. 732")

No. 733

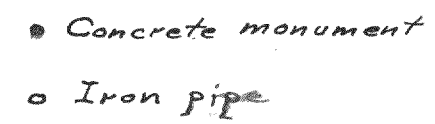

Survey for Mr. Hicks of a parcel purchased from Mr. Elbeck and placing of concrete monuments as shown.

Lloyd L. Jensen
County Surveyor
By W. E. H.

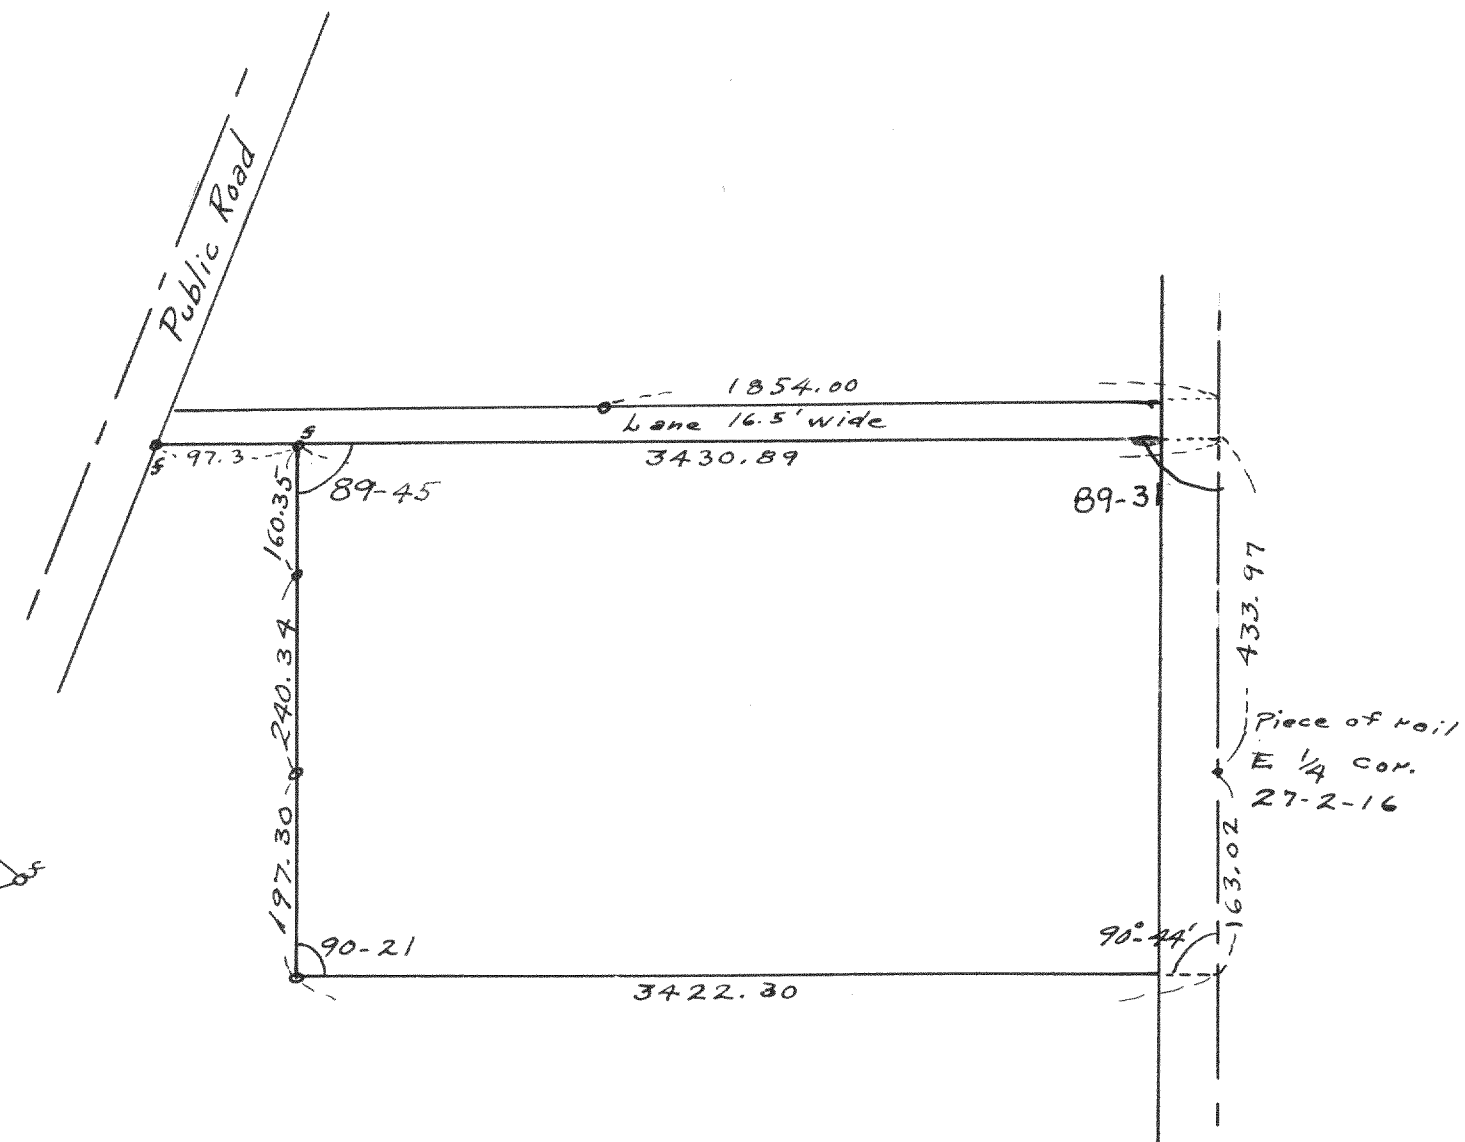

Survey of the farm of Michael Duggan

Lloyd L. Jensen
County Surveyor
By W. E. H.