

Record of Survey.


Township....., North of Range.....of 4 Principal Meridian
as presented by the courses and distances on the following plat, and annexed field-notes of survey:

Established the center of the section at the point of intersection of STRAIGHT quarter lines.

Established all quarter-quarter corners upon the section boundary at proportional distances between known section and quarter section corners, according to the original field-notes of the Government survey.

Established all lost corners at proportionate distances between known corners, according to the original field notes of the Government survey.

No. 742

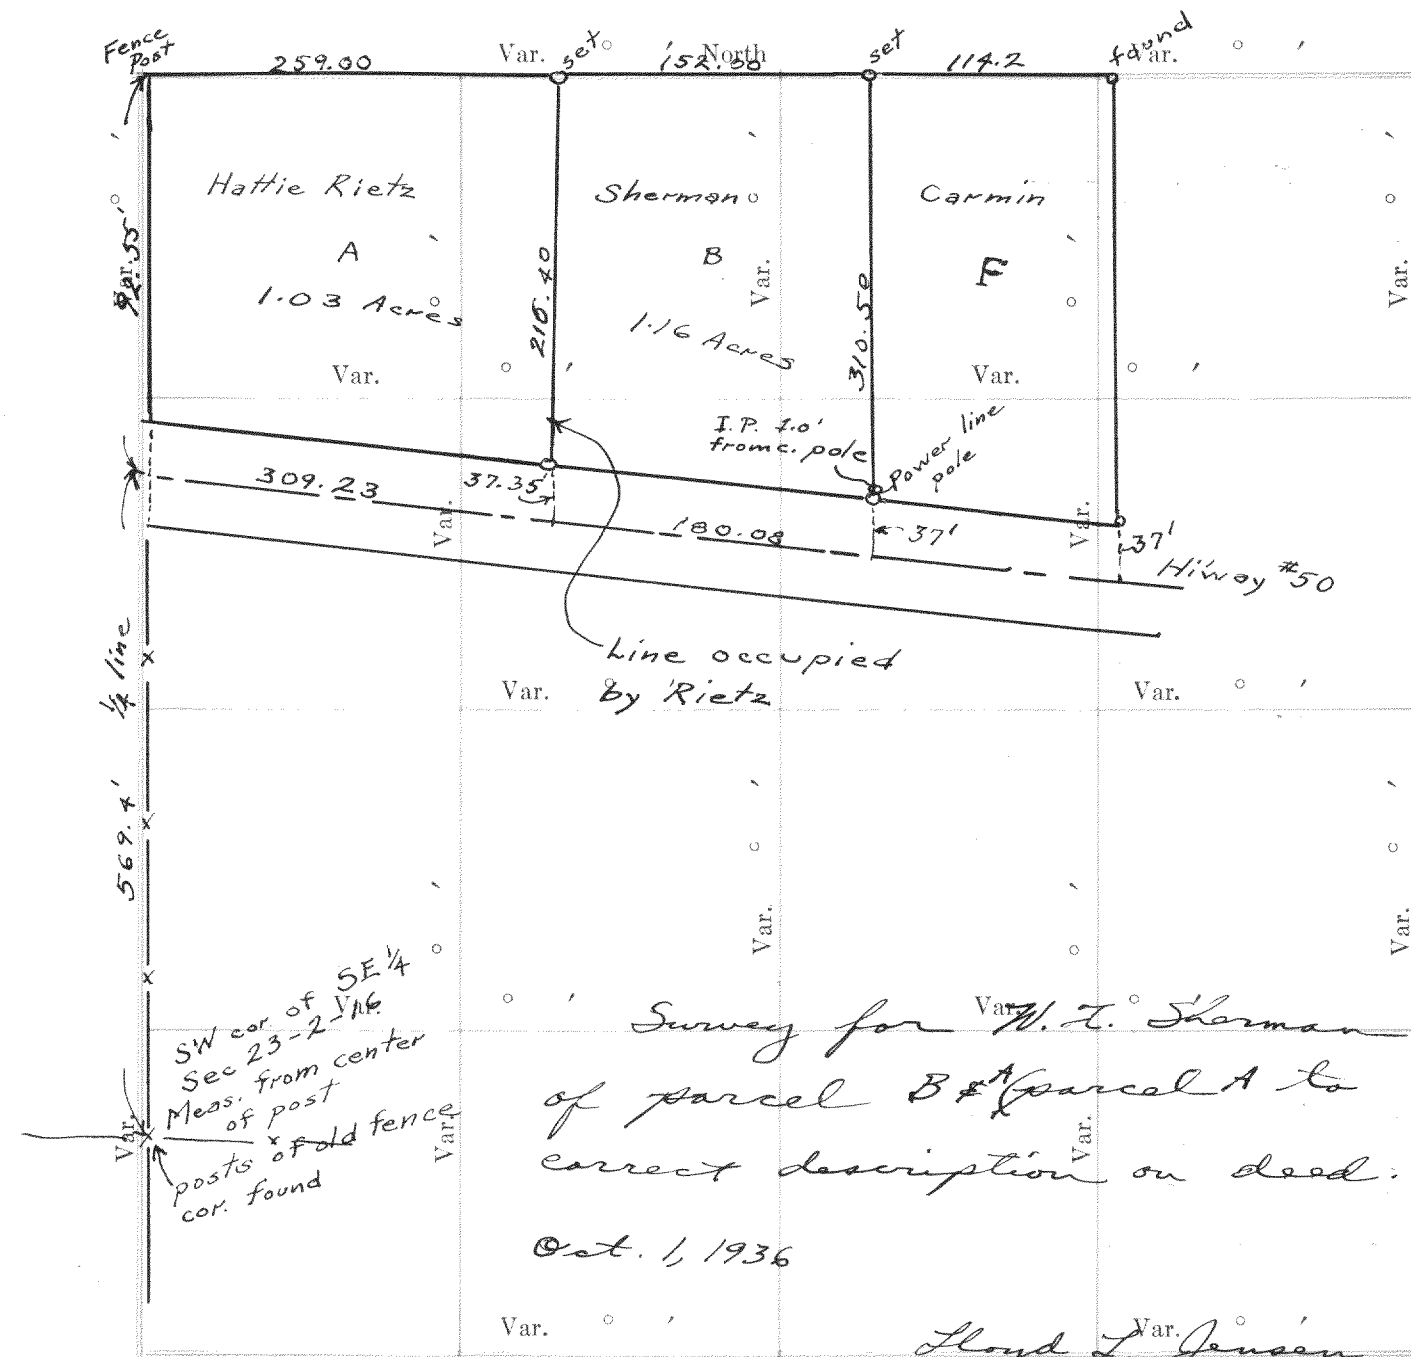

Plat of Section....., Township..... North, Range..... of *County of Surveyors* Principal Meridian State
 80 chains to 6 inches. The figures in red ink are the lengths of the lines as stated in the field-notes of the
 Government survey.

Declination of the Magnetic Meridian from the True Meridian.....

Surveyed and sub-divided.....A. D. 1 , in accordance
with the State Laws and Instructions of the Commissioner of the General Land office, and recorded on pages
.....of Register in the County Clerk's office.

Witness my hand this day of A. D. 1

...SURVEYOR.

DESCRIPTION

237

OF SECTION, QUARTER SECTION AND QUARTER QUARTER SECTION CORNERS

H. C. MILLER CO., MFG. STATIONERS, MILWAUKEE WIS 5000

	Bearing	In.	Courses	Links	Bearing	In.	Courses	Links	Bearing	In.	Courses	Links	Bearing	In.	Courses	Links
	Trees	Dia.	they bear	Distant	Trees	Dia.	they bear	Distant	Trees	Dia.	they bear	Distant	Trees	Dia.	they bear	Distant
No.																
1.	N. W. Sec. Cor. identified,															
2.	N. E. Sec. Cor. identified,															
3.	S. E. Sec. Cor. identified,															
4.	S. W. Sec. Cor. identified,															
5.	N. 1/4 Sec. Cor. identified,															
6.	E. 1/4 Sec. Cor. identified,															
7.	S. 1/4 Sec. Cor. identified,															
8.	W. 1/4 Sec. Cor. identified,															

Subdivision Corners

No.	
1.	Center 1/4 Sec. Cor.
2.	North 1/4-1/4s N. W. qr.,
3.	East 1/4-1/4s N. W. qr.,
4.	South 1/4-1/4s N. W. qr.,
5.	West 1/4-1/4s N. W. qr.,
6.	Center 1/4-1/4s N. W. qr.,
7.	North 1/4-1/4s N. E. qr.,
8.	East 1/4-1/4s N. E. qr.,
9.	South 1/4-1/4s N. E. qr.,
10.	Center 1/4-1/4s N. E. qr.,
11.	East 1/4-1/4s S. E. qr.,
12.	South 1/4-1/4s S. E. qr.,
13.	West 1/4-1/4s S. E. qr.,
14.	Center 1/4-1/4s S. E. qr.,
15.	South 1/4-1/4s S. W. qr.,
16.	West 1/4-1/4s S. W. qr.,
17.	Center 1/4-1/4s S. W. qr.,

No. 743

N line fence of 520 Acres of SW 1/4 - SE 1/4, Sec 23 & 24 T2N, R16E

Survey of parcels O, P, & Q for W. T. Sherman of East Delaware

Oct. 4, 1936

Nov. " "

Lloyd L. Jensen
County Surveyor
By W. L. H.


NAMES OF SWORN ASSISTANTS

CHAINMEN

FLAGMEN

AXMEN

No. 744

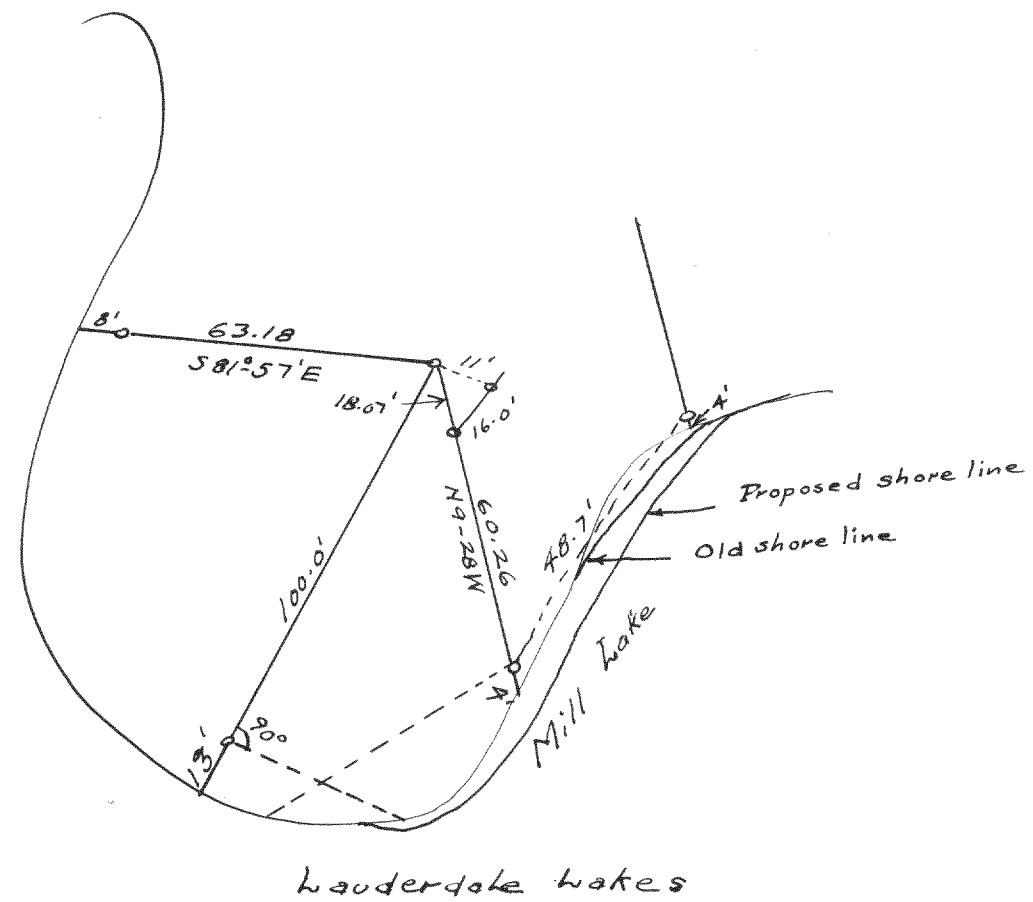


NW 1/4 Sec 36-4-16

Location of shoreline
for W. J. Seymour.

Oct. 1936

Lloyd L. Jensen

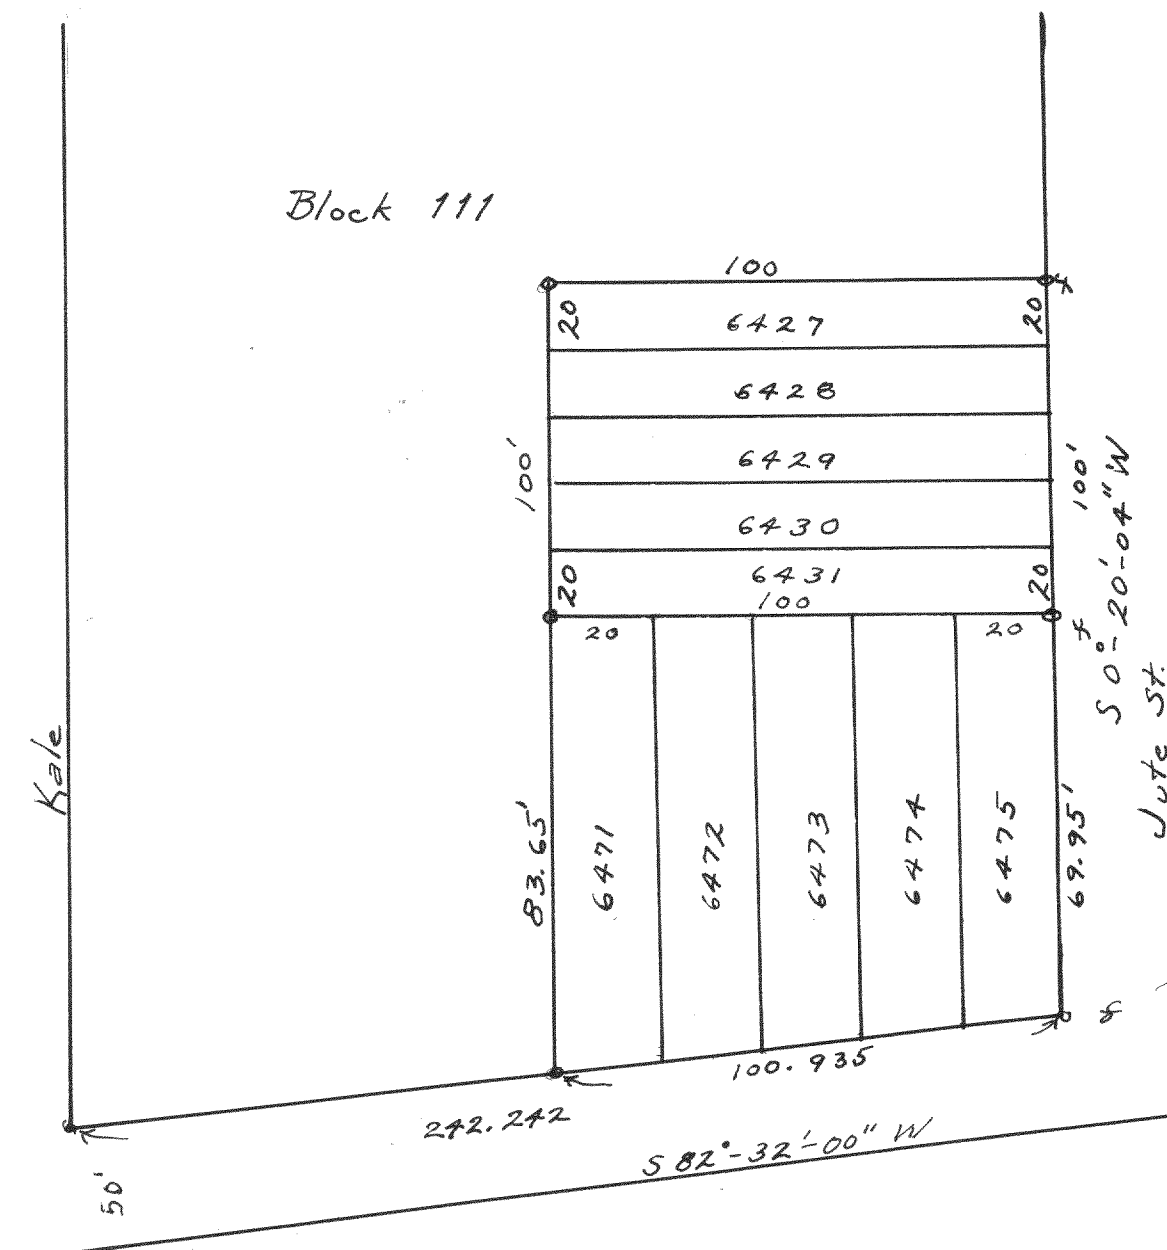

Survey for Mrs. Emma Antonsen
at Lake Como.

Oct. 1936

Lloyd L. Jensen
County Surveyor
By W. E. H.