

Record of Survey.

OF SECTION, QUARTER SECTION AND QUARTER QUARTER SECTION CORNERS

no 55

Survey on South Shore of Booth Lake


Township.....North of Range.....of 4 Principal Meridian

as presented by the courses and distances on the following plat, and annexed field-notes of survey:

Established the center of the section at the point of intersection of STRAIGHT quarter lines.

Established all quarter-quarter corners upon the section boundary at proportional distances between known section and quarter section corners, according to the original field-notes of the Government survey.

Established all lost corners at proportionate distances between known corners, according to the original field notes of the Government survey.

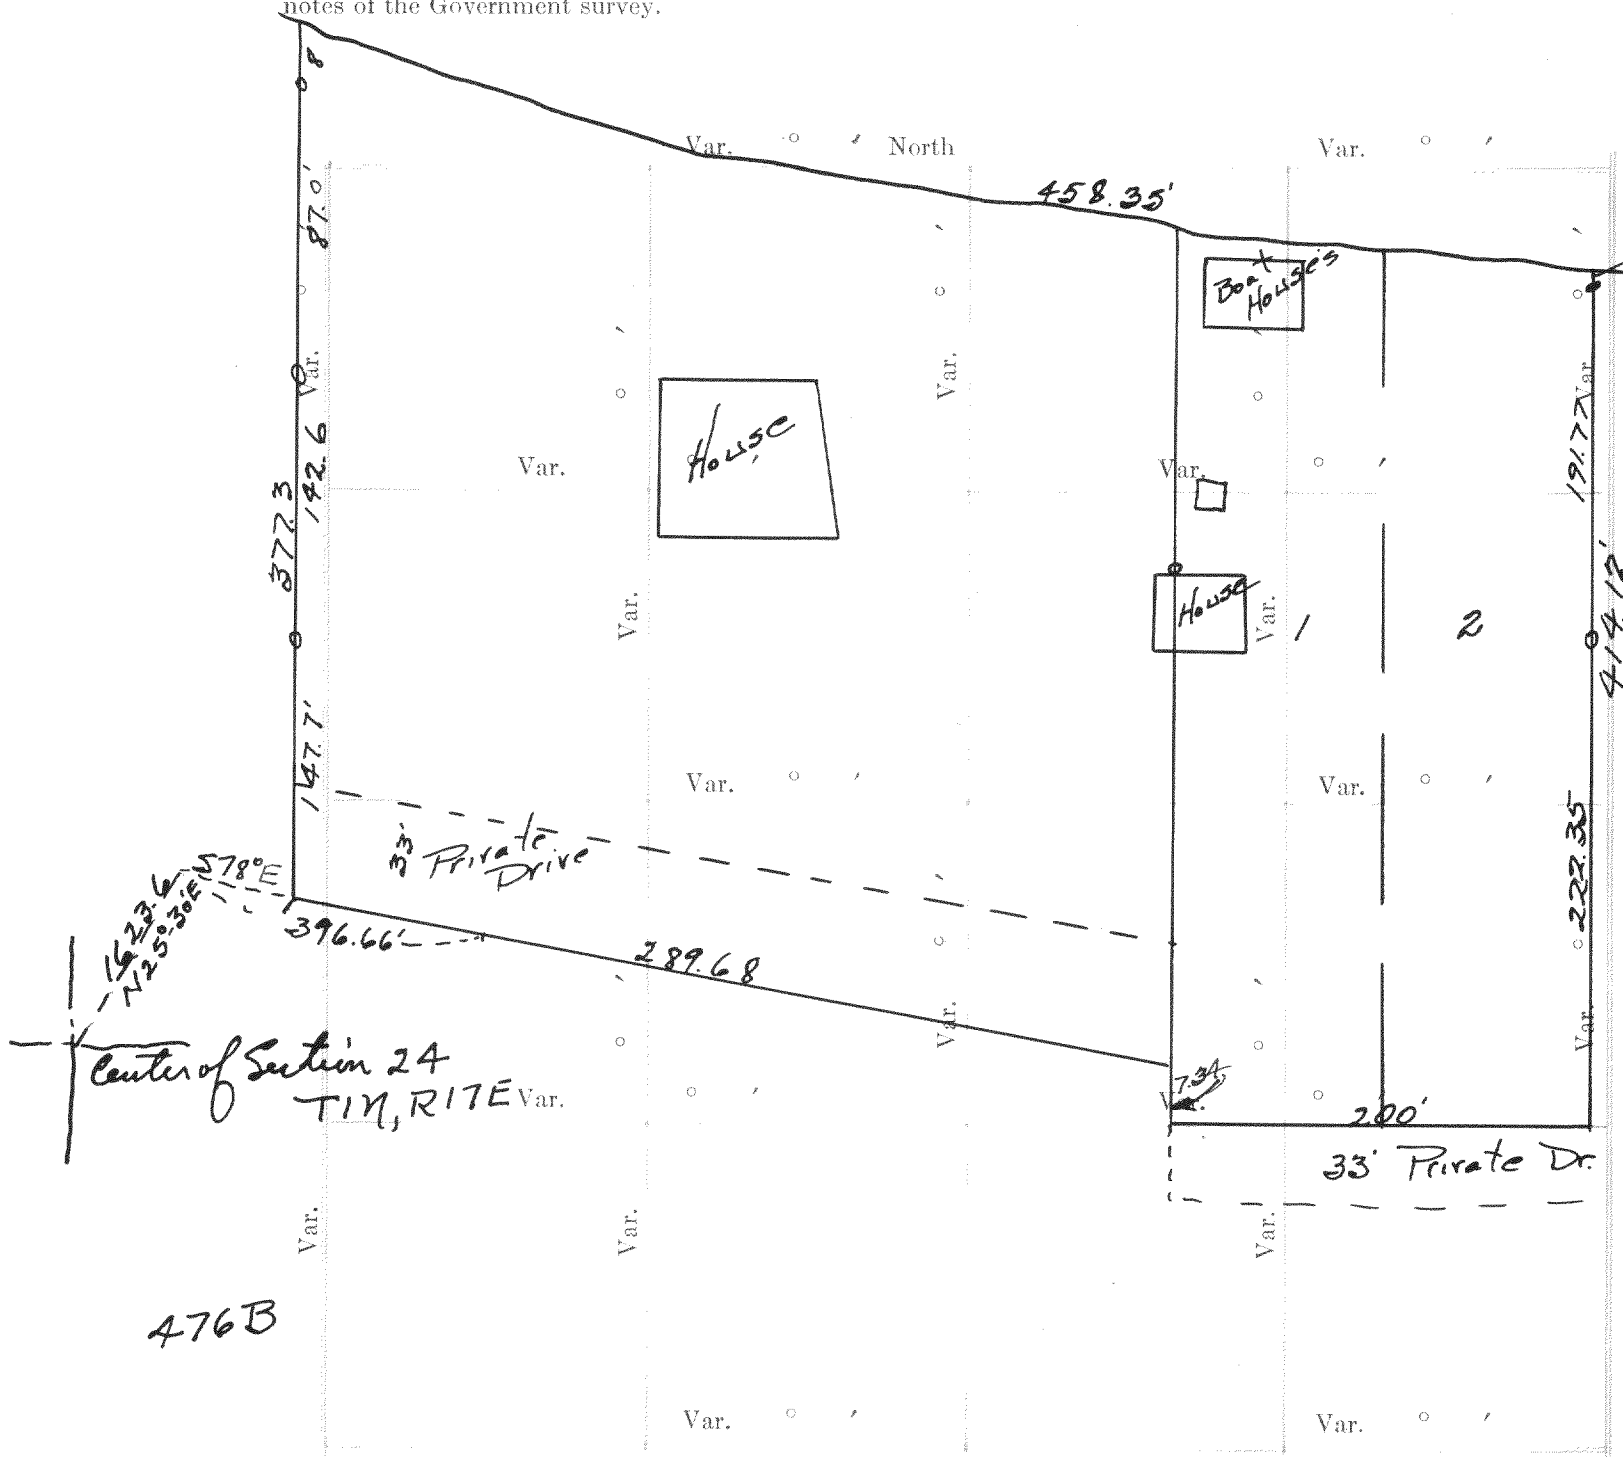

476B

Plat of Section....., Township.....North, Range.....of 4 Principal Meridian Scale

80 chains to 6 inches. The figures in red ink are the lengths of the lines as stated in the field-notes of the Government survey.

Declination of the Magnetic Meridian from the True Meridian.....

Surveyed and sub-divided.....A. D. 1....., in accordance

with the State Laws and Instructions of the Commissioner of the General Land office, and recorded on pages

.....of Register in the County Clerk's office.

Witness my hand this.....day of.....A. D. 1

.....SURVEYOR.

GOVERNMENT CORNERS

- No.
1. N. W. Sec. Cor. identified,
 2. N. E. Sec. Cor. identified,
 3. S. E. Sec. Cor. identified,
 4. S. W. Sec. Cor. identified,
 5. N. $\frac{1}{4}$ Sec. Cor. identified,
 6. E. $\frac{1}{4}$ Sec. Cor. identified,
 7. S. $\frac{1}{4}$ Sec. Cor. identified,
 8. W. $\frac{1}{4}$ Sec. Cor. identified,

Subdivision Corners

- No.
1. Center $\frac{1}{4}$ Sec. Cor.
 2. North $\frac{1}{4}$ - $\frac{1}{4}$ s N. W. qr.,
 3. East $\frac{1}{4}$ - $\frac{1}{4}$ s N. W. qr.,
 4. South $\frac{1}{4}$ - $\frac{1}{4}$ s N. W. qr.,
 5. West $\frac{1}{4}$ - $\frac{1}{4}$ s N. W. qr.,
 6. Center $\frac{1}{4}$ - $\frac{1}{4}$ s N. W. qr.,
 7. North $\frac{1}{4}$ - $\frac{1}{4}$ s N. E. qr.,
 8. East $\frac{1}{4}$ - $\frac{1}{4}$ s N. E. qr.,
 9. South $\frac{1}{4}$ - $\frac{1}{4}$ s N. E. qr.,
 10. Center $\frac{1}{4}$ - $\frac{1}{4}$ s N. E. qr.,
 11. East $\frac{1}{4}$ - $\frac{1}{4}$ s S. E. qr.,
 12. South $\frac{1}{4}$ - $\frac{1}{4}$ s S. E. qr.,
 13. West $\frac{1}{4}$ - $\frac{1}{4}$ s S. E. qr.,
 14. Center $\frac{1}{4}$ - $\frac{1}{4}$ s S. E. qr.,
 15. South $\frac{1}{4}$ - $\frac{1}{4}$ s S. W. qr.,
 16. West $\frac{1}{4}$ - $\frac{1}{4}$ s S. W. qr.,
 17. Center $\frac{1}{4}$ - $\frac{1}{4}$ s S. W. qr.

Bearing	In.	Courses	Links	Bearing	In.	Courses	Links	Bearing	In.	Courses	Links	Bearing	In.	Courses	Links
Trees	Dia.	they bear	Distant	Trees	Dia.	they bear	Distant	Trees	Dia.	they bear	Distant	Trees	Dia.	they bear	Distant

I hereby certify that on the 28th day of Aug. 1933 I completed a survey of land as shown on survey plat 476B, the description of which is as follows:
Parcel No I, Commencing at the center of Section 24, T4N, R17E thence N 25° 30' E 1623.6 feet; thence S 78° 00' E 341.66 feet to the place of beginning; thence S 78° 00' E 289.68' to a point 7.34 feet north of the SW. Cor. of lot I of Hultquist's Subd. as recorded in and for Wal. Co. Wis.; thence N. on the N. line of said lot I to the shore of Booth Lake; thence northeasterly along the shore of Booth Lake 258.35' to a pt. thence southerly 377.3' to the place of beginning.
Parcel No II Lots I & II of Hultquist's Subd. as recorded in and for Walworth Co. Wisconsin


Lloyd J. Jensen
County Surveyor

NAMES OF SWORN ASSISTANTS

CHAINMEN

FLAGMEN

AXMEN

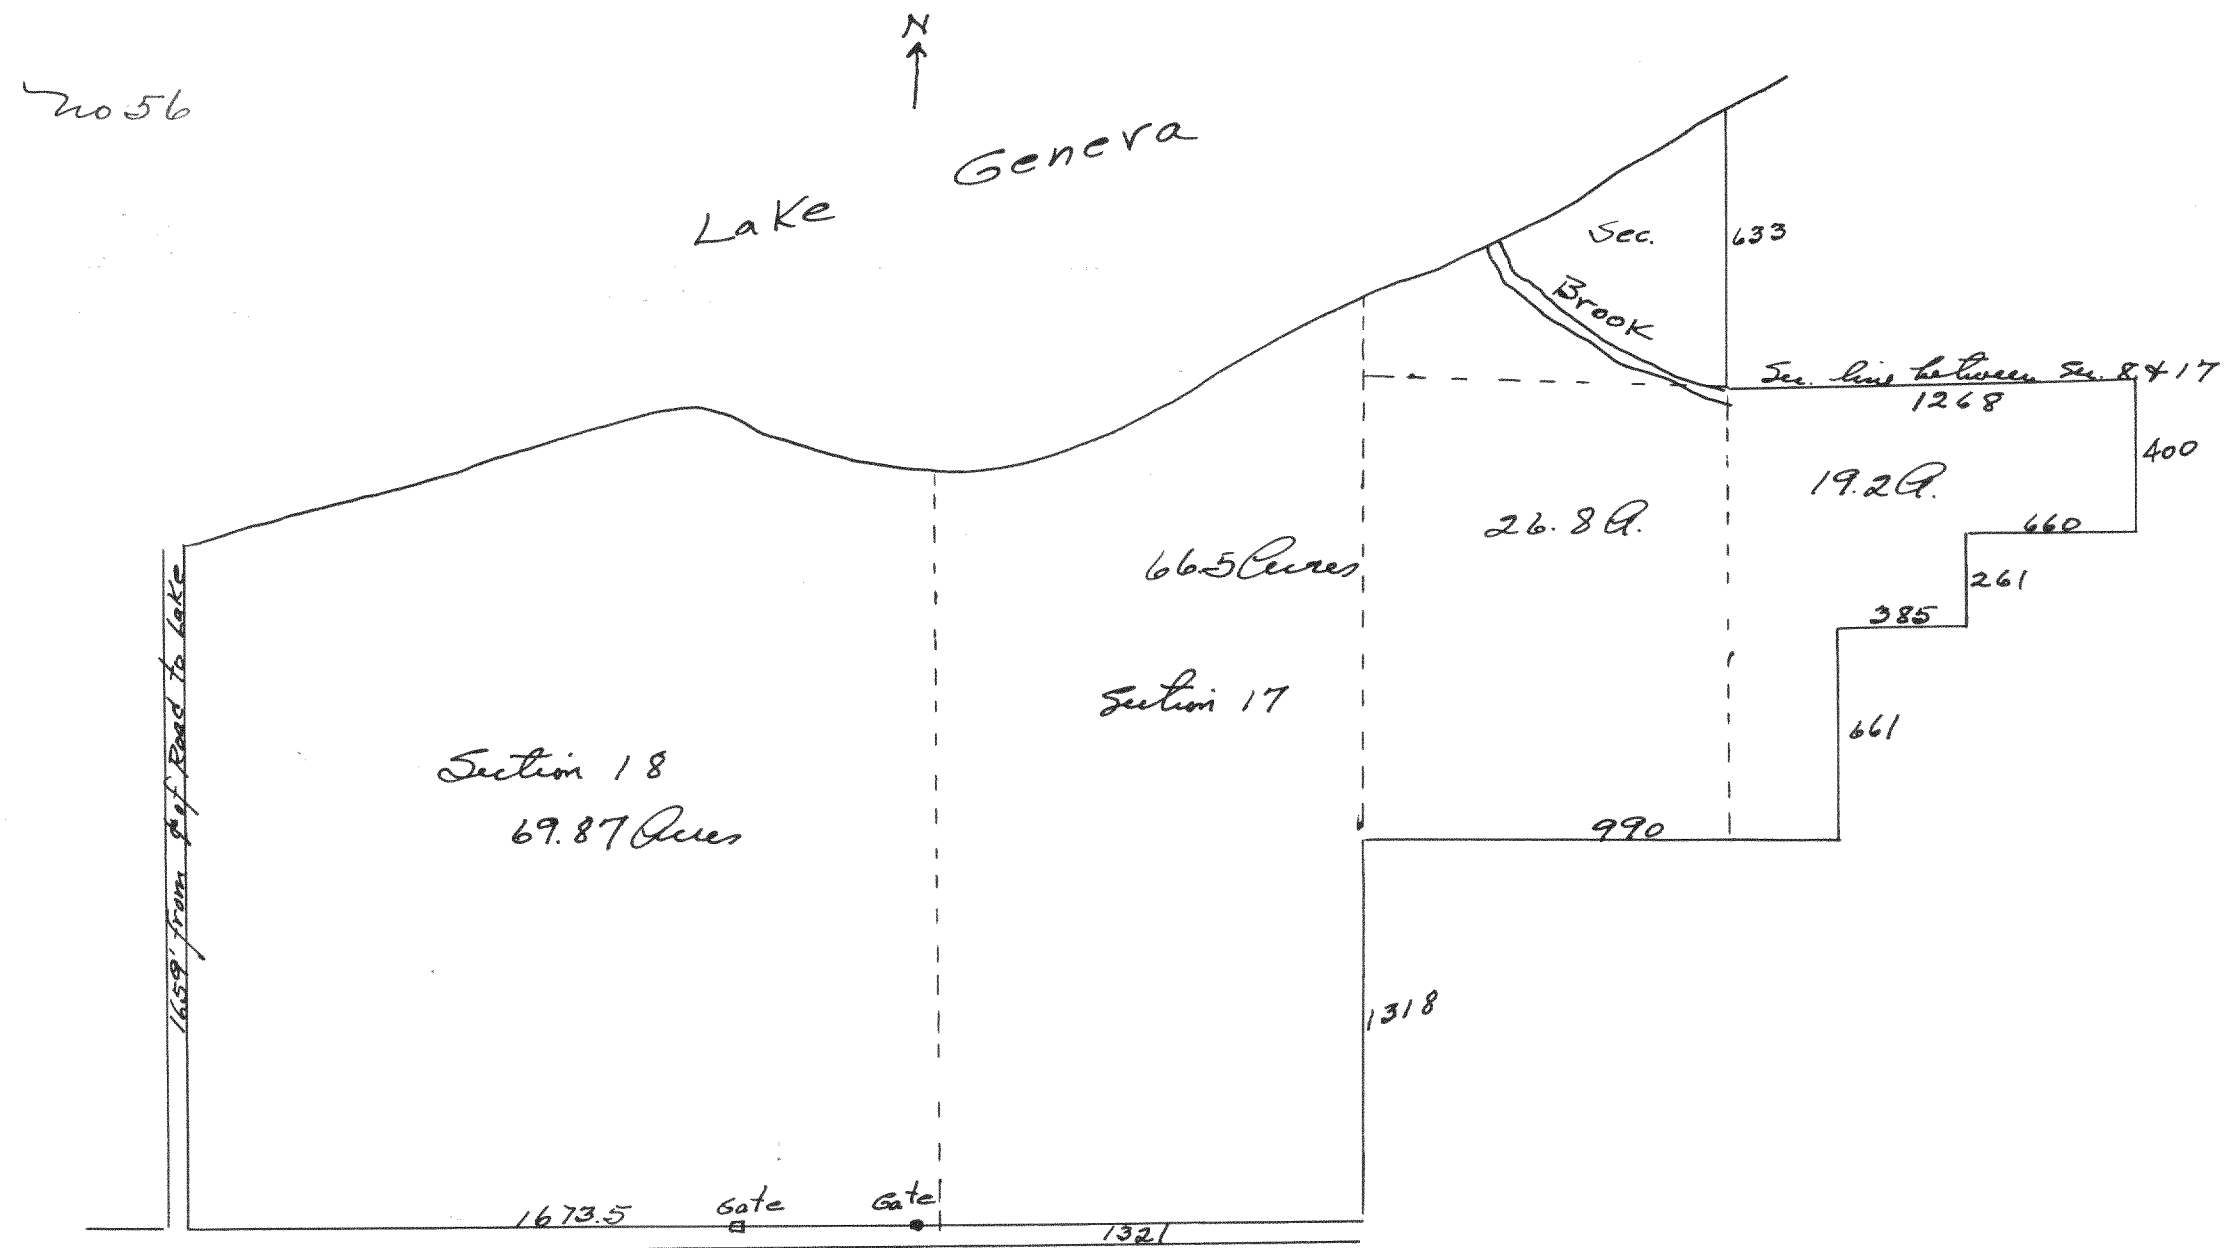

Plot of Land

Surveyed for the Arthur Hays Estate on Sections 8, 17 & 18 in T1N, R17E
in Town of Linn, Walworth County, Wis. This plat is a correct
representation of said plat of land as fenced, & said plat
contains 182.4 Acres. The length of the lines is given in feet.
The center of the road as fenced was taken as the line of plat.
Scale 200' = 1" Wm Child

Wm Child,

County Surveyor
Walworth Co., Wisconsin

Elkhart, June 28, 1902