



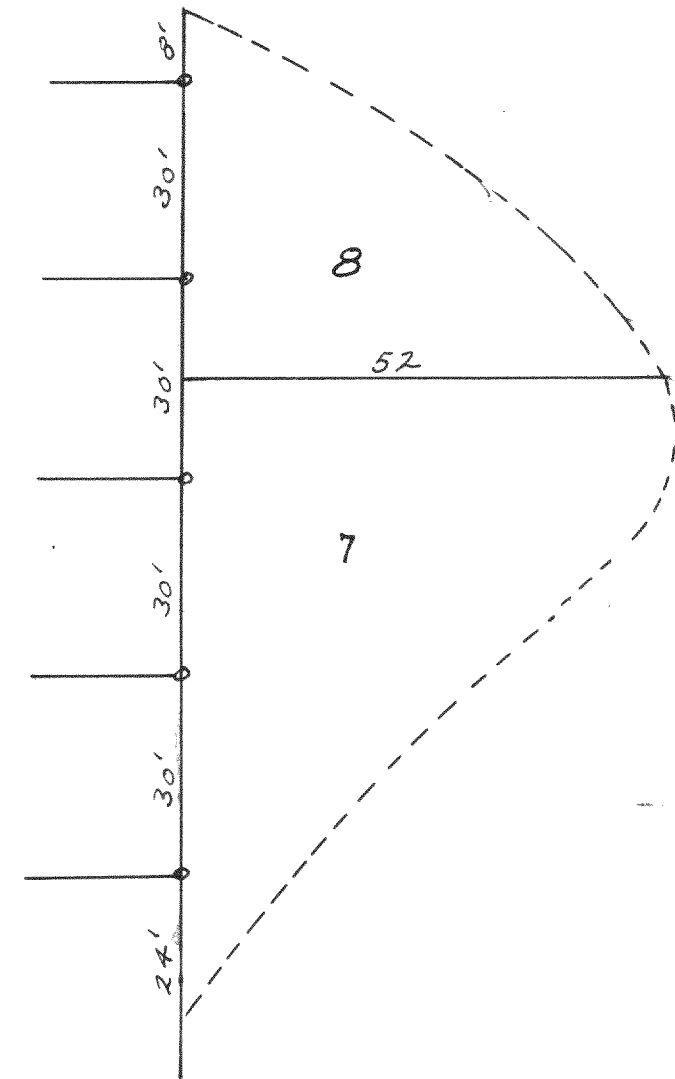

Lots 7 & 8 of Block L of
Assembly Grounds.

Sept. 5, 1936

Lloyd L. Jensen
County Surveyor
By W. E. H.

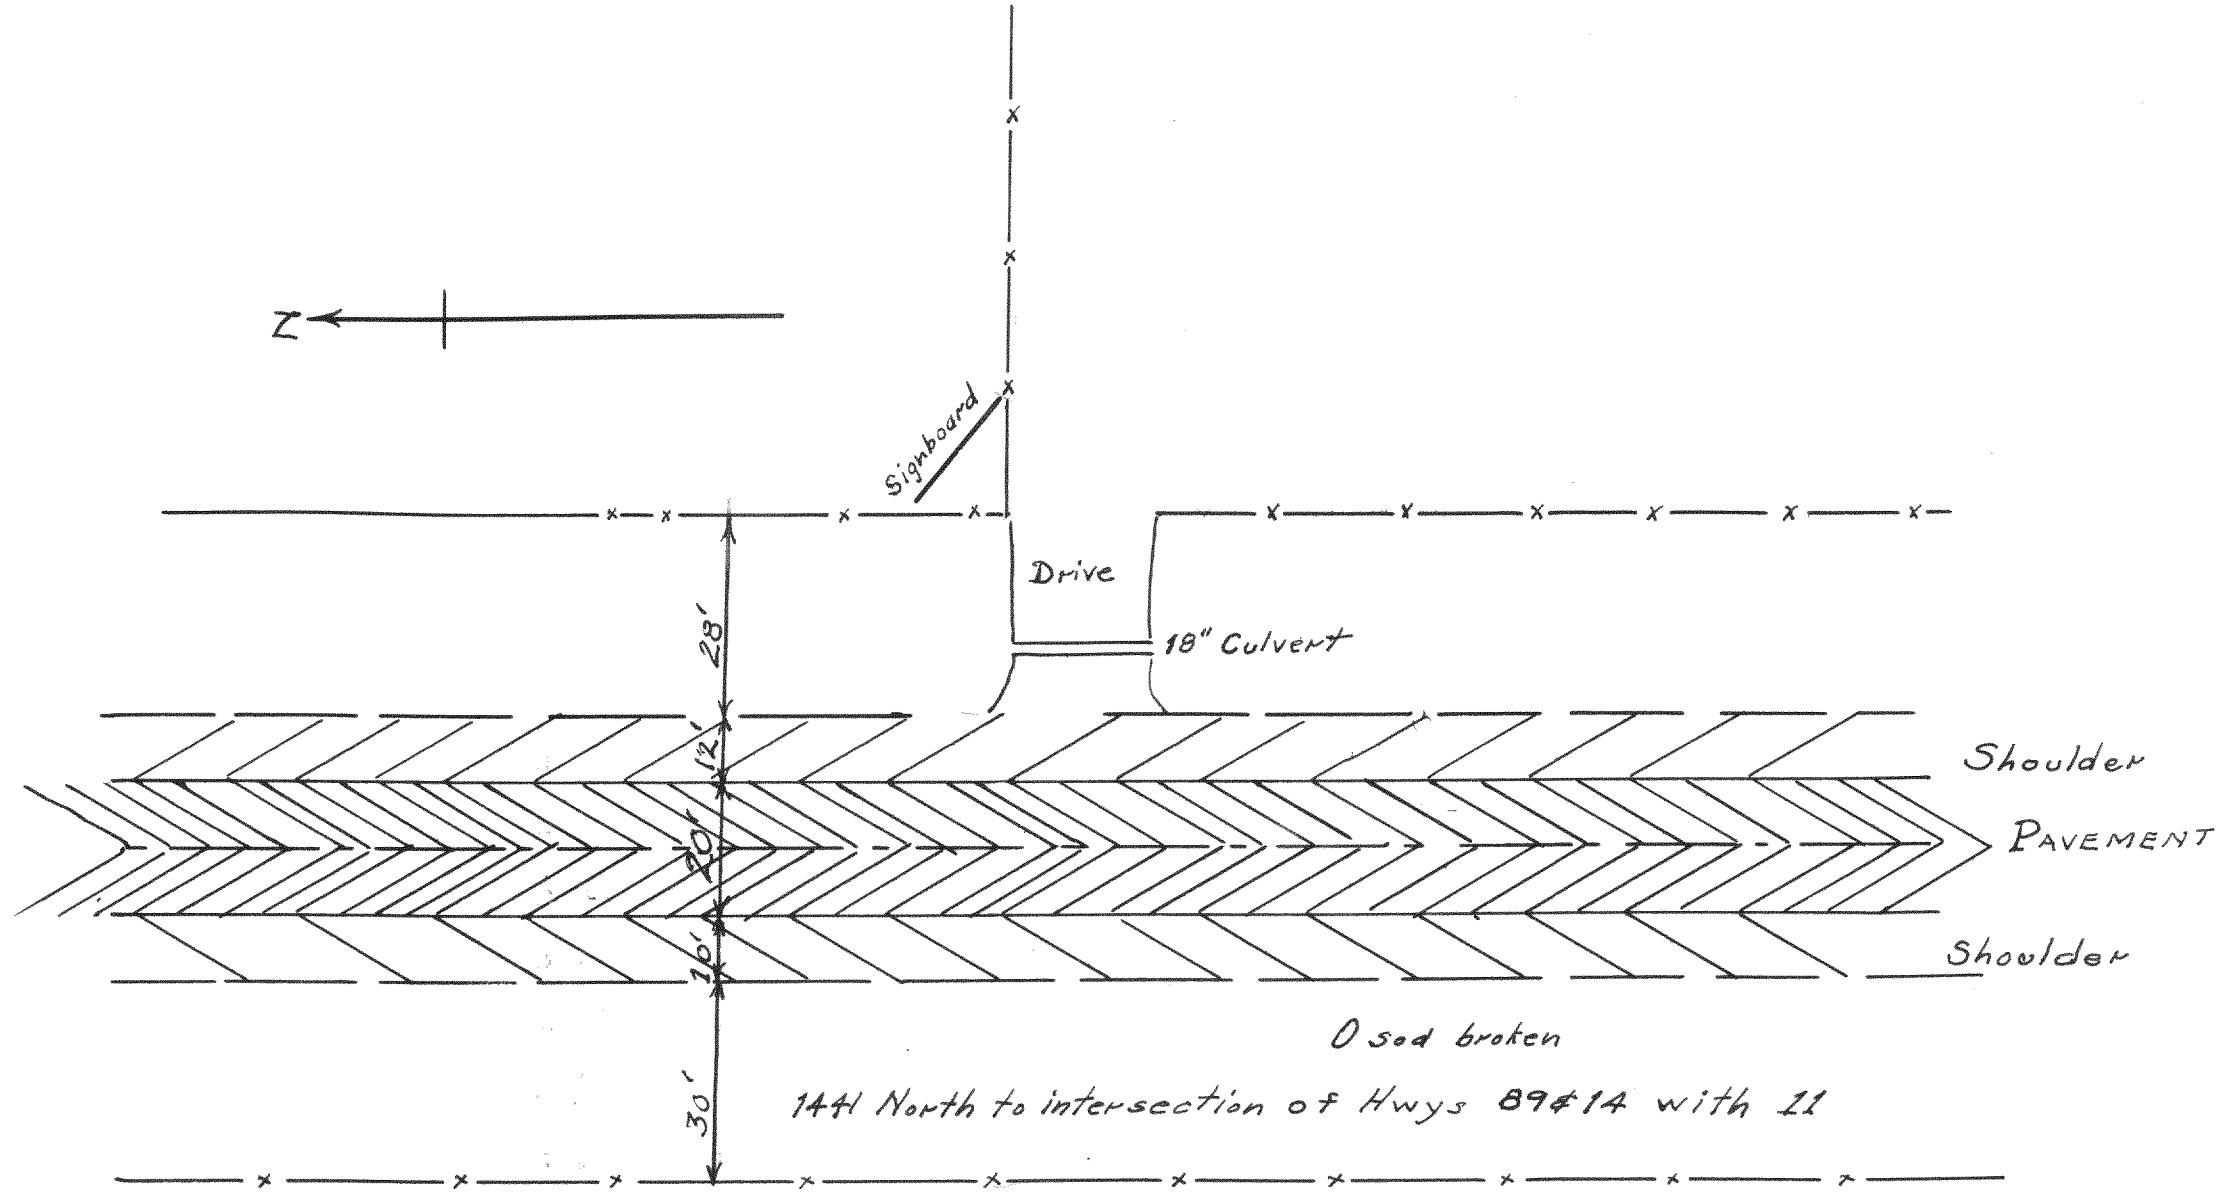

Plot of an accident survey in Section 8-2-15.
Sept. 1936

Lloyd L. Jensen
County Surveyor
By W. E. H.

Record of Survey.


Township....., North of Range.....of 4 Principal Meridian
as presented by the courses and distances on the following plat, and annexed field-notes of survey:

Established the center of the section at the point of intersection of STRAIGHT quarter lines.

Established all quarter-quarter corners upon the section boundary at proportional distances between known section and quarter section corners, according to the original field-notes of the Government survey.

Established all lost corners at proportionate distances between known corners, according to the original field notes of the Government survey.

No. 772

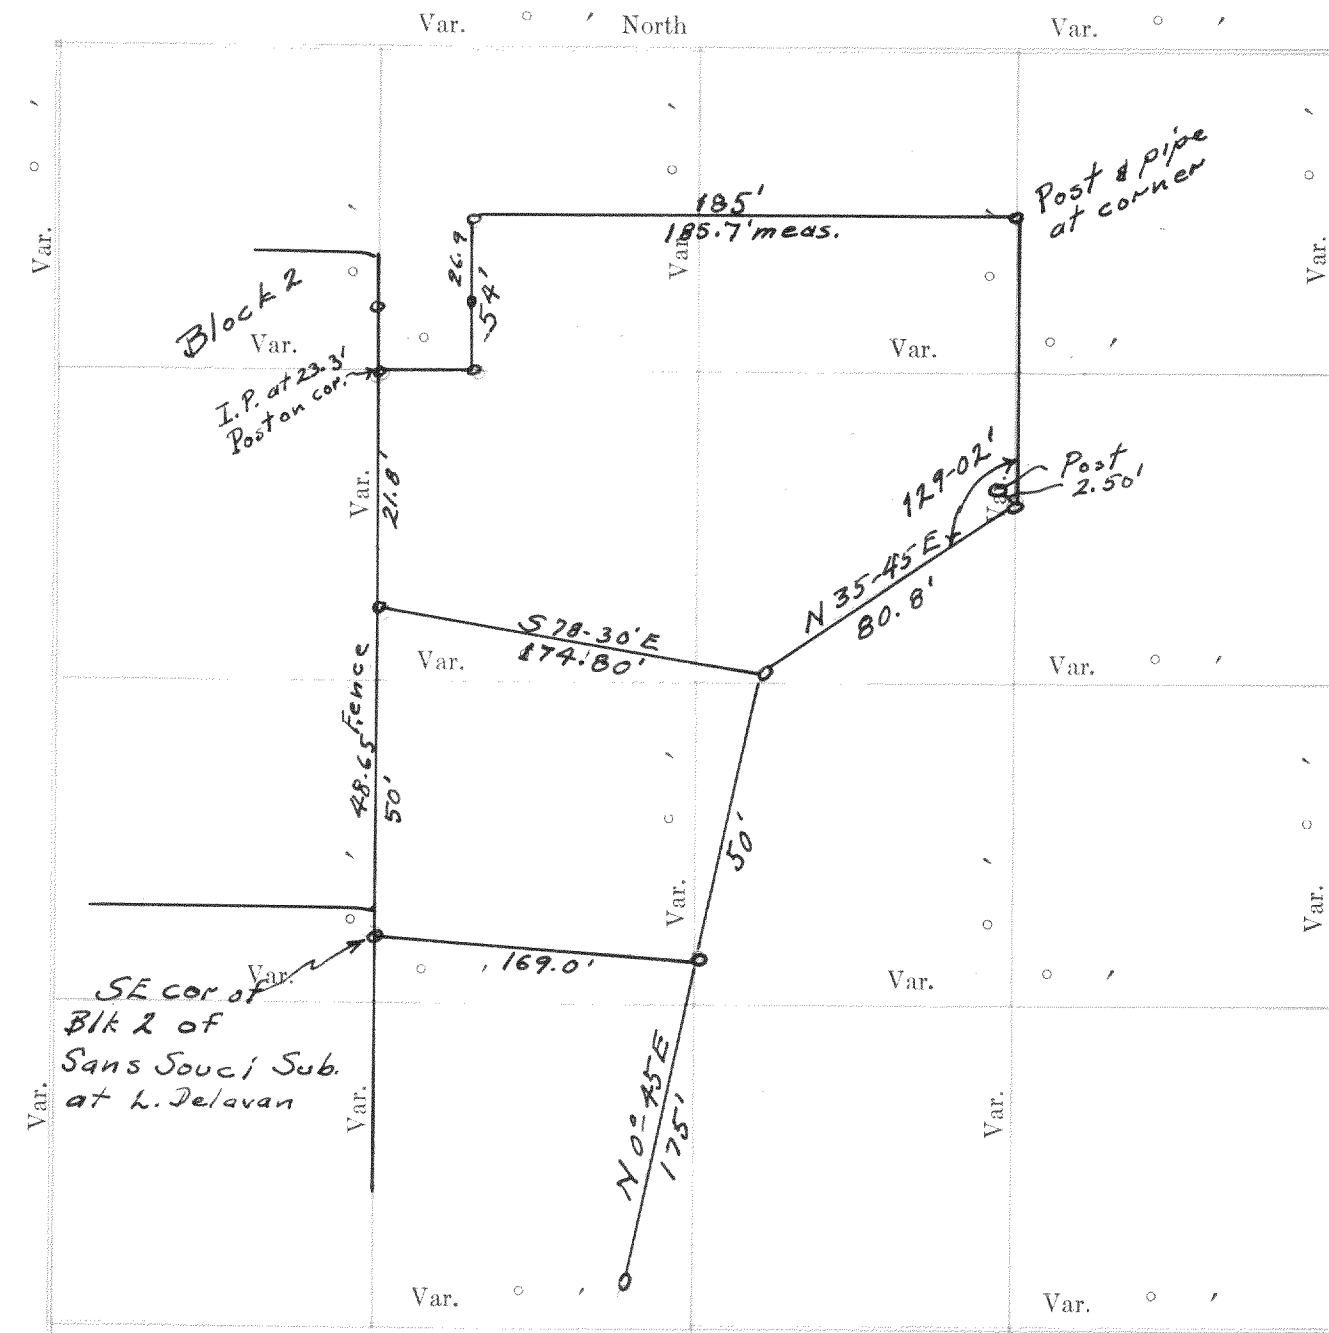

Plat of Section Survey for Al. Blodgett in the SE 1/4
of Sec 22-2-46 Township _____ North, Range _____ of 4 Principal Meridian Scale
80 chains to 6 inches. The figures in red ink are the lengths of the lines as stated in the field-notes of the
Sept. 1936
Government survey.

Declination of the Magnetic Meridian from the True Meridian..... *Lloyd L. Jensen*

Surveyed and sub-divided..... County Surveyor in accordance

with the State Laws and Instructions of the Commissioner of the General Land Office, and recorded on pages of Register in the County Clerk's office.

Witness my hand this.....day of.....A. D. 1

...SURVEYOR.

DESCRIPTION

245

OF SECTION, QUARTER SECTION AND QUARTER QUARTER SECTION CORNERS

[illegible]

Survey of Lot 12 of Block 38 of
Davis Add. to City of Ellhorn.

Lloyd L. Jensen
County Surveyor
By W. E. H.

NAMES OF SWORN ASSISTANTS

CHAINMEN


FLAGMEN

AXMEN

Witness my hand this.....day of.....A. D. 1

245

No. 774

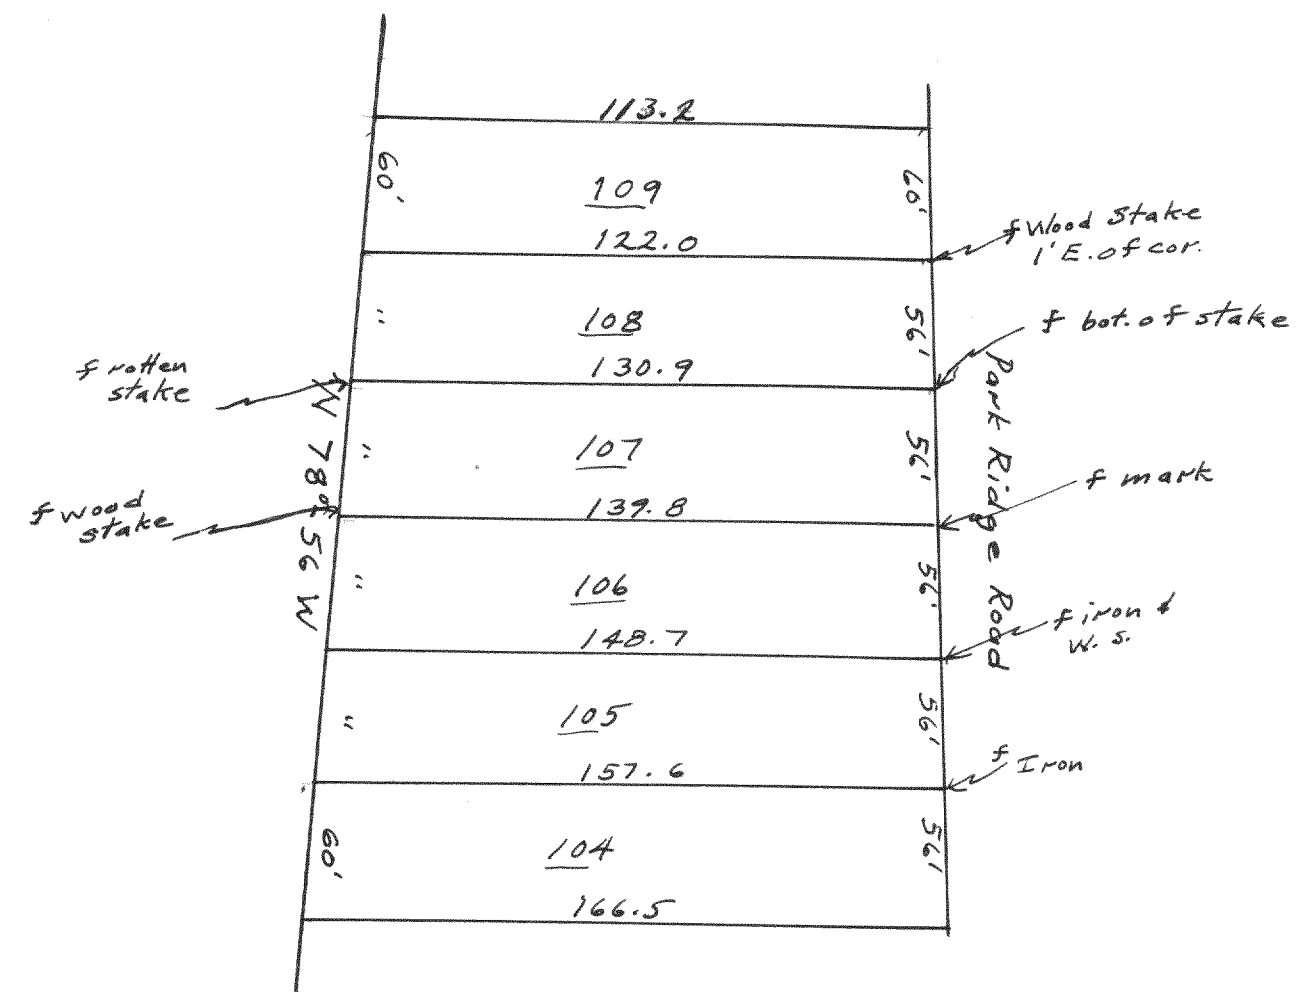


Lot 107 of Cedar Pt. Park

2nd Add.

Nov. 1936

Lloyd L. Jensen
County Surveyor
By W. E. H.

No. 775

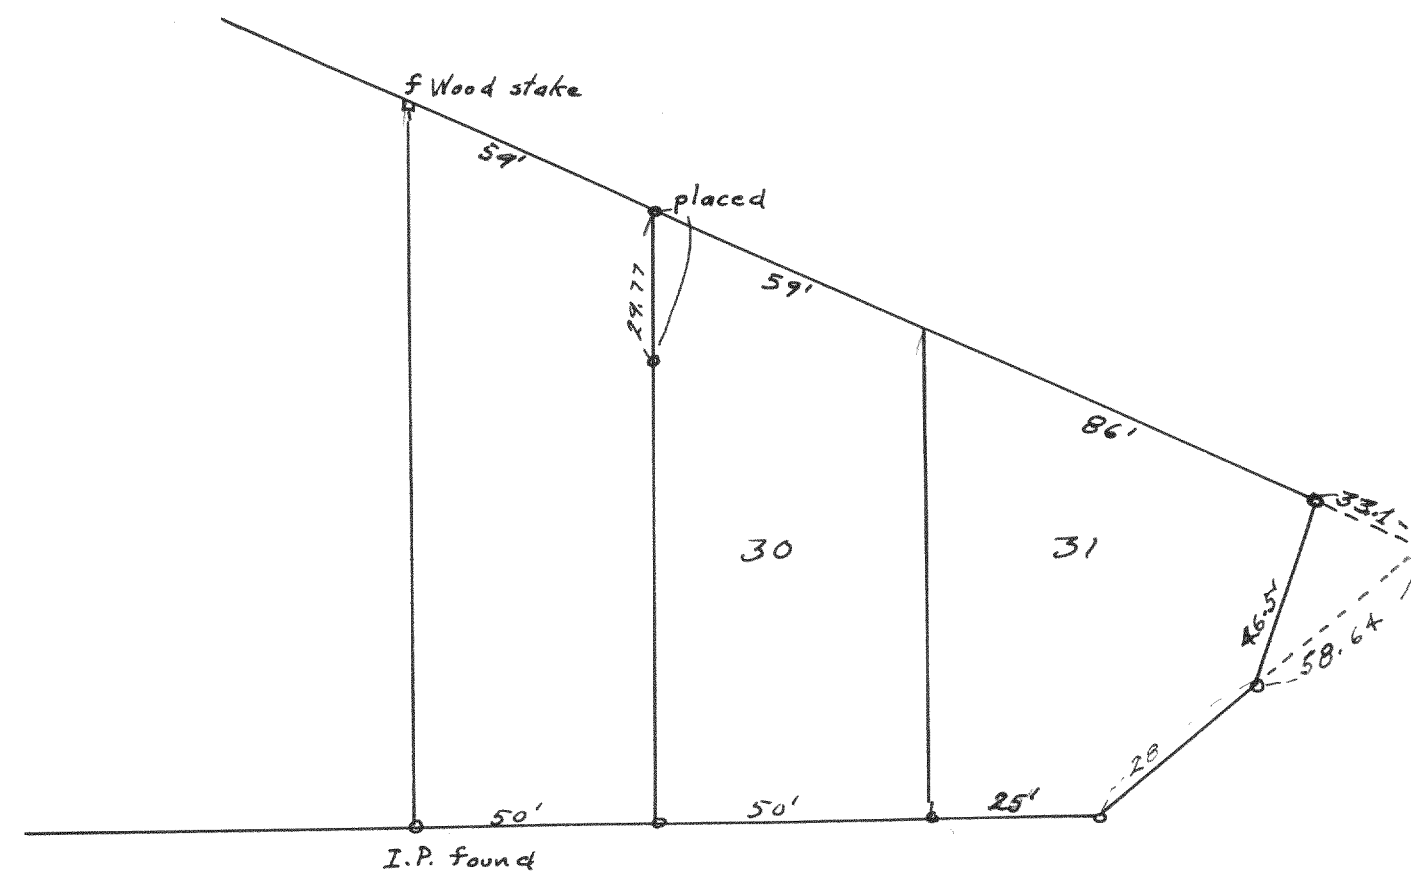

Survey of lots 30 & 31 of Lauderdale Hts
in Sec 36-4-16 for Dr. Freage, Chicago, Ill.
1936

Lloyd L. Jensen
County Surveyor
By W. E. H.