


Established all lost corners at proportionate distances between known corners, according to the original field notes of the Government survey.

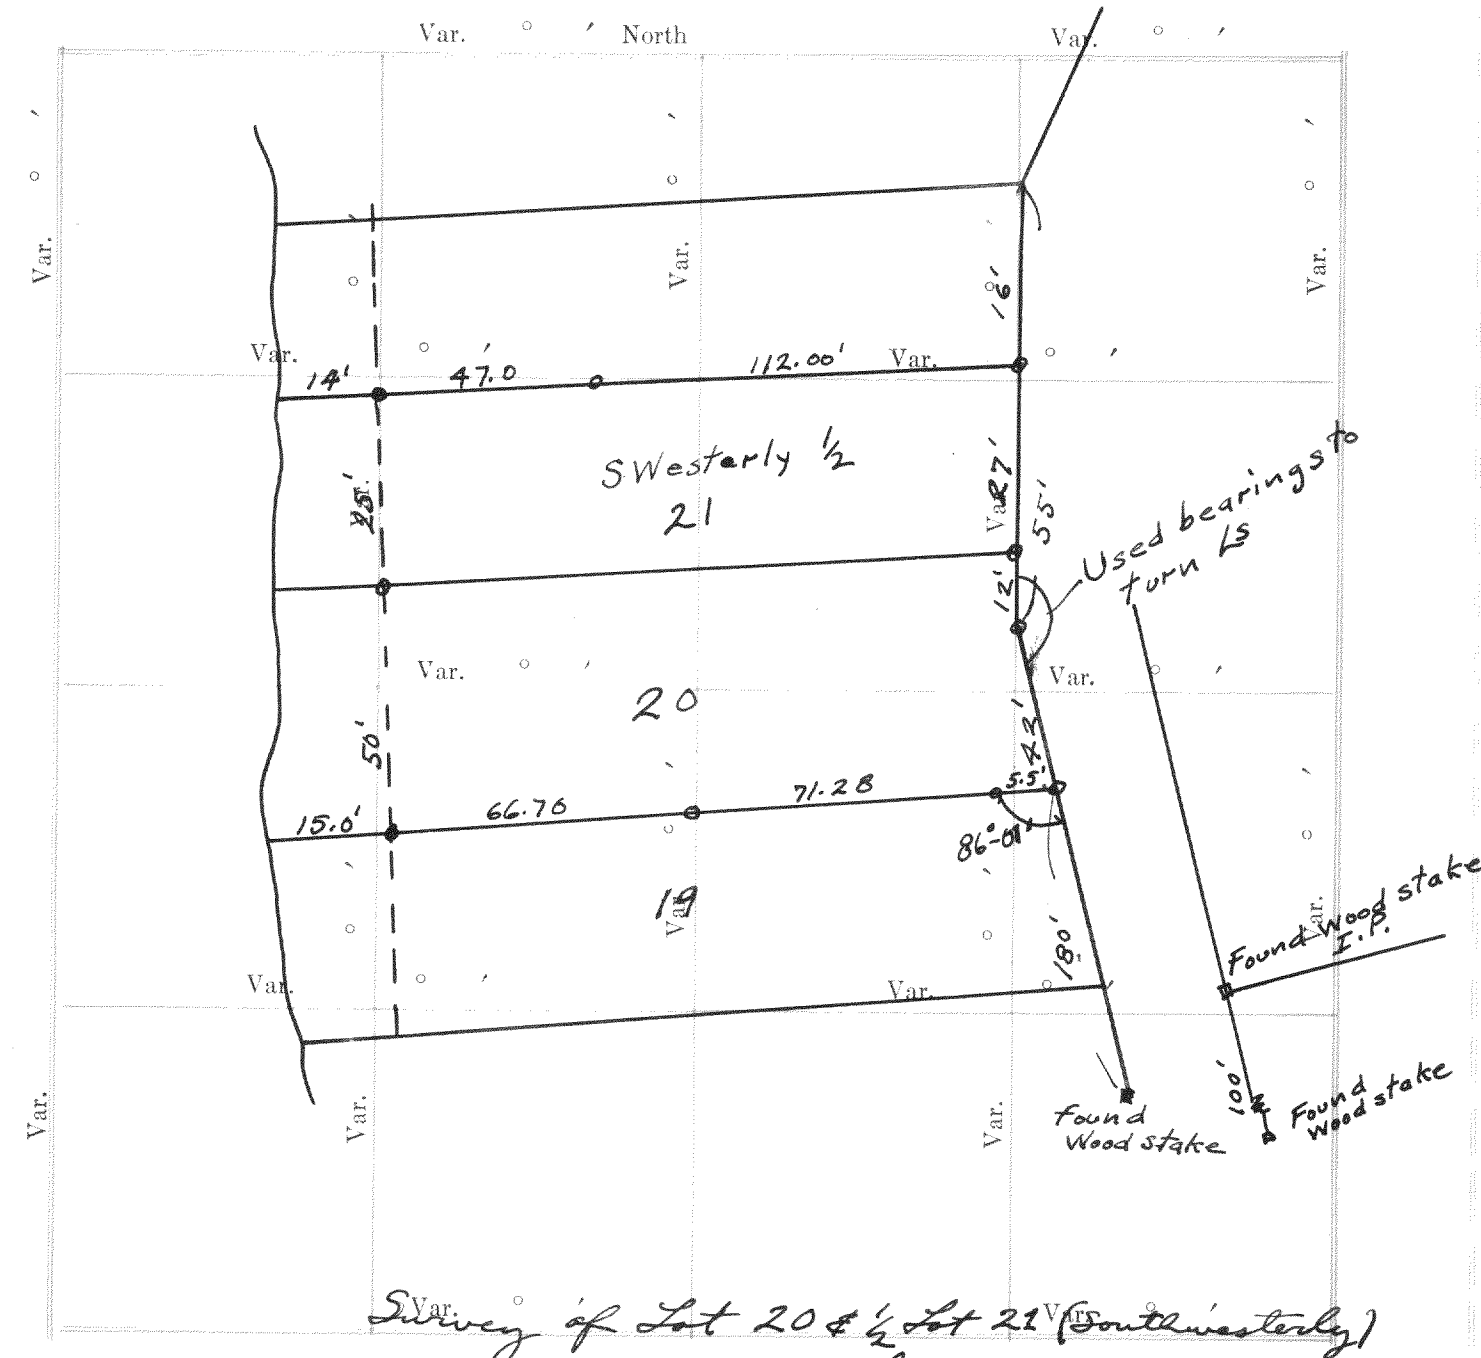

Survey of Lot 20 & 1/2 Lot 21 (Southwestern)
Plat of Section... of the Township... North, Range... of 4 Principal Meridian Scale
80 chains to 6 inches. Sec 25-4-16
The figures in red ink are the lengths of the lines as stated in the field-notes of the
Government survey.
Lloyd L. Jensen

with the State Laws and Instructions of the Commissioner of the General Land office, and recorded on pages of Register in the County Clerk's office.

Witness my hand this.....day of.....A. D. 1.....

SURVEYOR.

248

No. 784

No. 784

GOVERNMENT CORNERS

No.

- N. W. Sec. Cor. identified,
- N. E. Sec. Cor. identified,
- S. E. Sec. Cor. identified,
- S. W. Sec. Cor. identified,
- N. $\frac{1}{4}$ Sec. Cor. identified,
- E. $\frac{1}{4}$ Sec. Cor. identified,
- S. $\frac{1}{4}$ Sec. Cor. identified,
- W. $\frac{1}{4}$ Sec. Cor. identified,

Subdivision Corners

No.

- Center $\frac{1}{4}$ Sec. Cor.
- North $\frac{1}{4}$ - $\frac{1}{4}$ s N. W. qr.,
- East $\frac{1}{4}$ - $\frac{1}{4}$ s N. W. qr.,
- South $\frac{1}{4}$ - $\frac{1}{4}$ s N. W. qr.,
- West $\frac{1}{4}$ - $\frac{1}{4}$ s N. W. qr.,
- Center $\frac{1}{4}$ - $\frac{1}{4}$ s N. W. qr.,
- North $\frac{1}{4}$ - $\frac{1}{4}$ s N. E. qr.,
- East $\frac{1}{4}$ - $\frac{1}{4}$ s N. E. qr.,
- South $\frac{1}{4}$ - $\frac{1}{4}$ s N. E. qr.,
- Center $\frac{1}{4}$ - $\frac{1}{4}$ s N. E. qr.,
- East $\frac{1}{4}$ - $\frac{1}{4}$ s S. E. qr.,
- South $\frac{1}{4}$ - $\frac{1}{4}$ s S. E. qr.,
- West $\frac{1}{4}$ - $\frac{1}{4}$ s S. E. qr.,
- Center $\frac{1}{4}$ - $\frac{1}{4}$ s S. E. qr.,
- South $\frac{1}{4}$ - $\frac{1}{4}$ s S. W. qr.,
- West $\frac{1}{4}$ - $\frac{1}{4}$ s S. W. qr.,
- Center $\frac{1}{4}$ - $\frac{1}{4}$ s S. W. qr.,

The survey map shows a trapezoidal lot with a vertical line on the left representing the government corner line. The subdivision corners are marked along this line and the lot boundaries. The lot is divided into five horizontal sections. The top section is a triangle with a base of 193.5' and a height of 45', with an area of 190'. The next section is a rectangle with a width of 44' and a height of 186', with an area of 43'. The third section is a rectangle with a width of 43' and a height of 184', with an area of 42'. The bottom section is a triangle with a base of 180' and a height of 62.6', with an area of 62.6'. The total area of the lot is 423.7'. The map also shows the location of the I.P. set (Iron Pin set) and Wood s. Found (Wood s. Found) at the corners. The lot is bounded by the 1st Add to Cedar Pt. Park, Village of Williams Bay.

Survey of Lot 43 of 1st Add to Cedar Pt. Park, Village of Williams Bay.

January 18, 1937

Lloyd L. Jensen
County Surveyor
By W. E. H.

Survey of Lot 43 of 1st Add to Cedar Pt.
Park, Village of Williams Bay.

January 18, 1937

Lloyd L. Jensen
County Surveyor
By W. E. H.

NAMES OF SWORN ASSISTANTS

CHAINMEN

FLAGMEN

AXMEN

Northerly portion of a plat of a survey of
part of "the Folly" Subdivision, located in
Section 13-1-17. See page 249

Hoyd L. Jensen
County Surveyor
By W. E. H.

