

No. 811

Survey of road through lots 12-13, 14-11,
15-10 & 16-9 of Stearn and Serould's Subd.
in the village of Montana



Apr. 17, 1937

Lloyd L. Jensen
by K.E.J.



257

No. 812

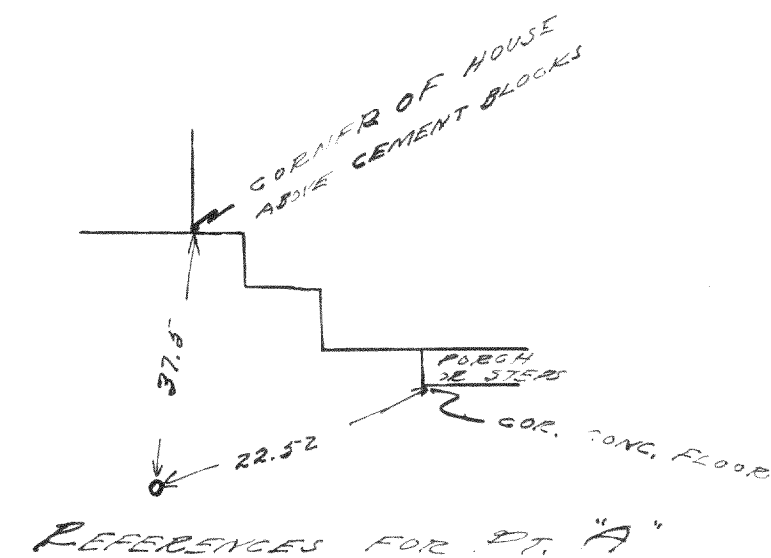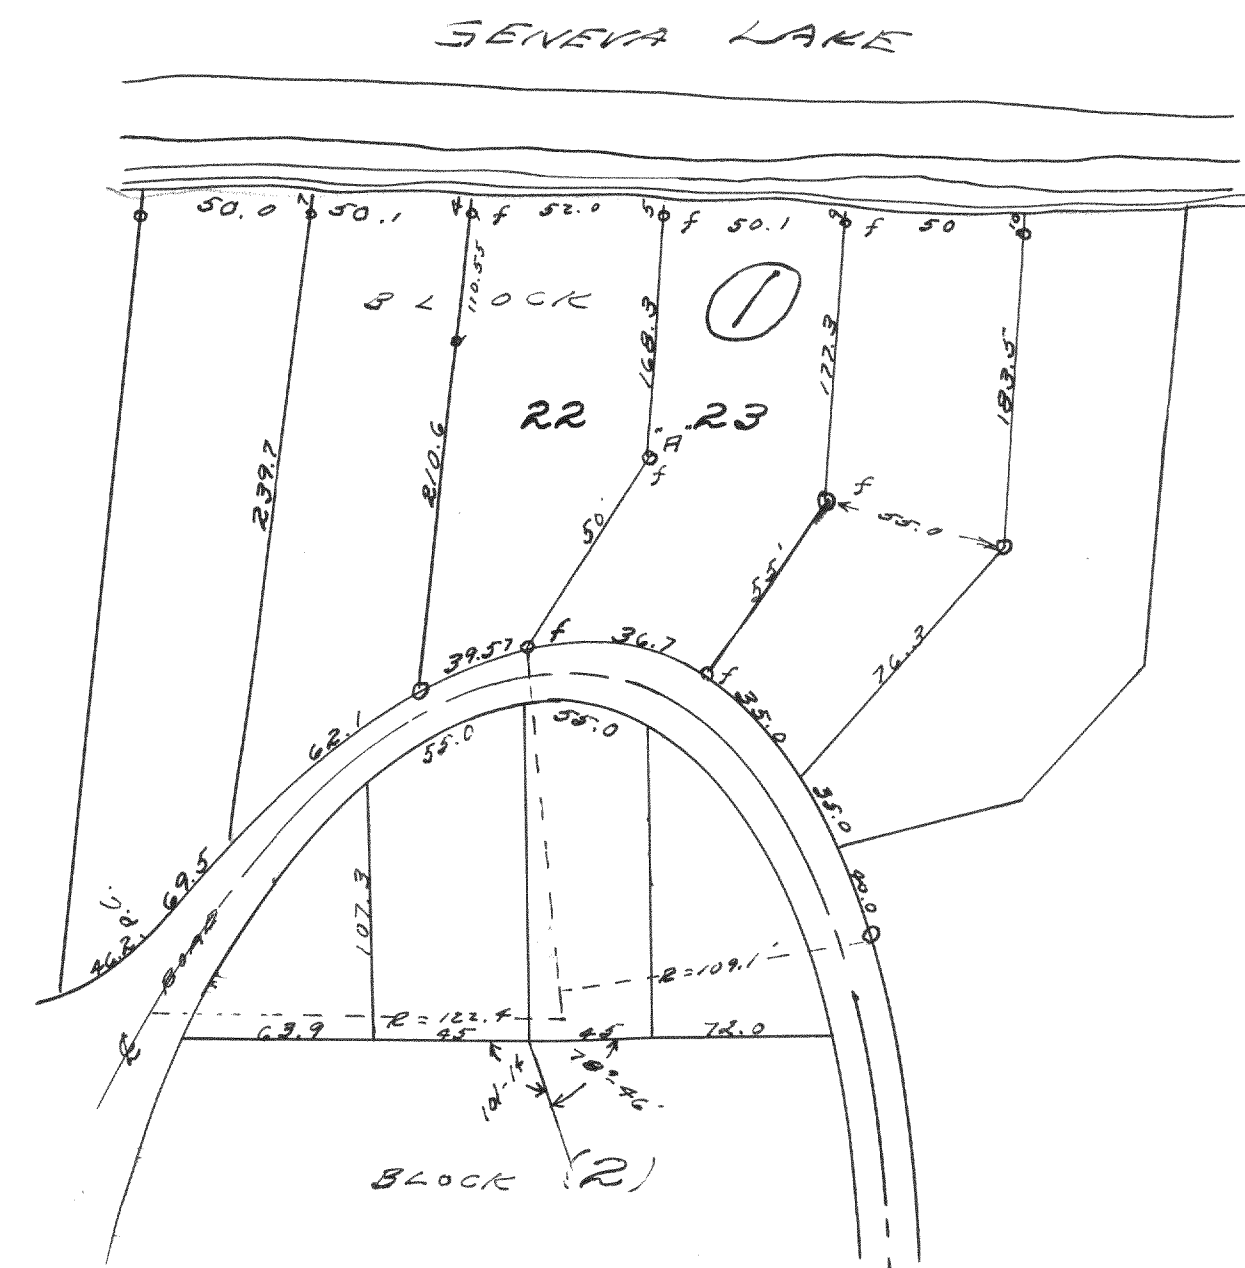

Survey of lots 22 & 23 of block 1 of Indian
Hills Subd.

Lloyd L. Jensen
by K.E.J.