

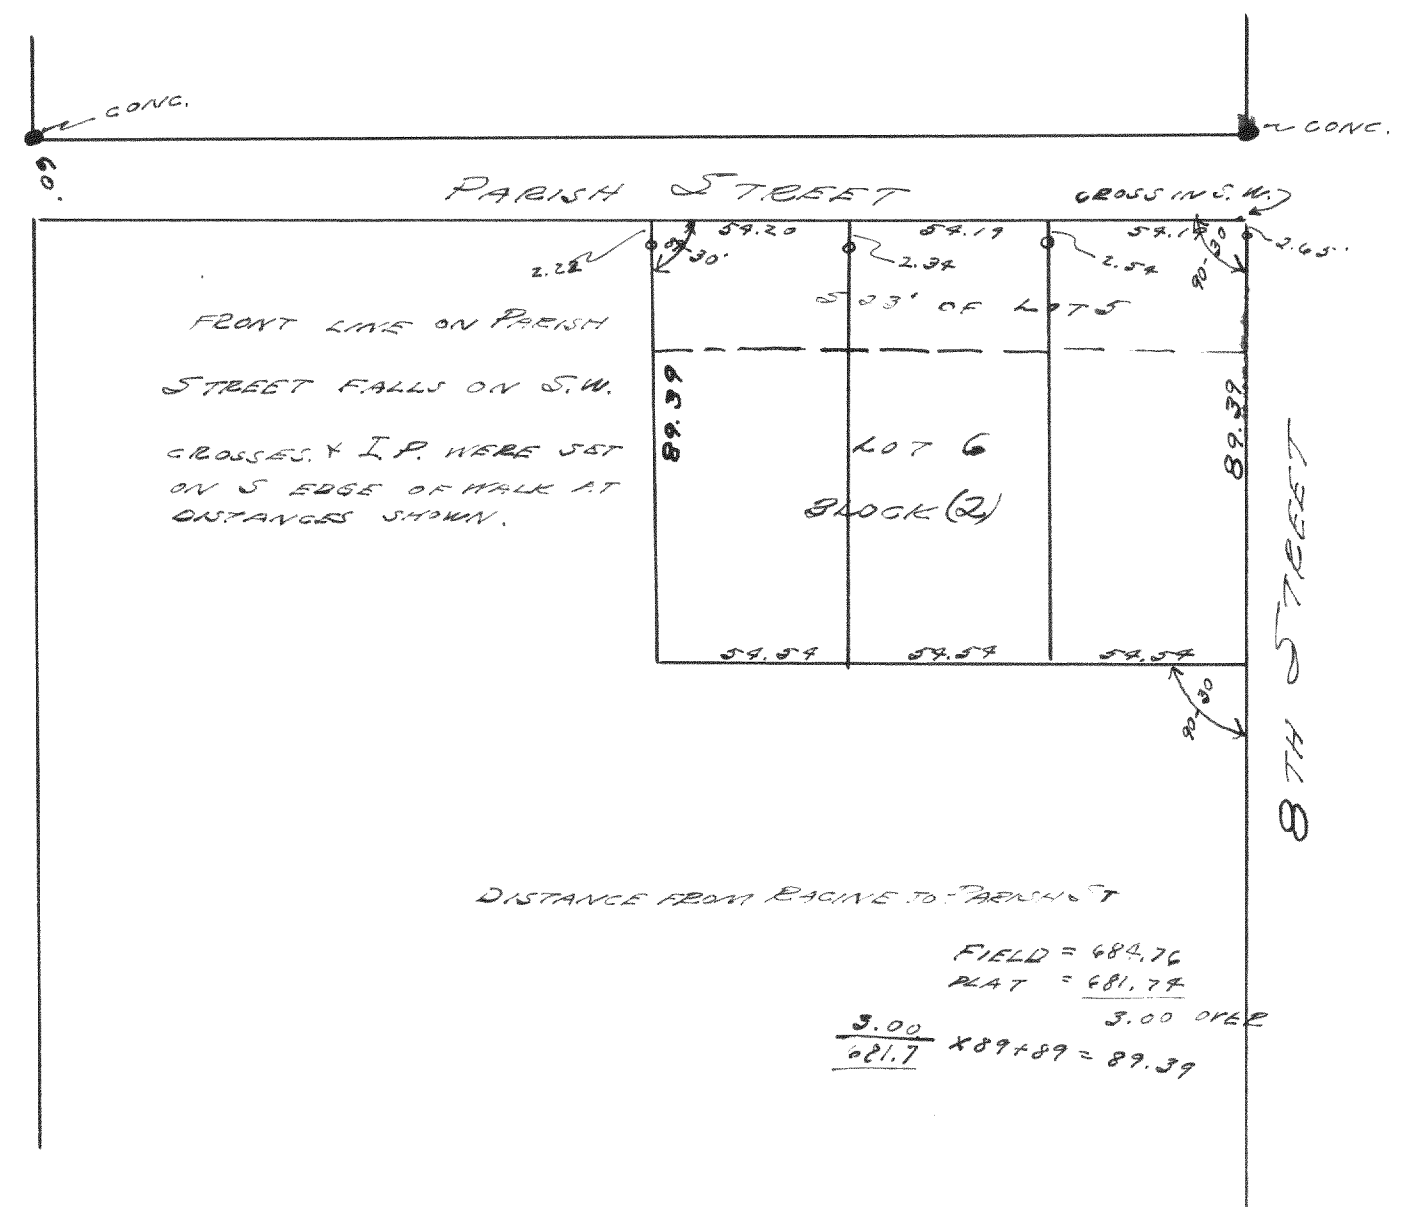


258
NO. 813

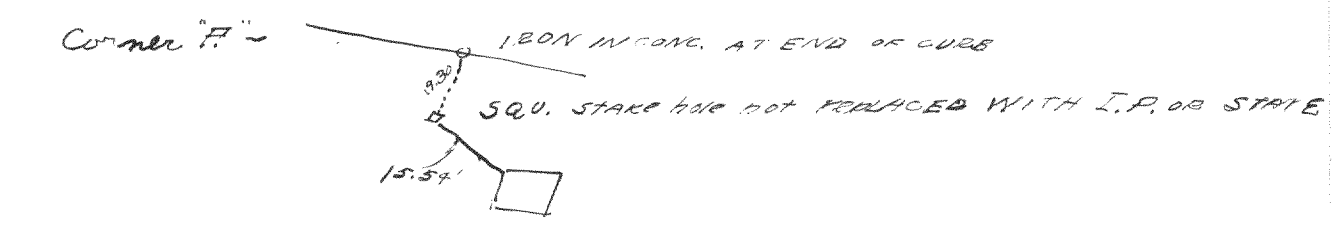

Survey of Lot 6 and part of Lot 5 of Block (2) of J. B. Devendorf's add. to the city of Dubuque -
April 28, 1937
Lloyd L. Jensen
by H. E. J.

NO. 814

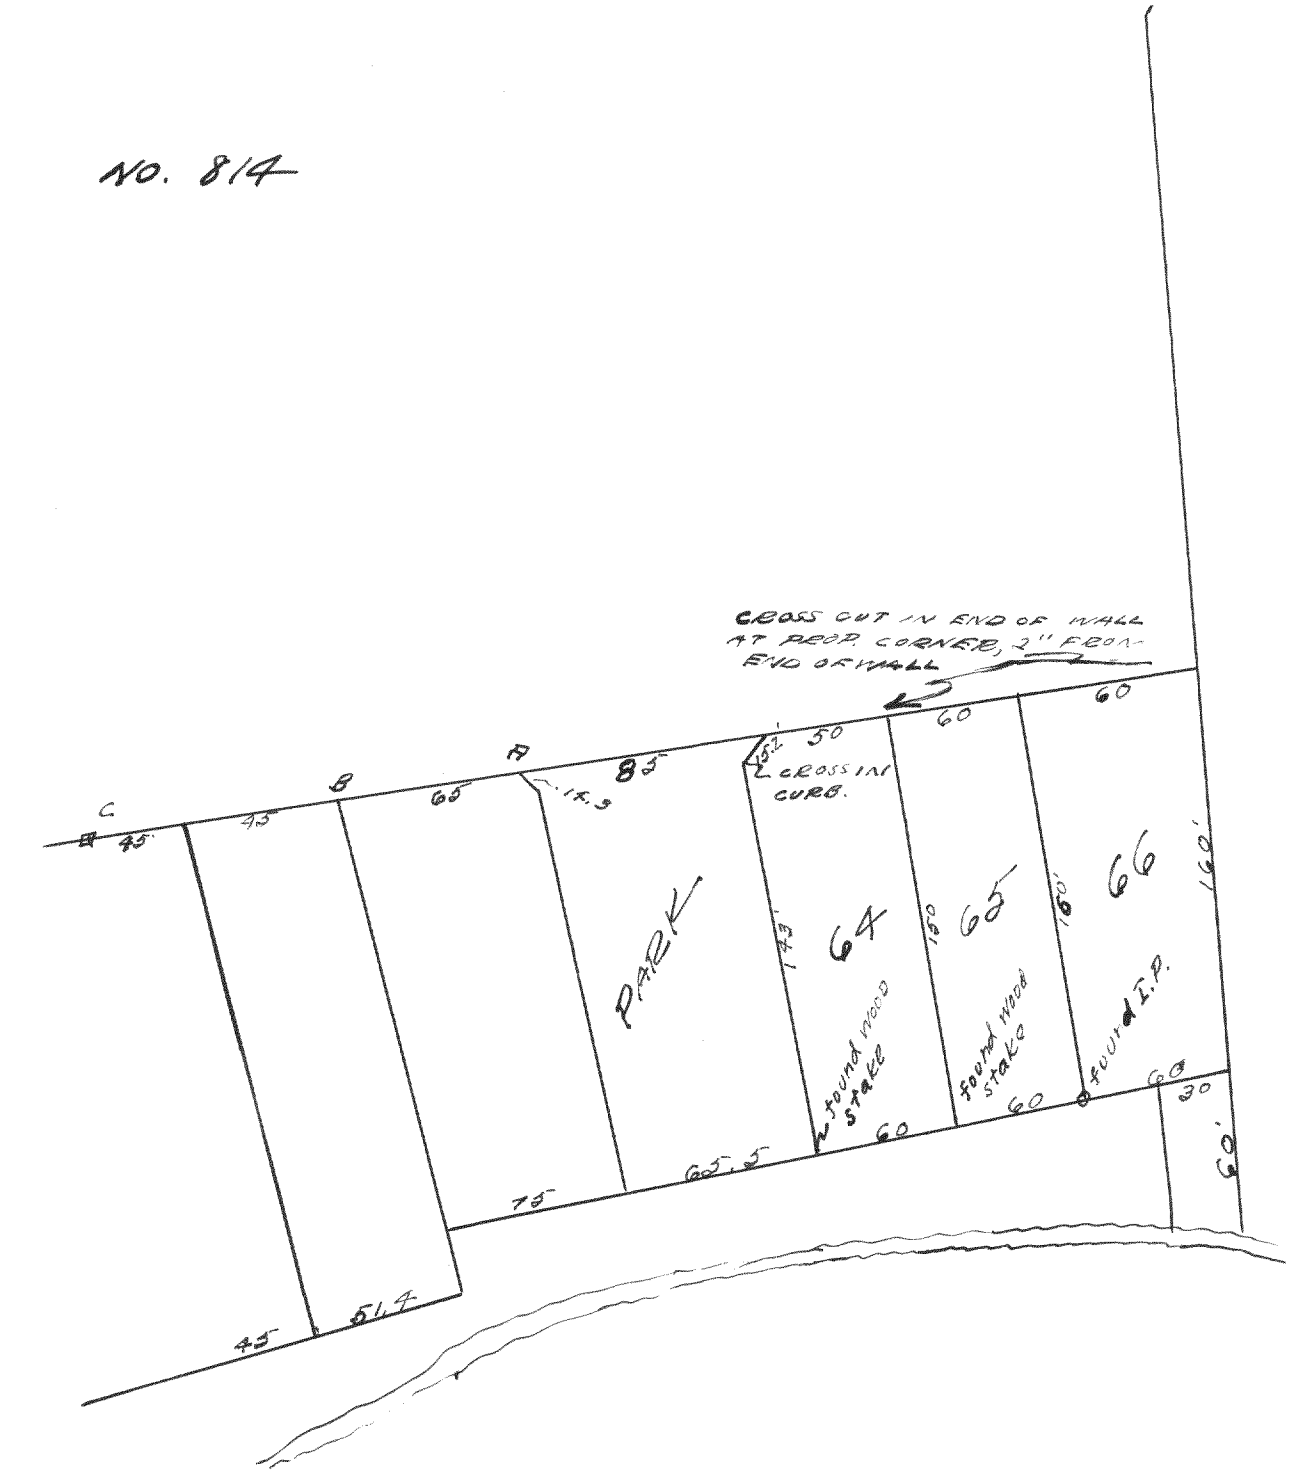

Corner B - wood stake in gutter to be replaced in May 1937 with I. P. when gutter is replaced.
Corner C - I. P. down 6-7" + 3 1/2" from end of apron on end of conc. drive.

Survey of lot 64 of the original plat of Cedar Point Park
May 1, 1937
Lloyd L. Jensen
by H. E. J.