


No 219

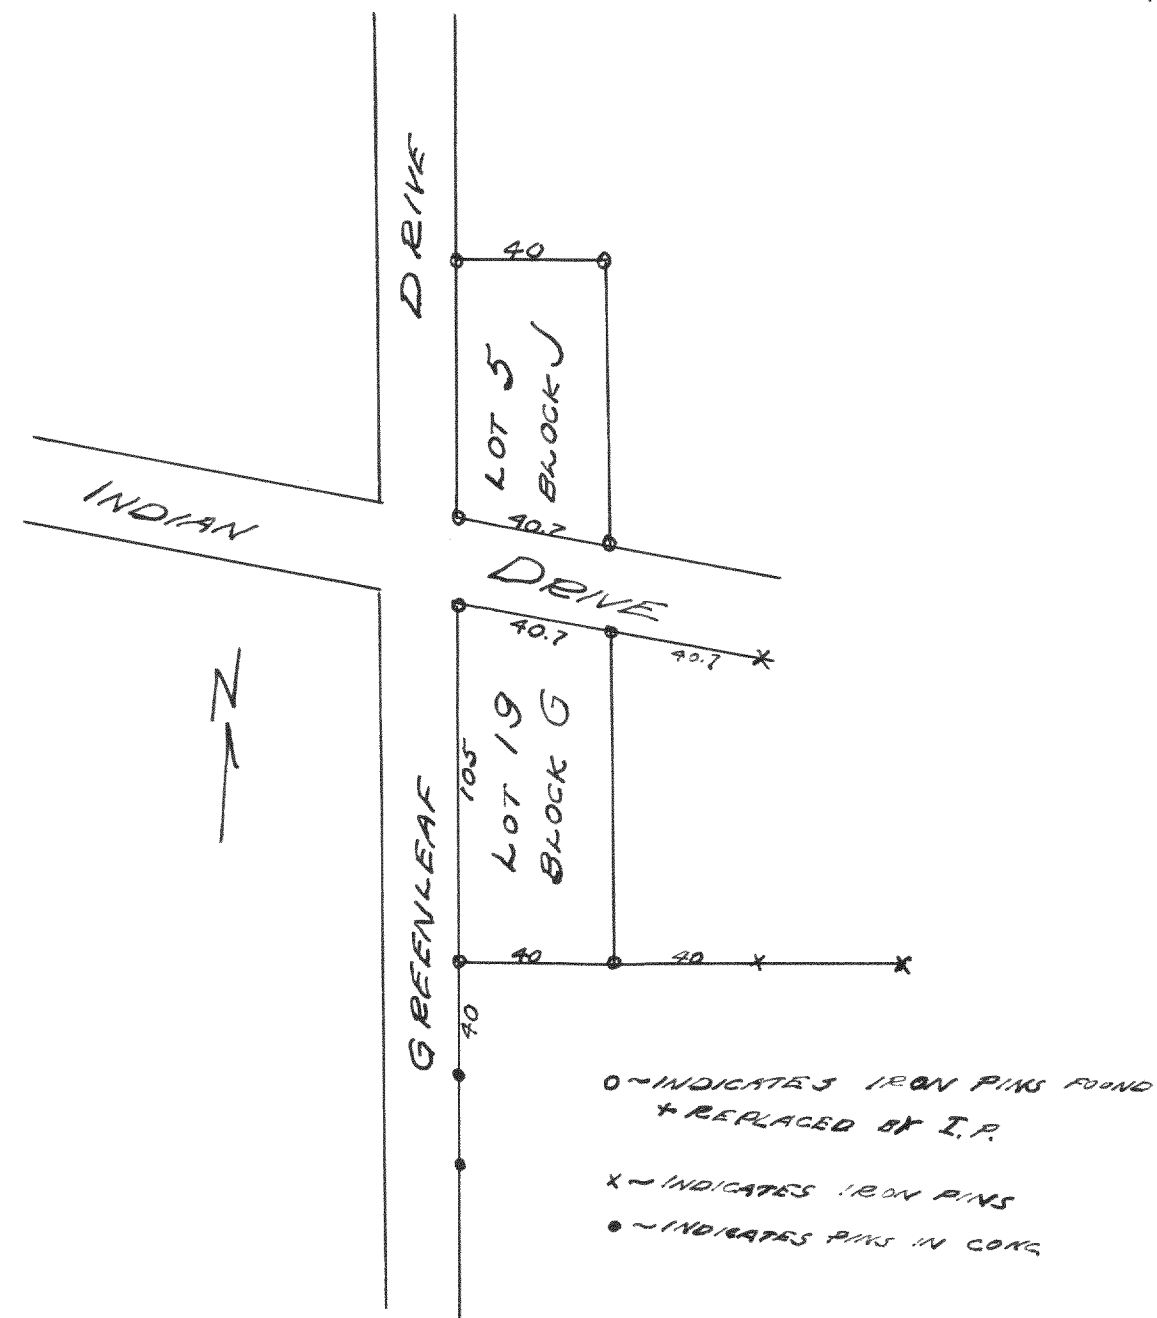


Survey of lot 19 block 5 and lot 5, block 5.  
of Cisco Beach Subdivision.

Aug. 1937

Lloyd L. Jensen  
by H. E. J.

No. 820

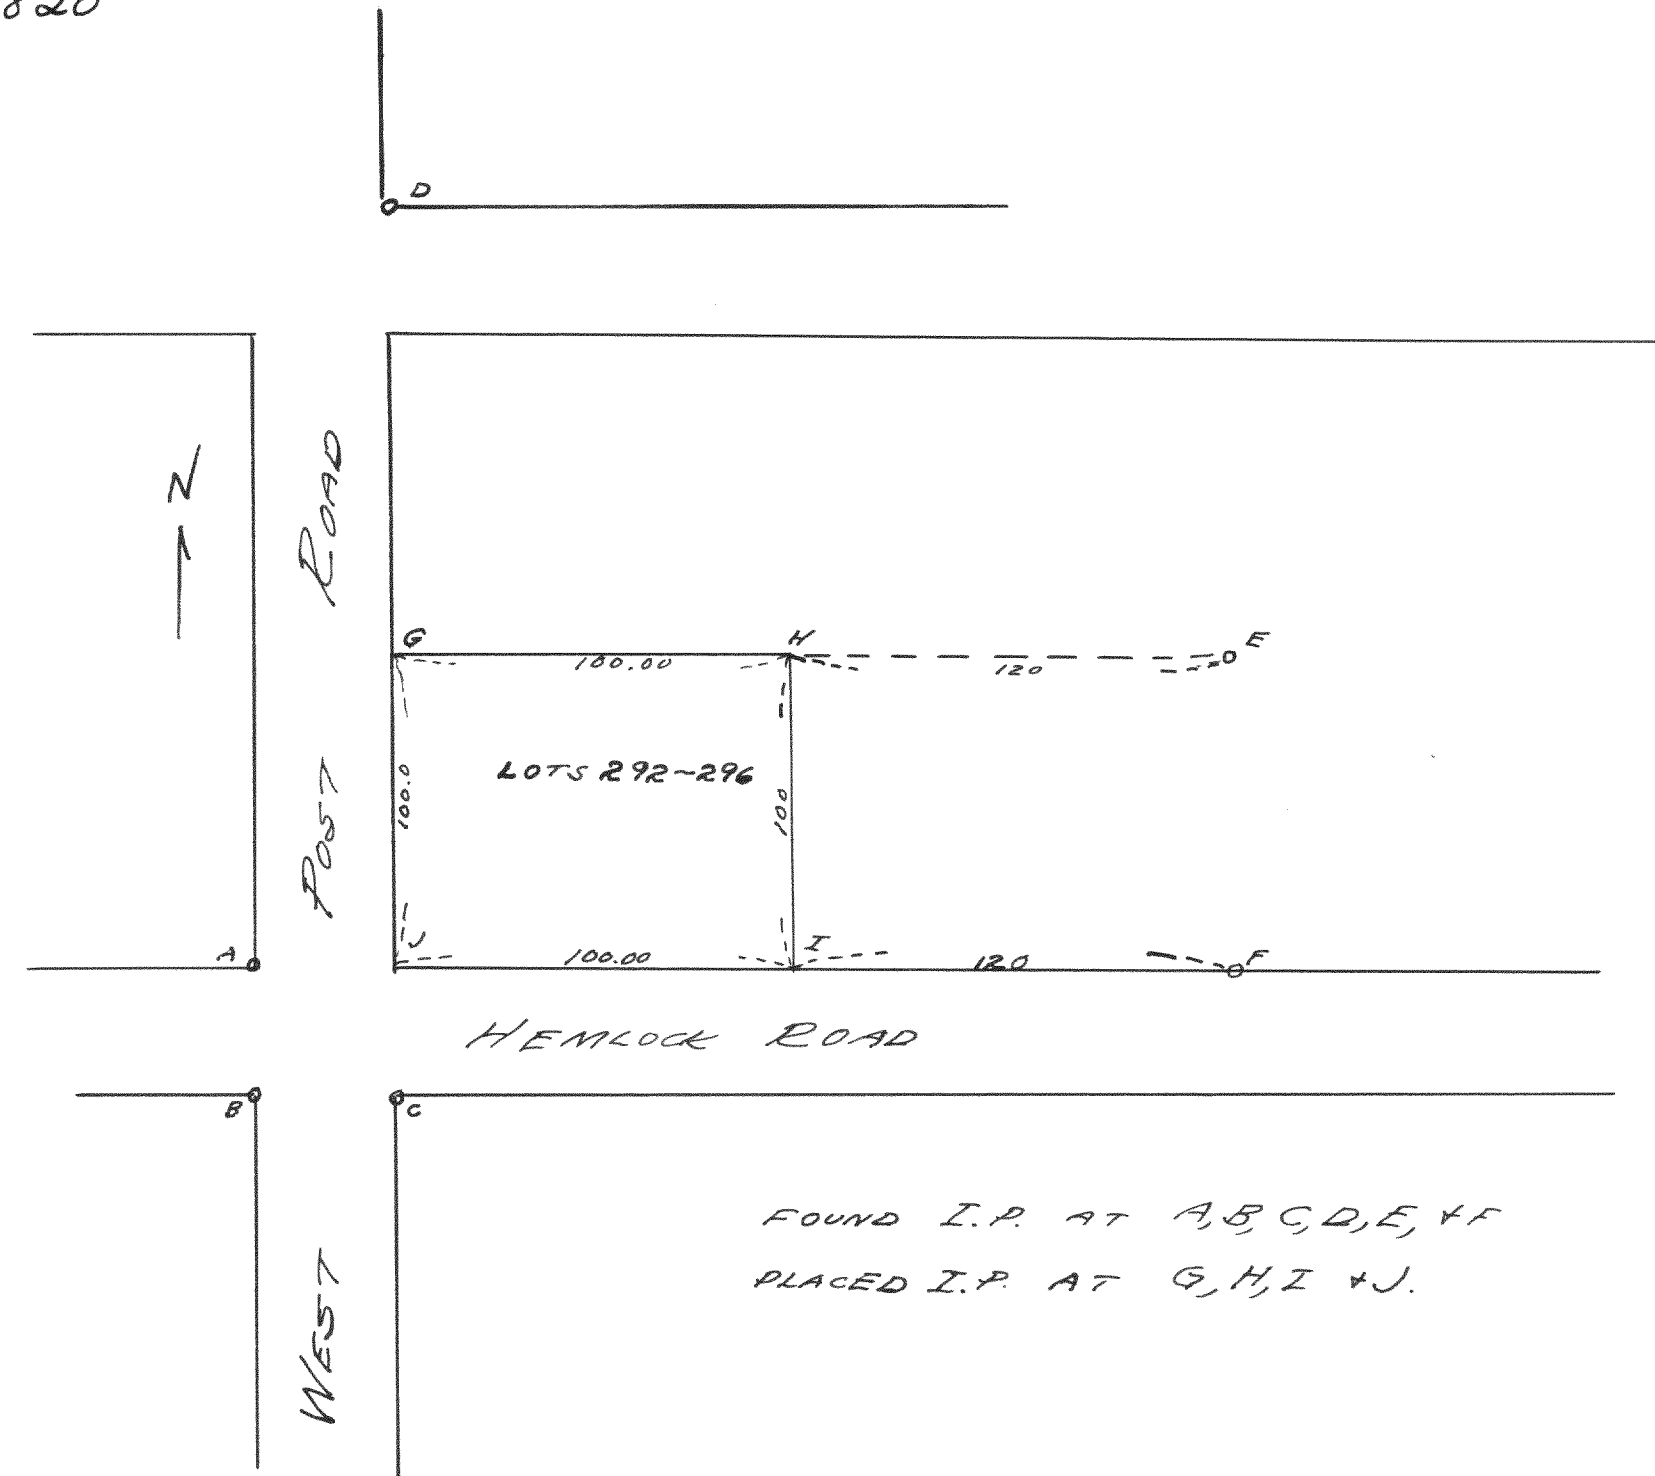

Survey of lots 292-296, inclusive, of Bell Lake  
subdivision

Aug. 1937

Lloyd L. Jensen  
by H. E. J.