




262

No. 821

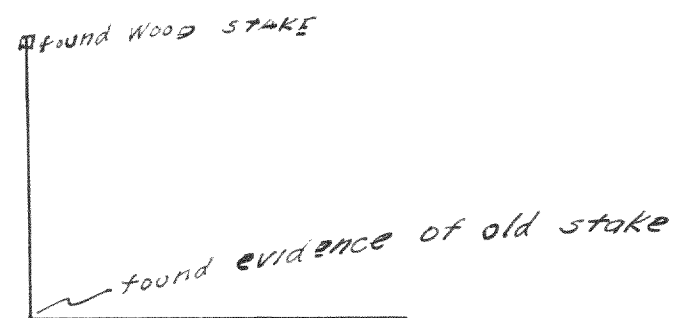

No. 822

Survey of Lot 145 of Krumhairs 2nd Add.,
located in Section 31-2-16

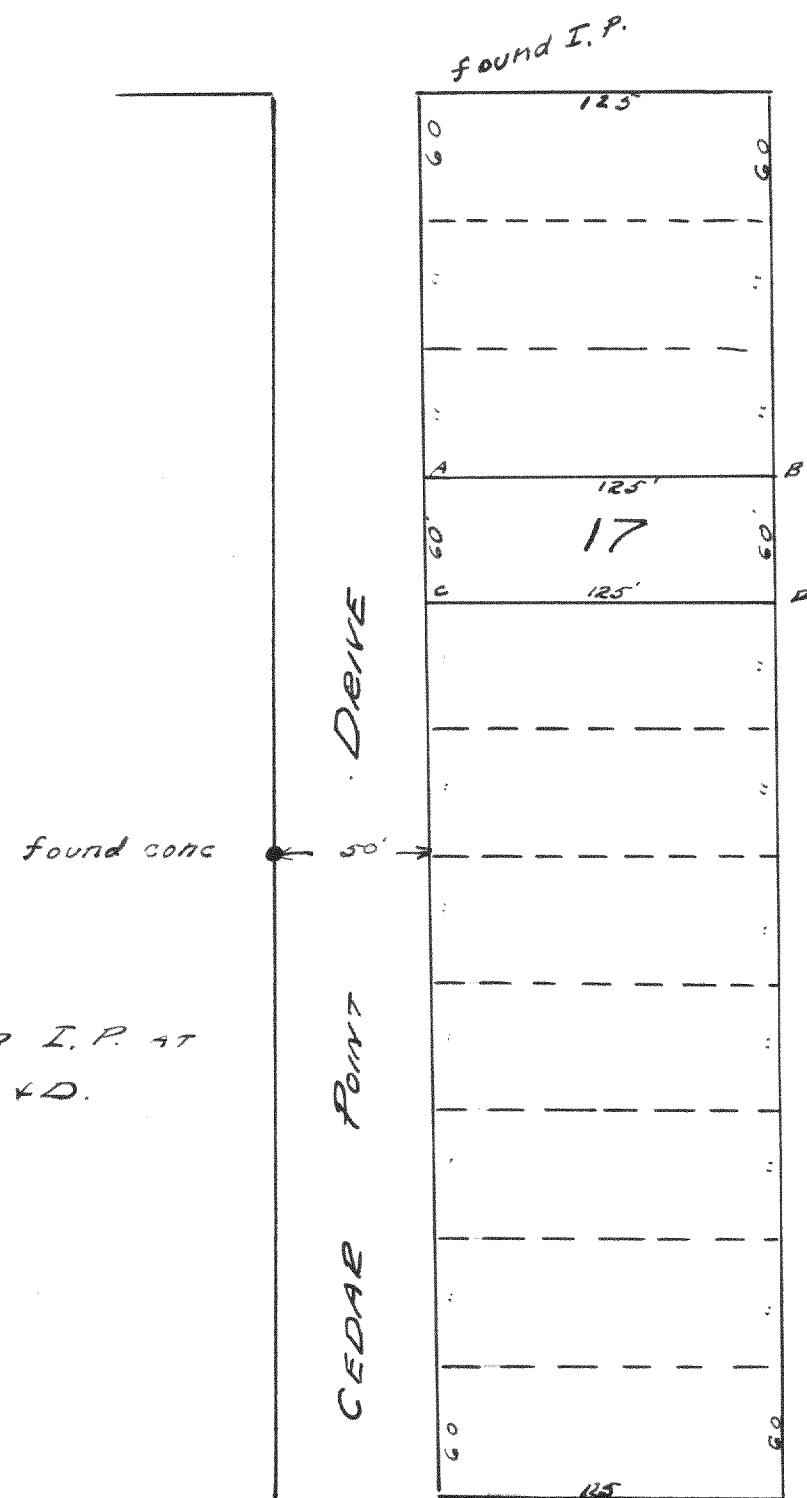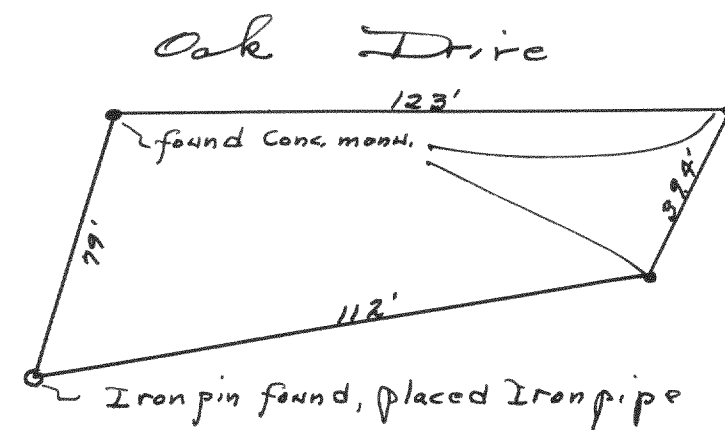

PLACED I. P. AT
A, B, C, & D.

Floyd L. Jensen
Co. Sur.
5-24-37

Lot 17 CEDAR PT. PARK (ORIGINAL)

7-37

Floyd L. Jensen
by H. E. J.