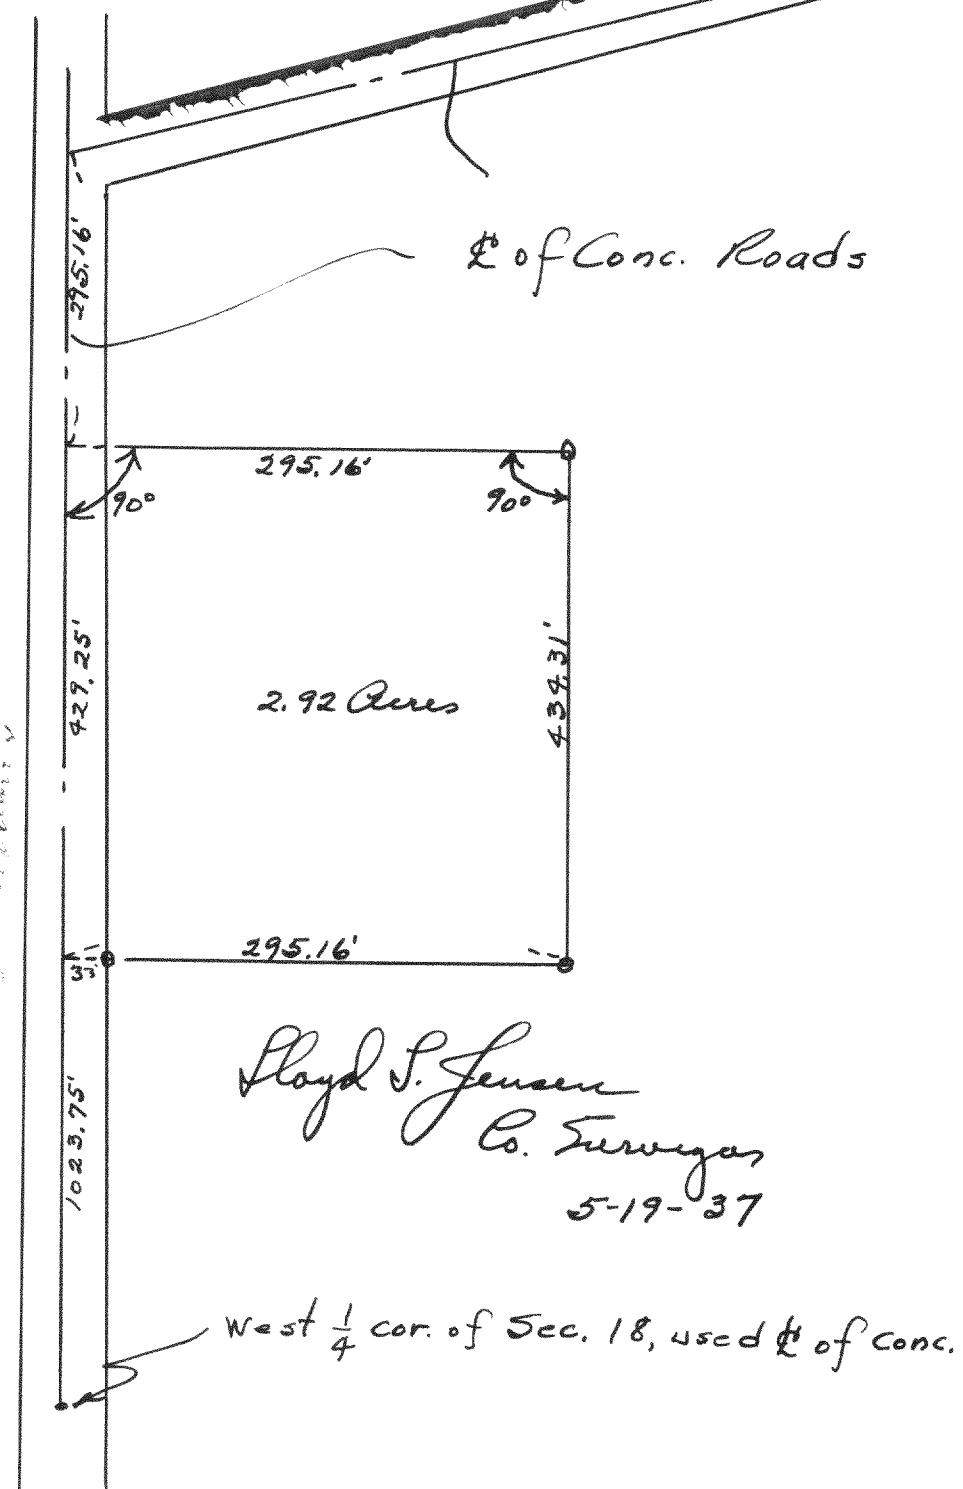
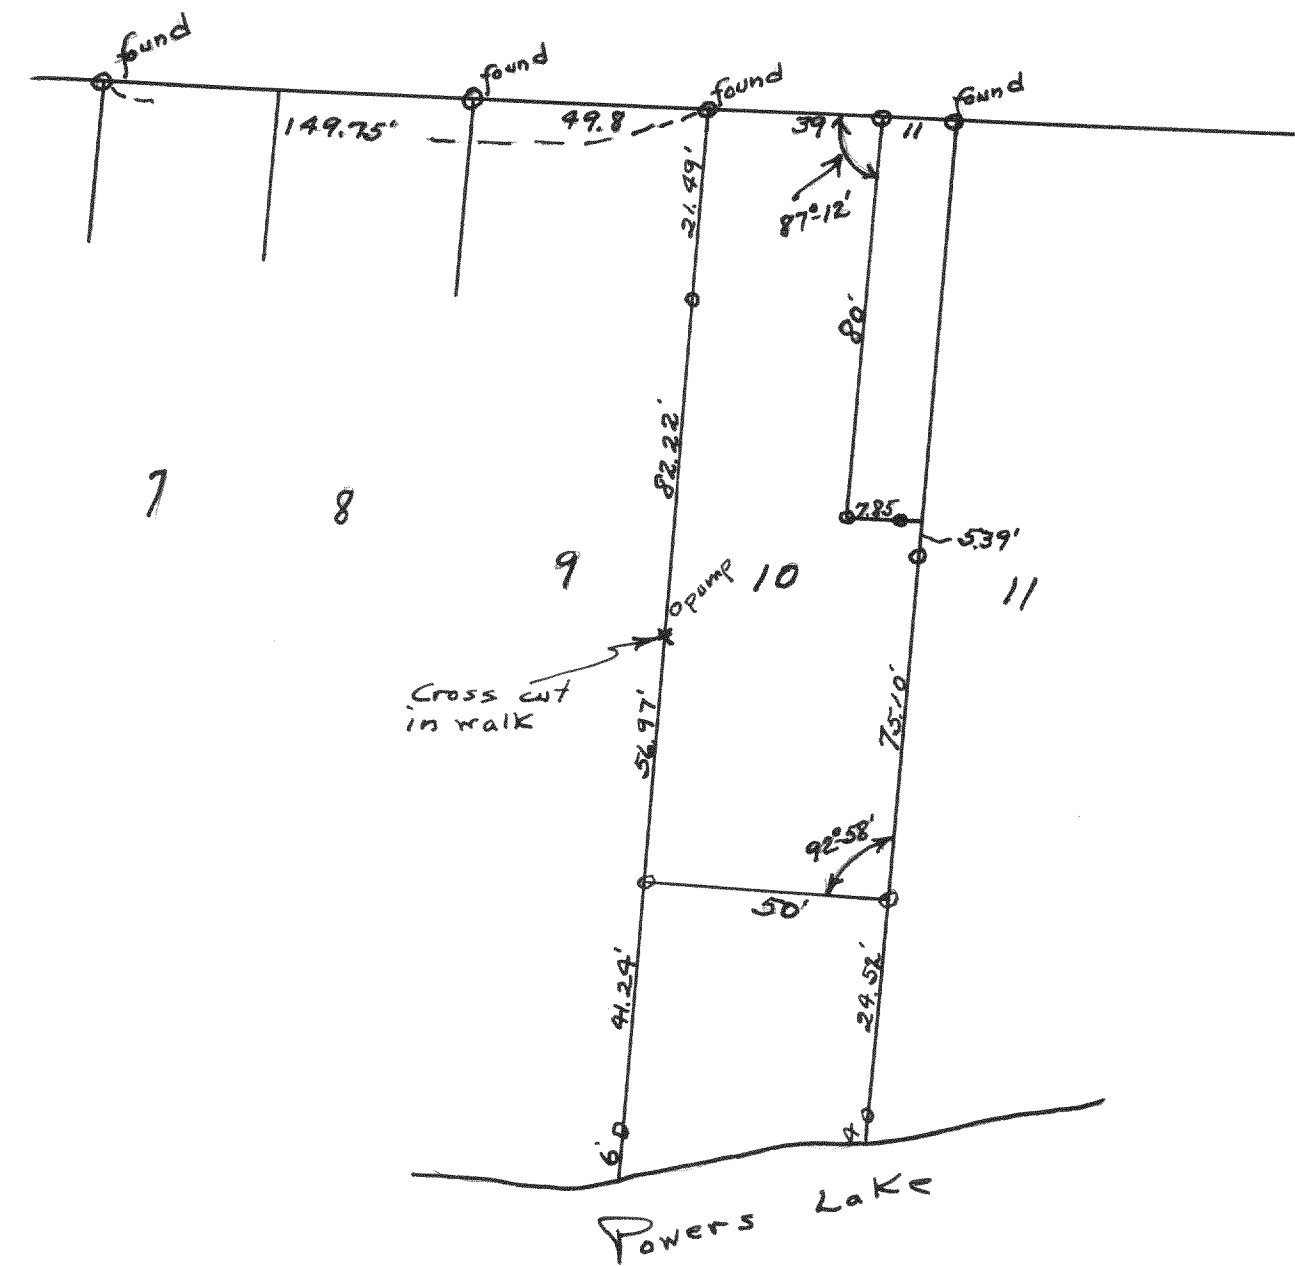


No. 823

Survey of land in The N. $\frac{1}{2}$ of
Section 18-36-17.

Lloyd S. Jensen
Co. Surveyor
5-19-37

No. 824

Survey of Lot 10 of William
Eliot's Subd. at Powers Lake.
Sec. 13-1-18

Lloyd S. Jensen
Co. Sur.
5-37