



No. 825 Survey of part of Lots 4 and 7
of Block 20 of Passage Area &
Blowies Add. to the City of Kelowna.

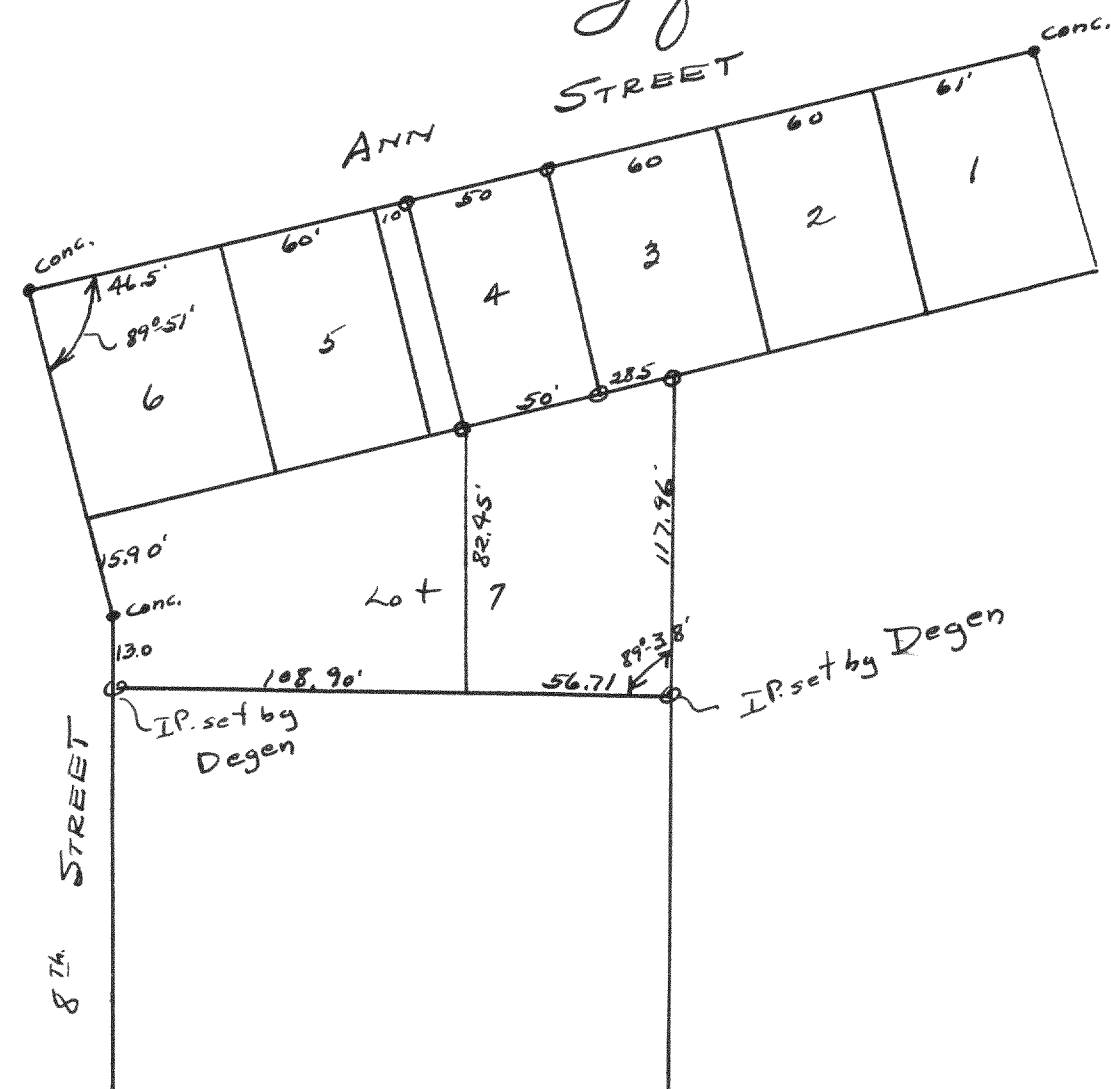

Lloyd S. Jensen
Co. Sur.
6-25-37

No. 826

Survey of The old cemetery at Troy
in Section 28, T4N R17E.

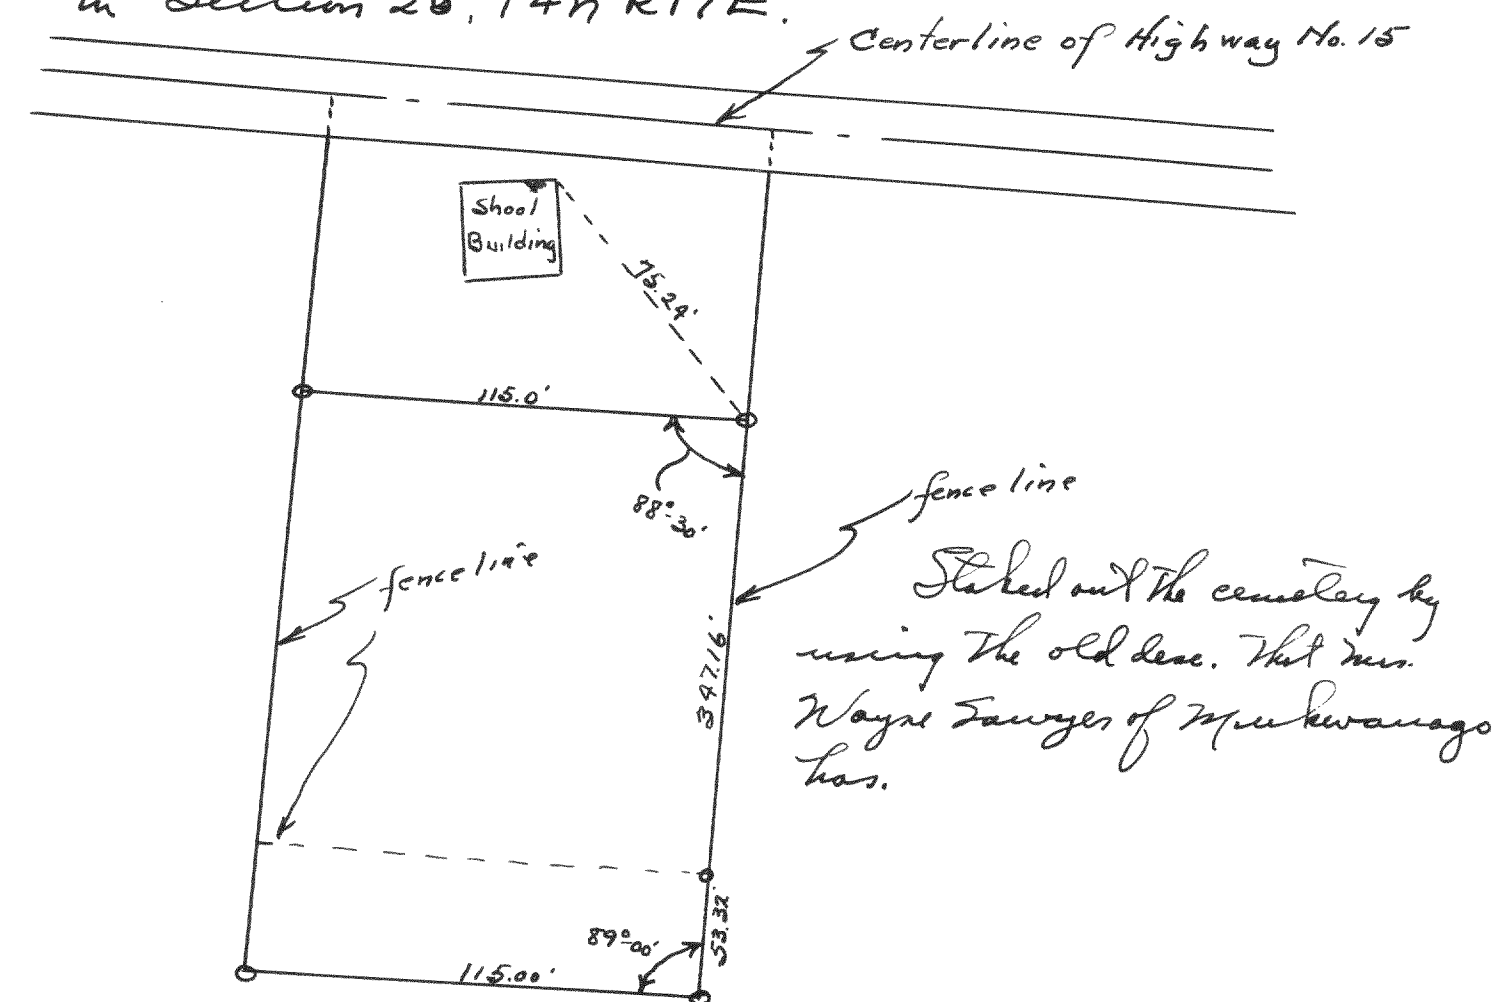

Lloyd S. Jensen
Co. Sur.
6-19-37