



No. 827

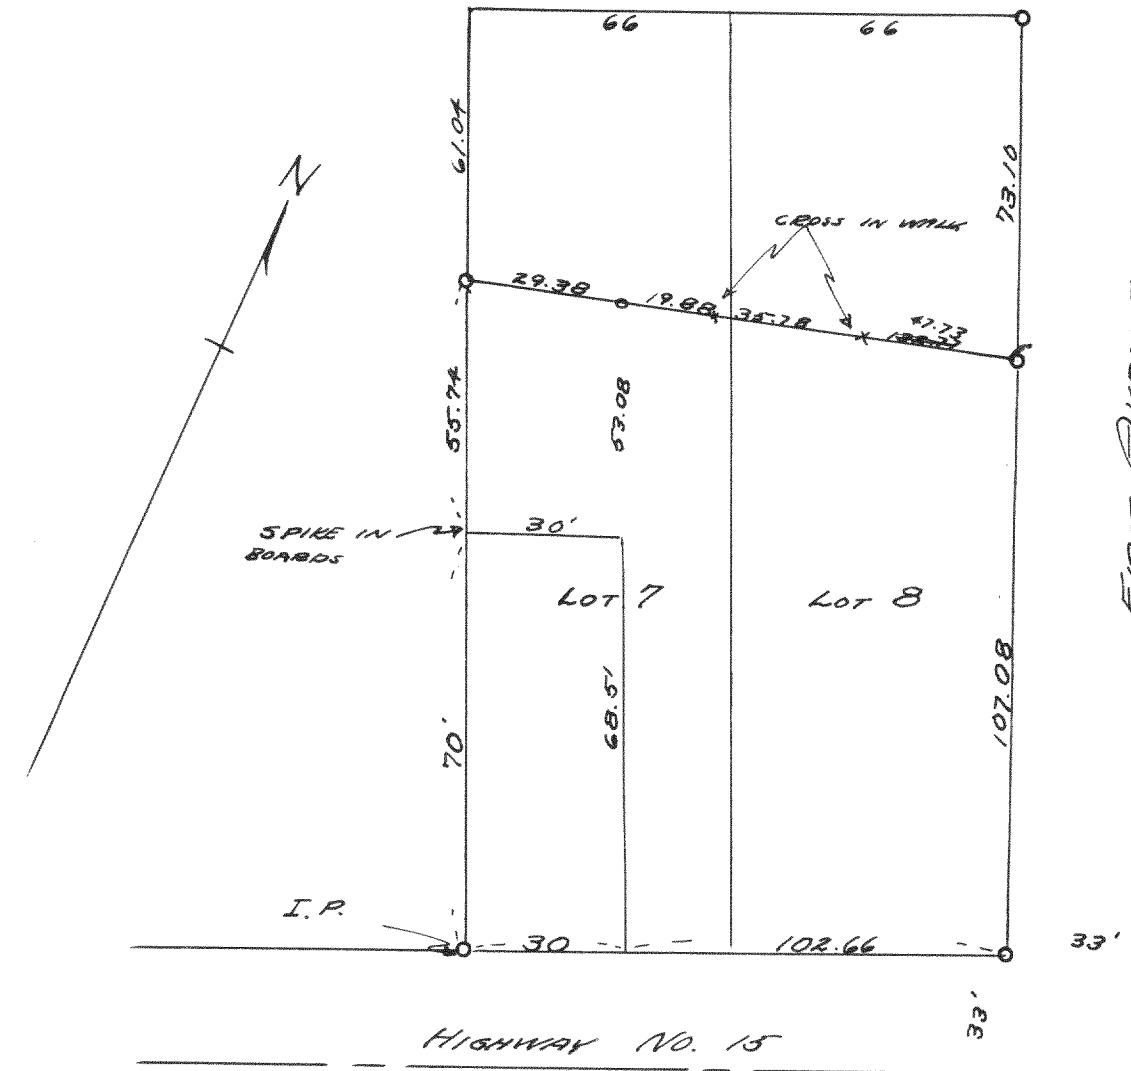

LOTS 7 & 8 OF BLOCK 8, ORIGINAL TOWN
Dec-27-2-15
OF DARIEN - JUNE 1938

Lloyd L. Jensen
by H. E. J.

No. 828

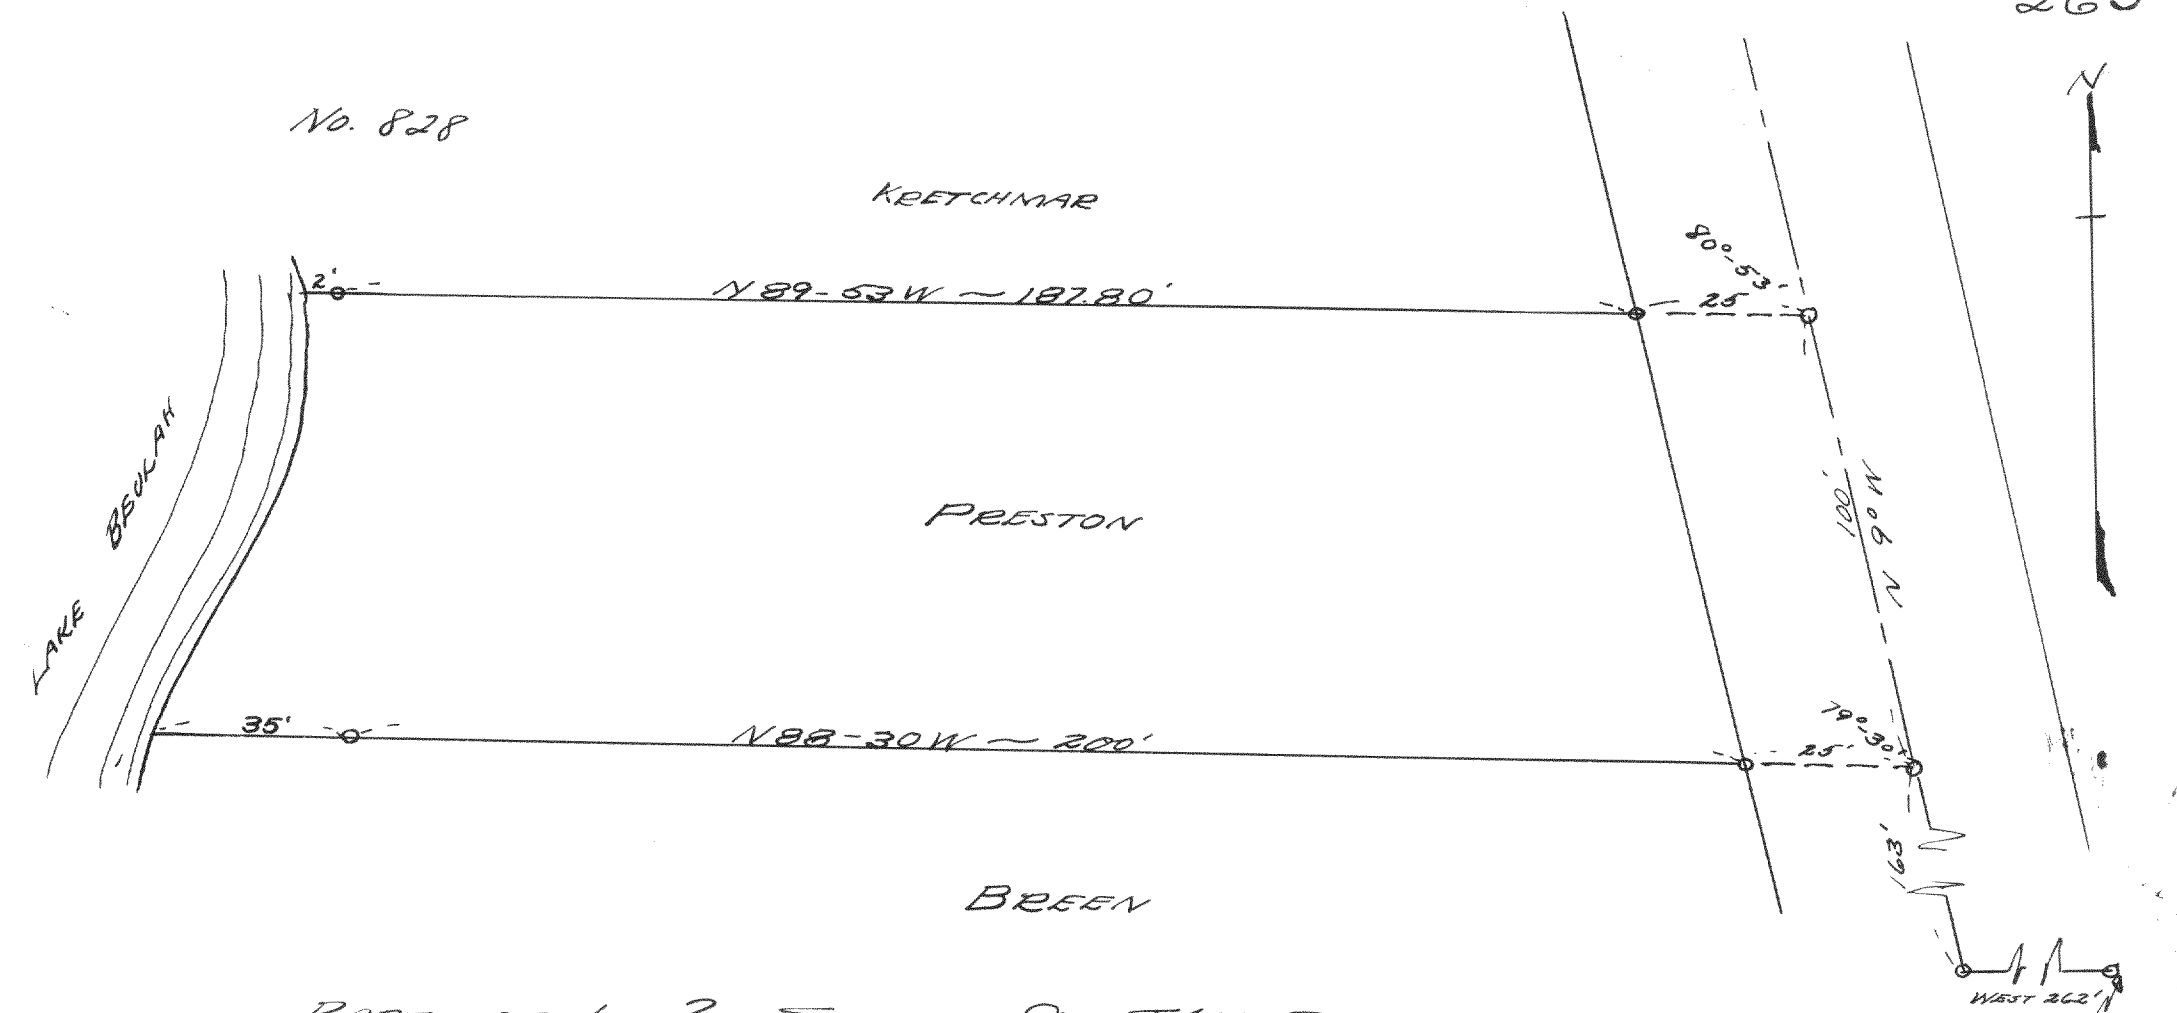

PART OF LOT 2, SECTION 9, T4N, R18E - APRIL 1938
EAST 1/4 CORNER OF SECTION 9
T4N R18E

June 1938

Lloyd L. Jensen
by H. E. J.

265