



No. 829

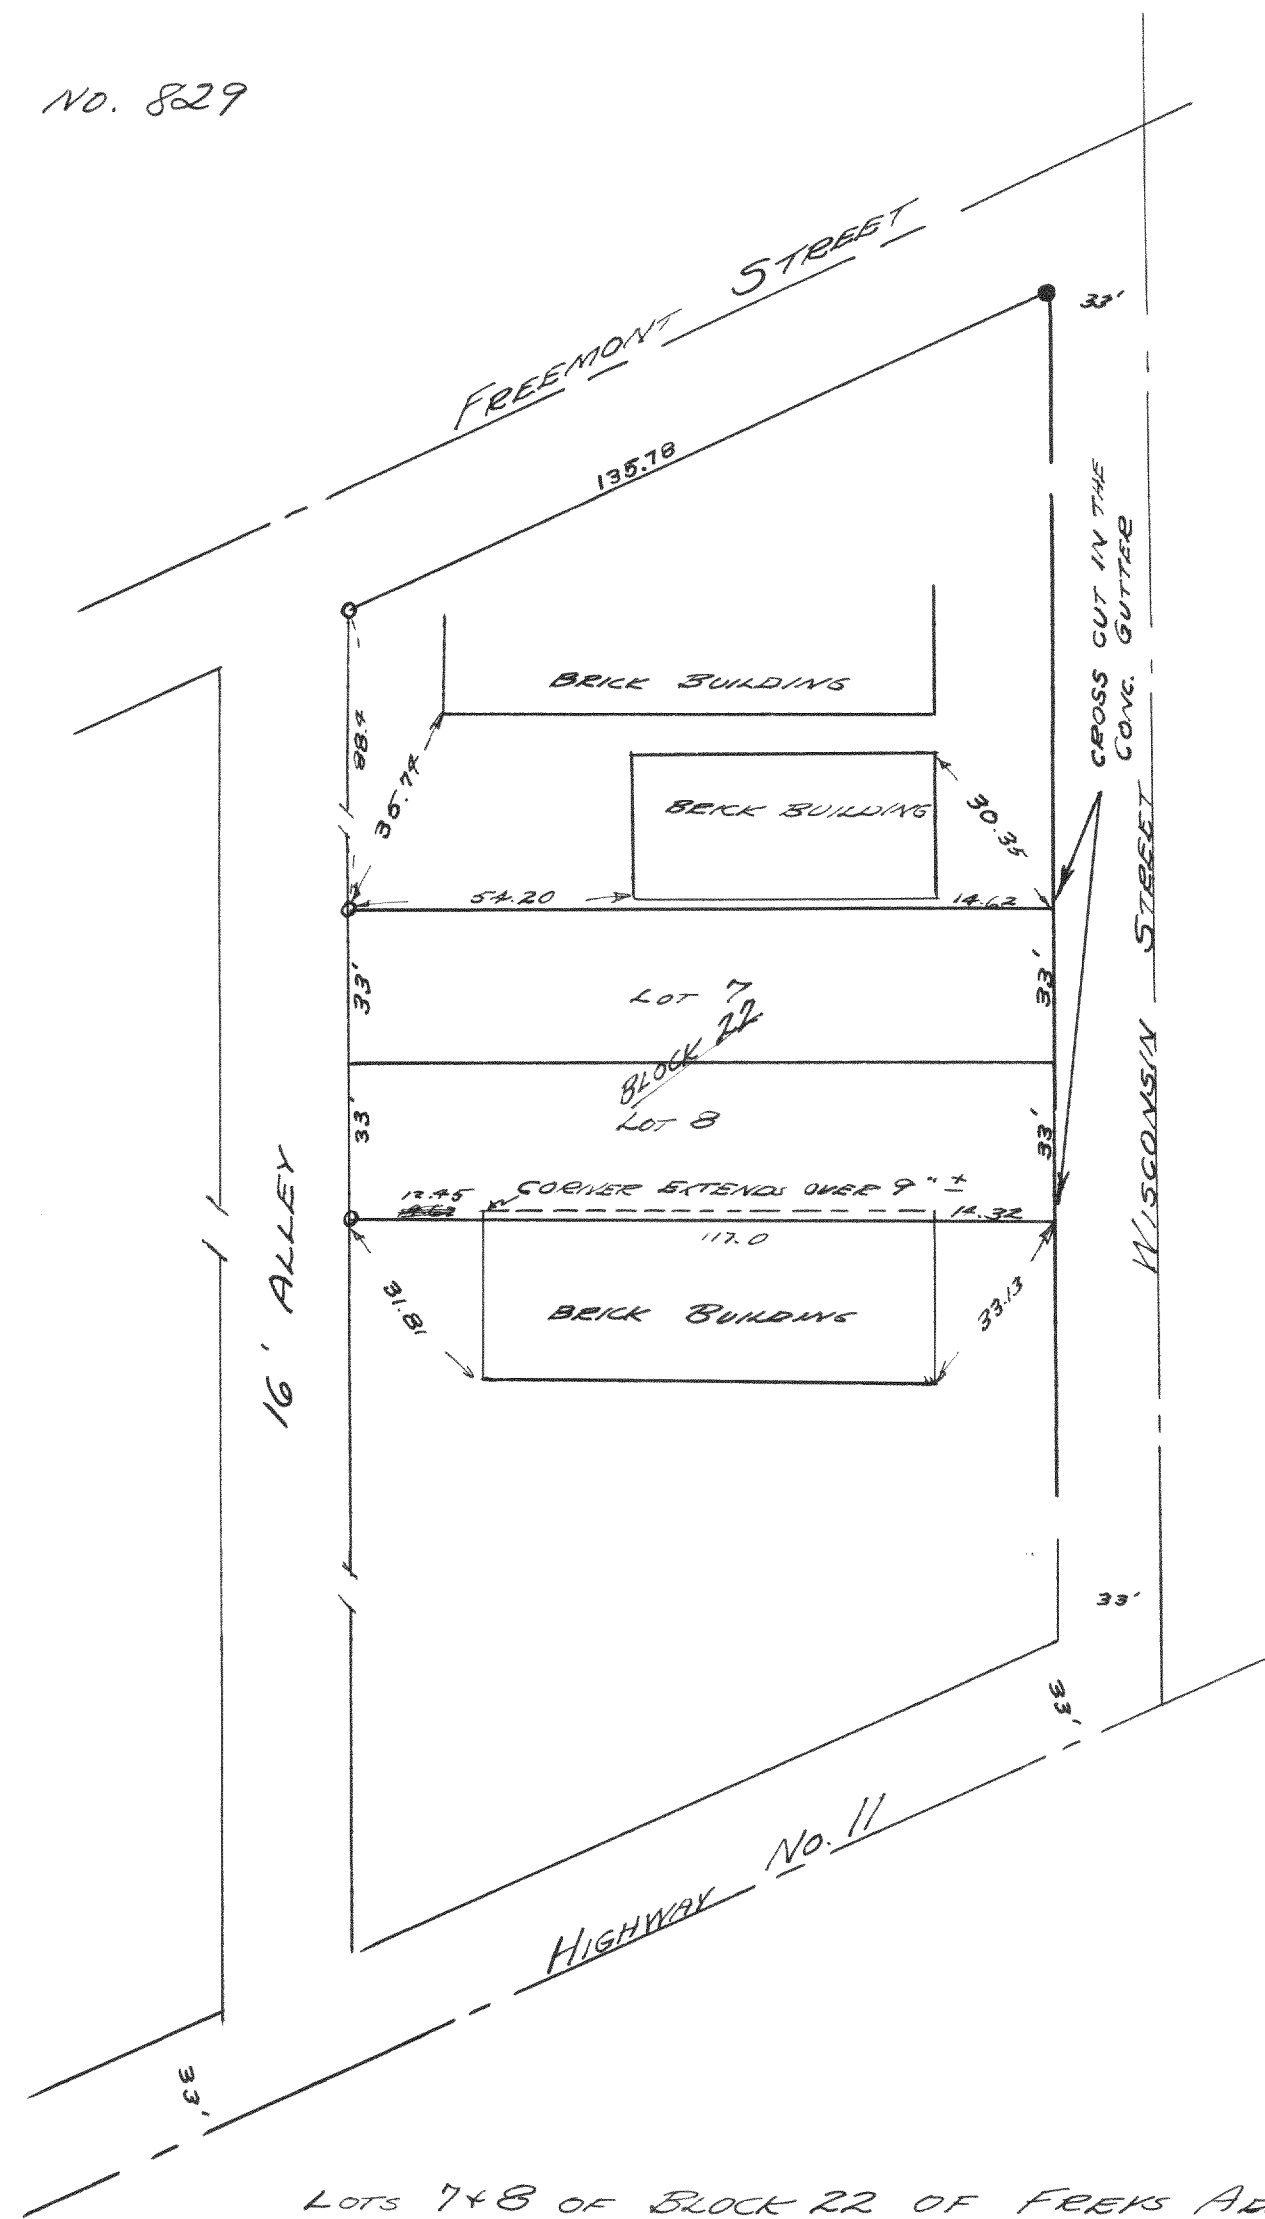

LOTS 7 & 8 OF BLOCK 22 OF FREES ADD.
TO THE VILLAGE OF DARIEN - SEC 27-2-15
July 1938
Lloyd L. Jensen
by K.E.J.

No. 830

WALDMAN TO TWIST 11-6-37

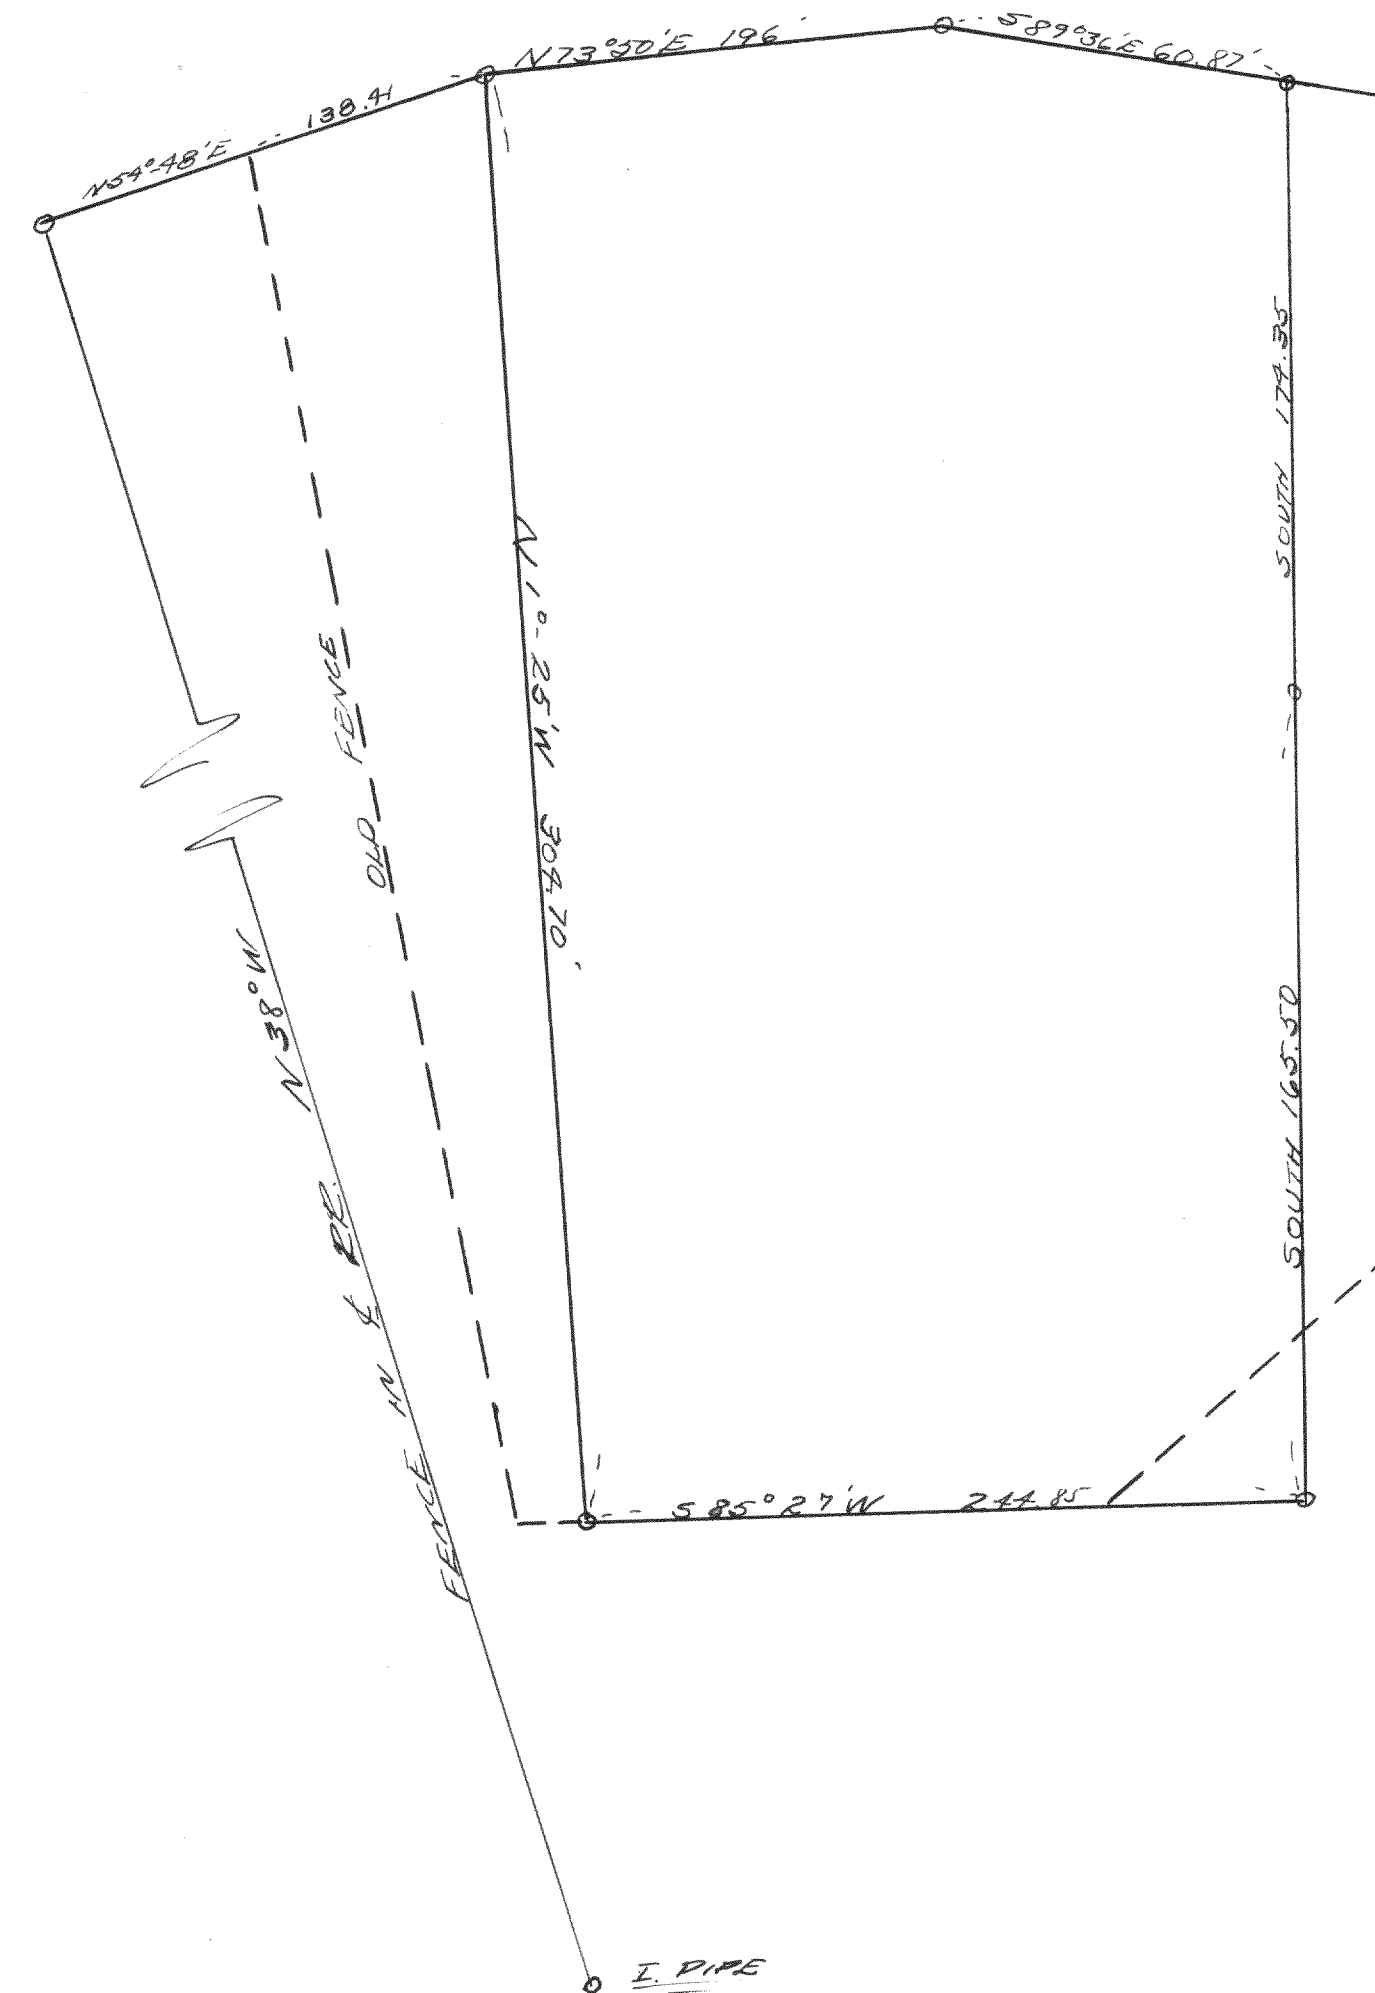

SURVEY OF PART OF SE $\frac{1}{4}$
SECTION 15 T2N R17E.

November 1937

Lloyd L. Jensen
by H. E. J.