


No. 836

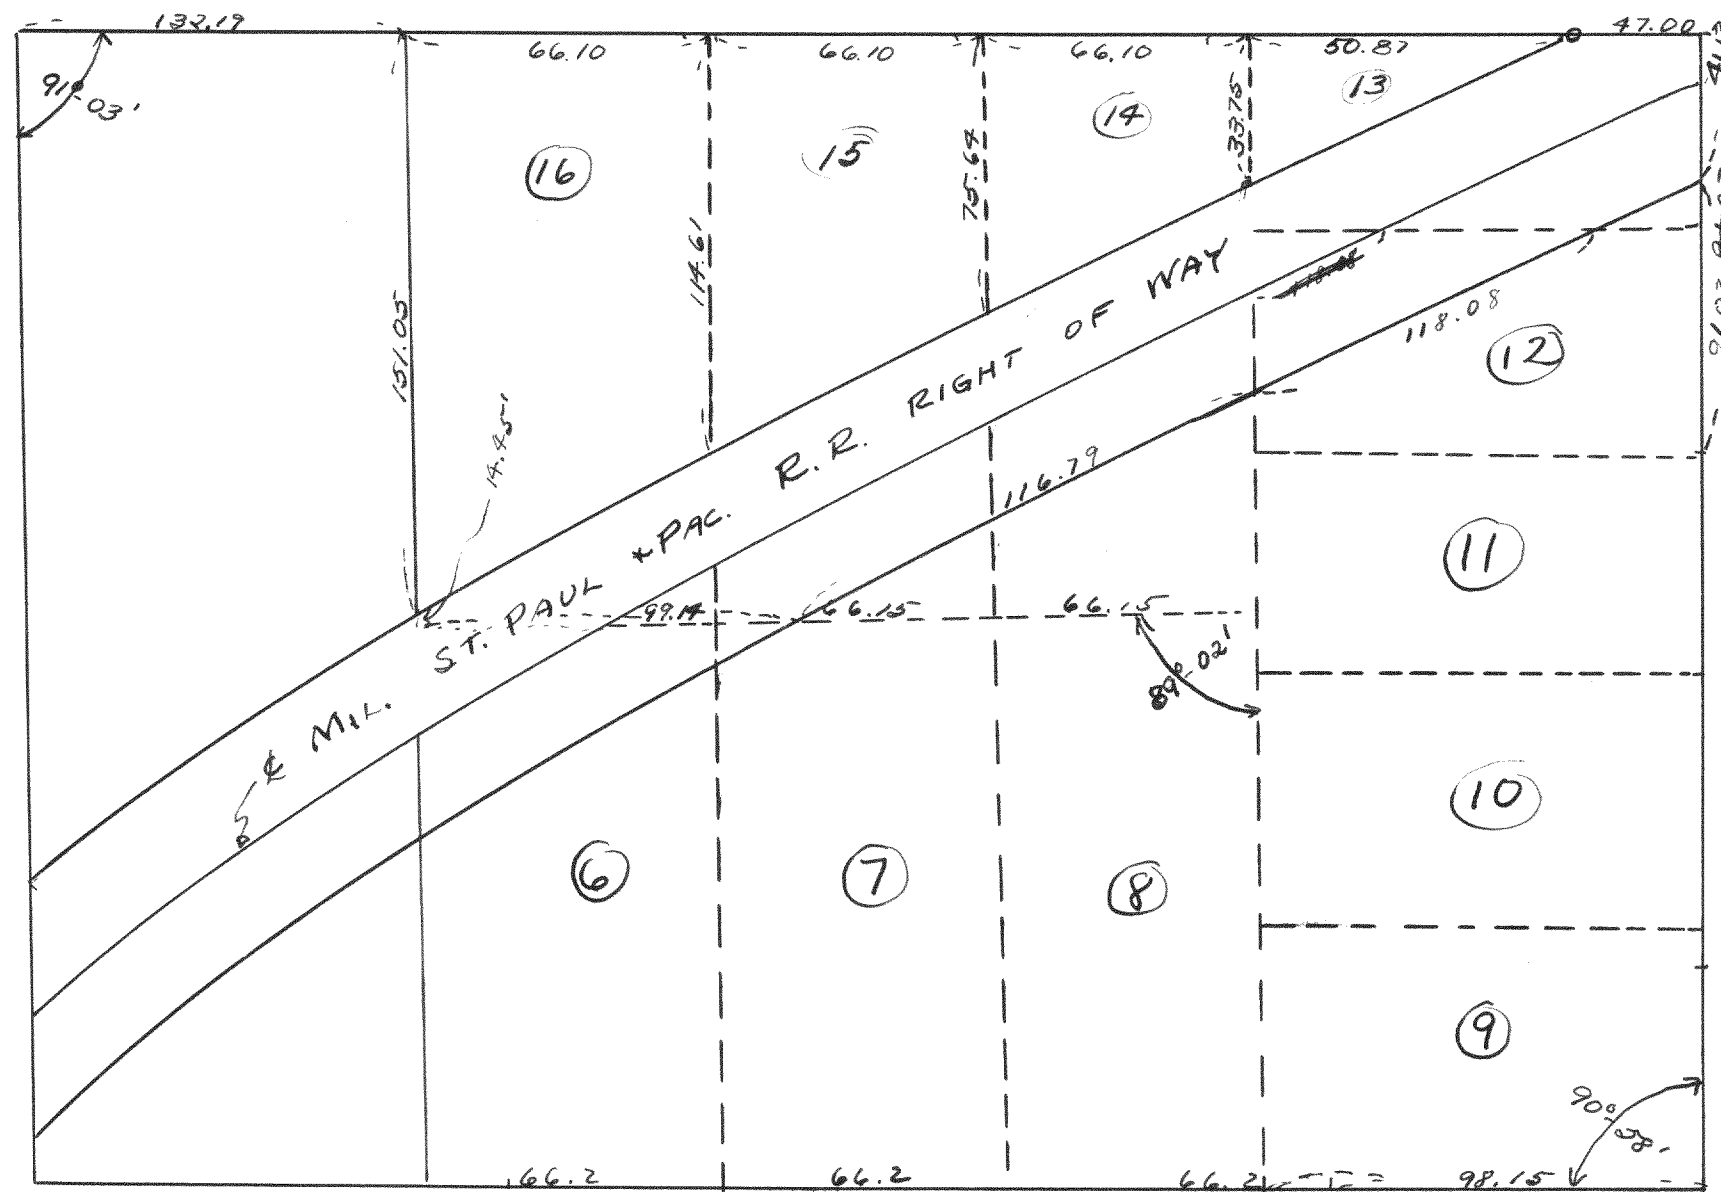


Survey of Lots 13, 14, 15, & 16 of Block 3 of Elderkins addition to the city of Elkhorn

8-13-37

Lloyd L. Jensen  
by H.E.J.

269

No. 837.

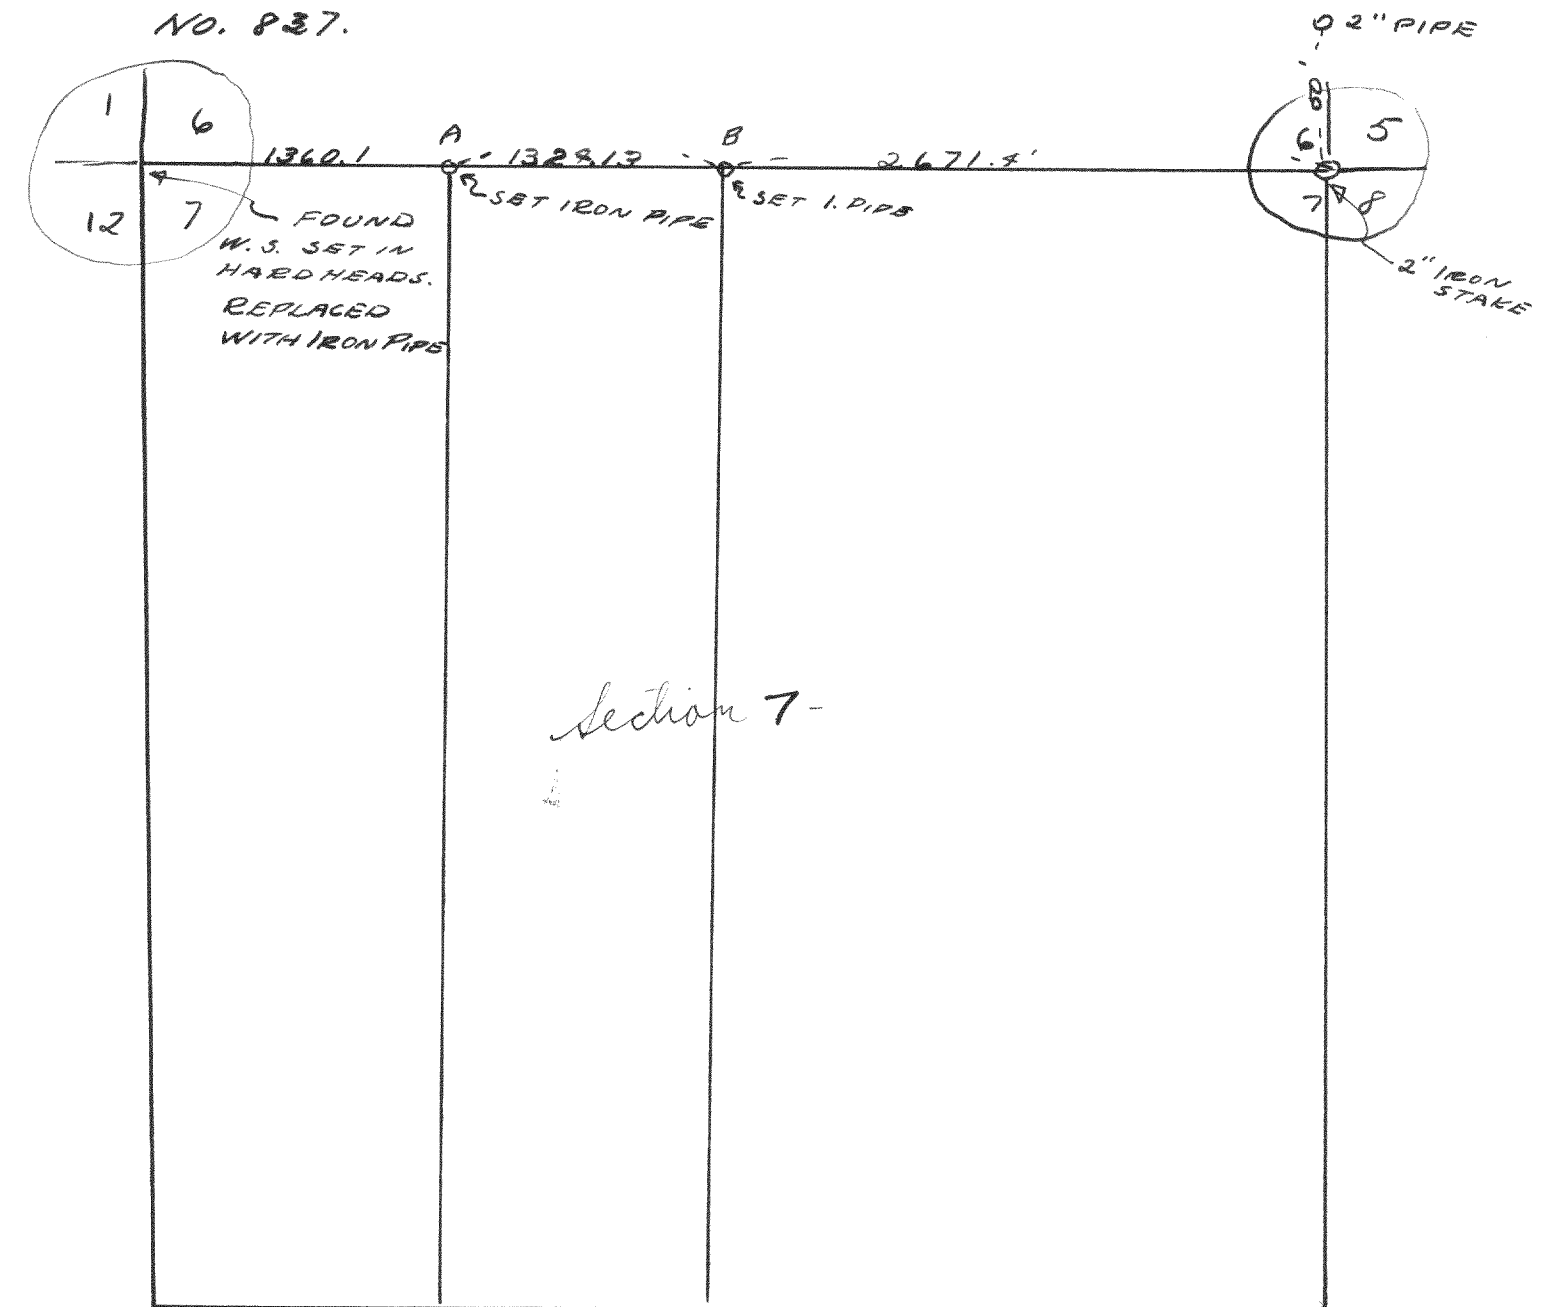

Survey to locate line A-B WHICH is the N line of E 1/2 of W 1/2 of section 7-3-16

8-19-37

Lloyd L. Jensen  
by H.E.J.