


No. 840

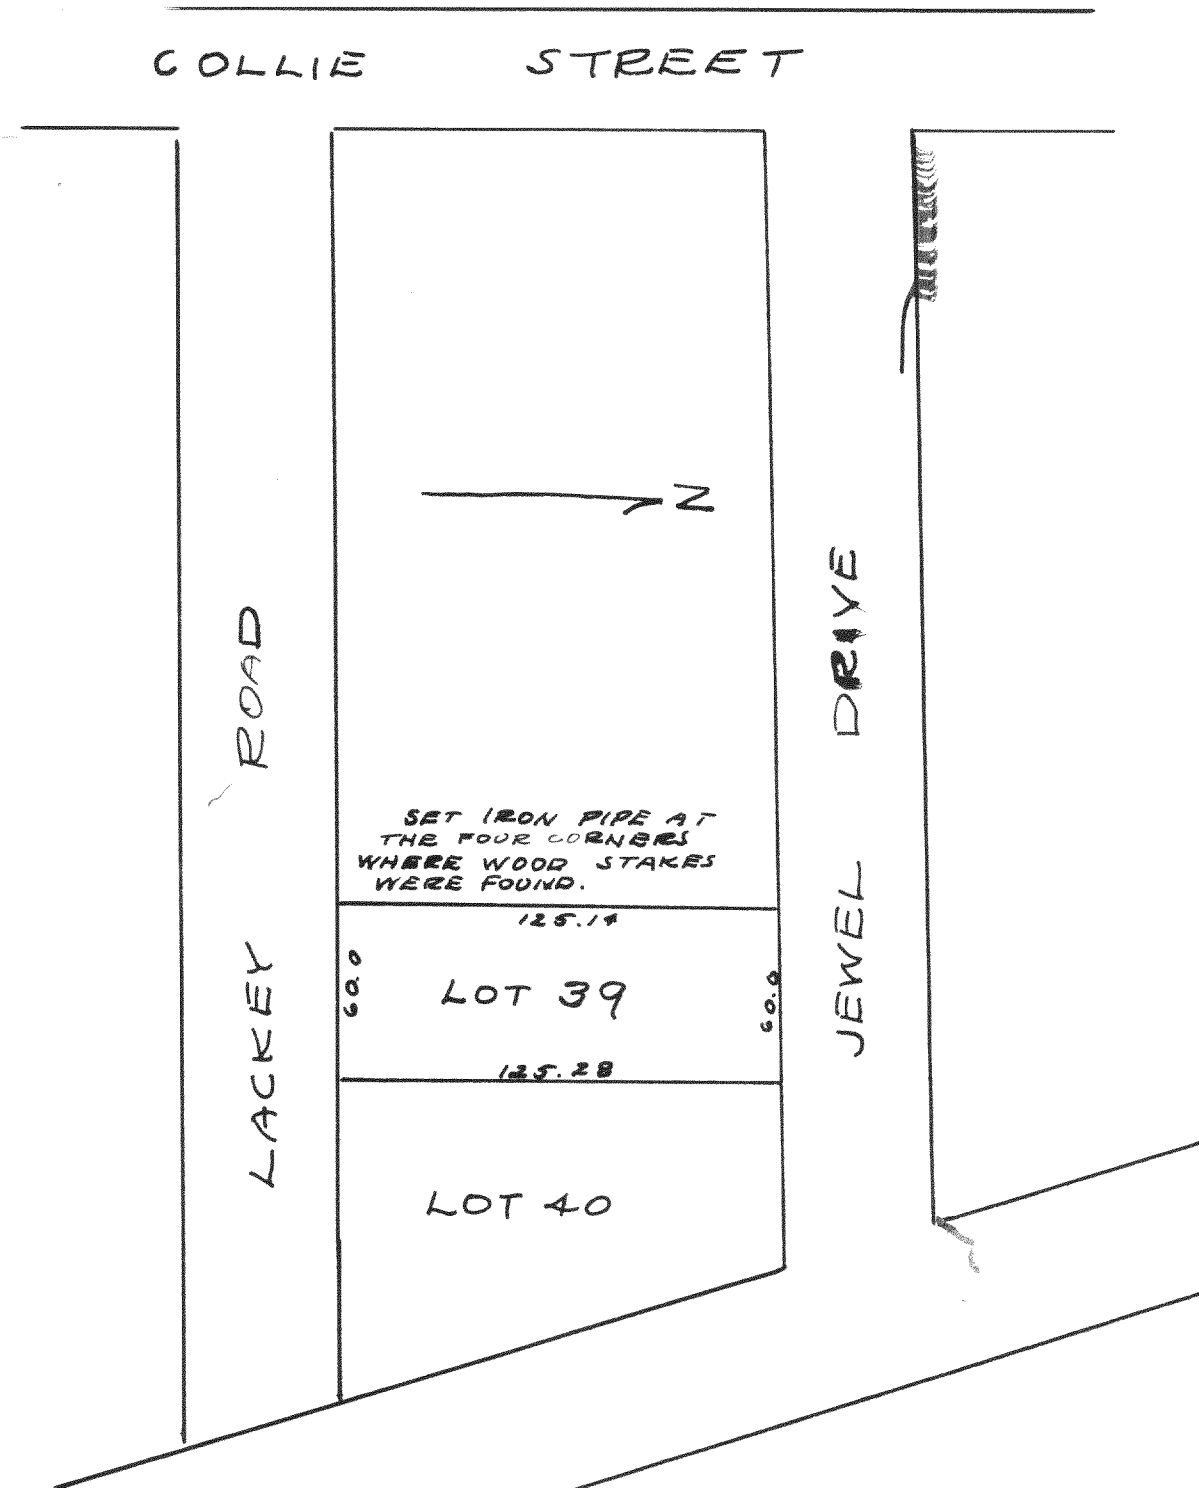


Survey made of lot 39 of Lackey Bros. Subdivision in the village of Wm. Bay.

Sept. 1937

Lloyd L. Jensen
by H.E.J.


No. 841

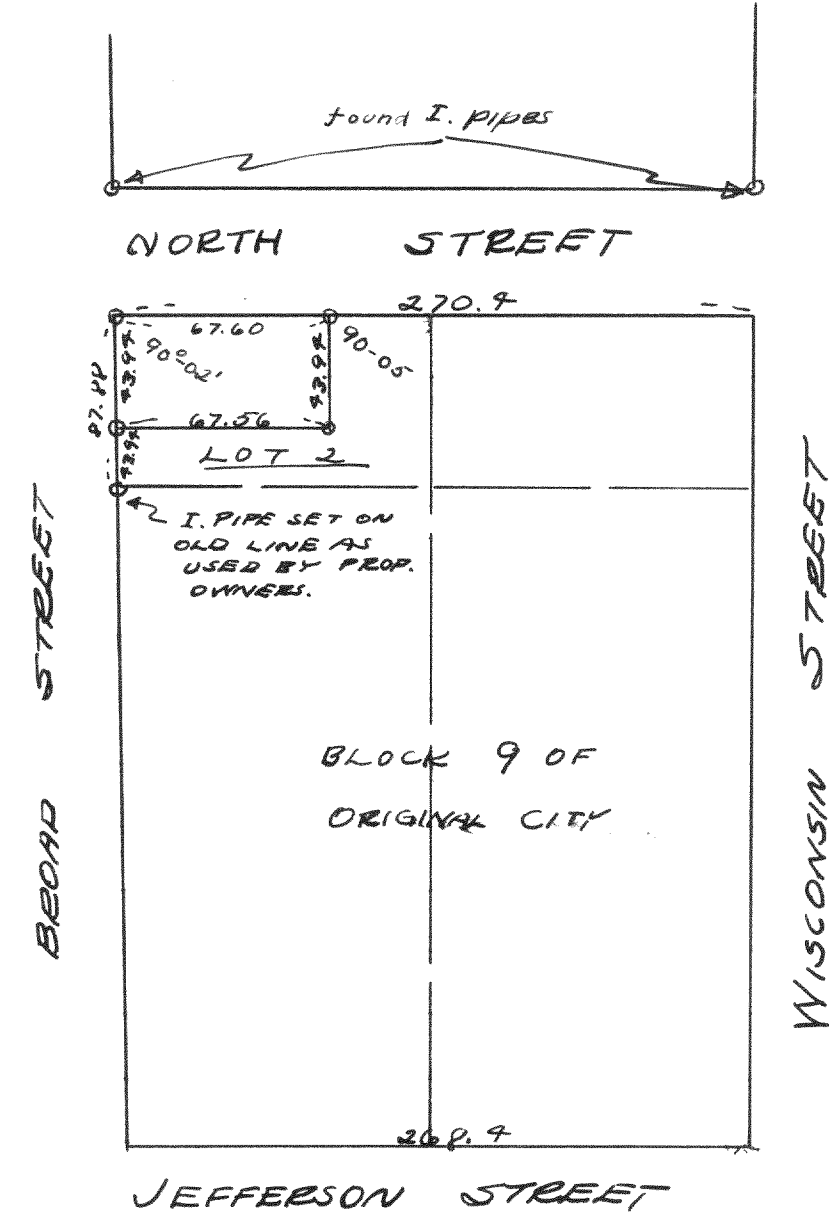

Survey of part of lot 2 block 9 of the original city of Elkhorn - sec. 31-3-17
11-22-37

Lloyd L. Jensen
by H.E.J.

No. 842

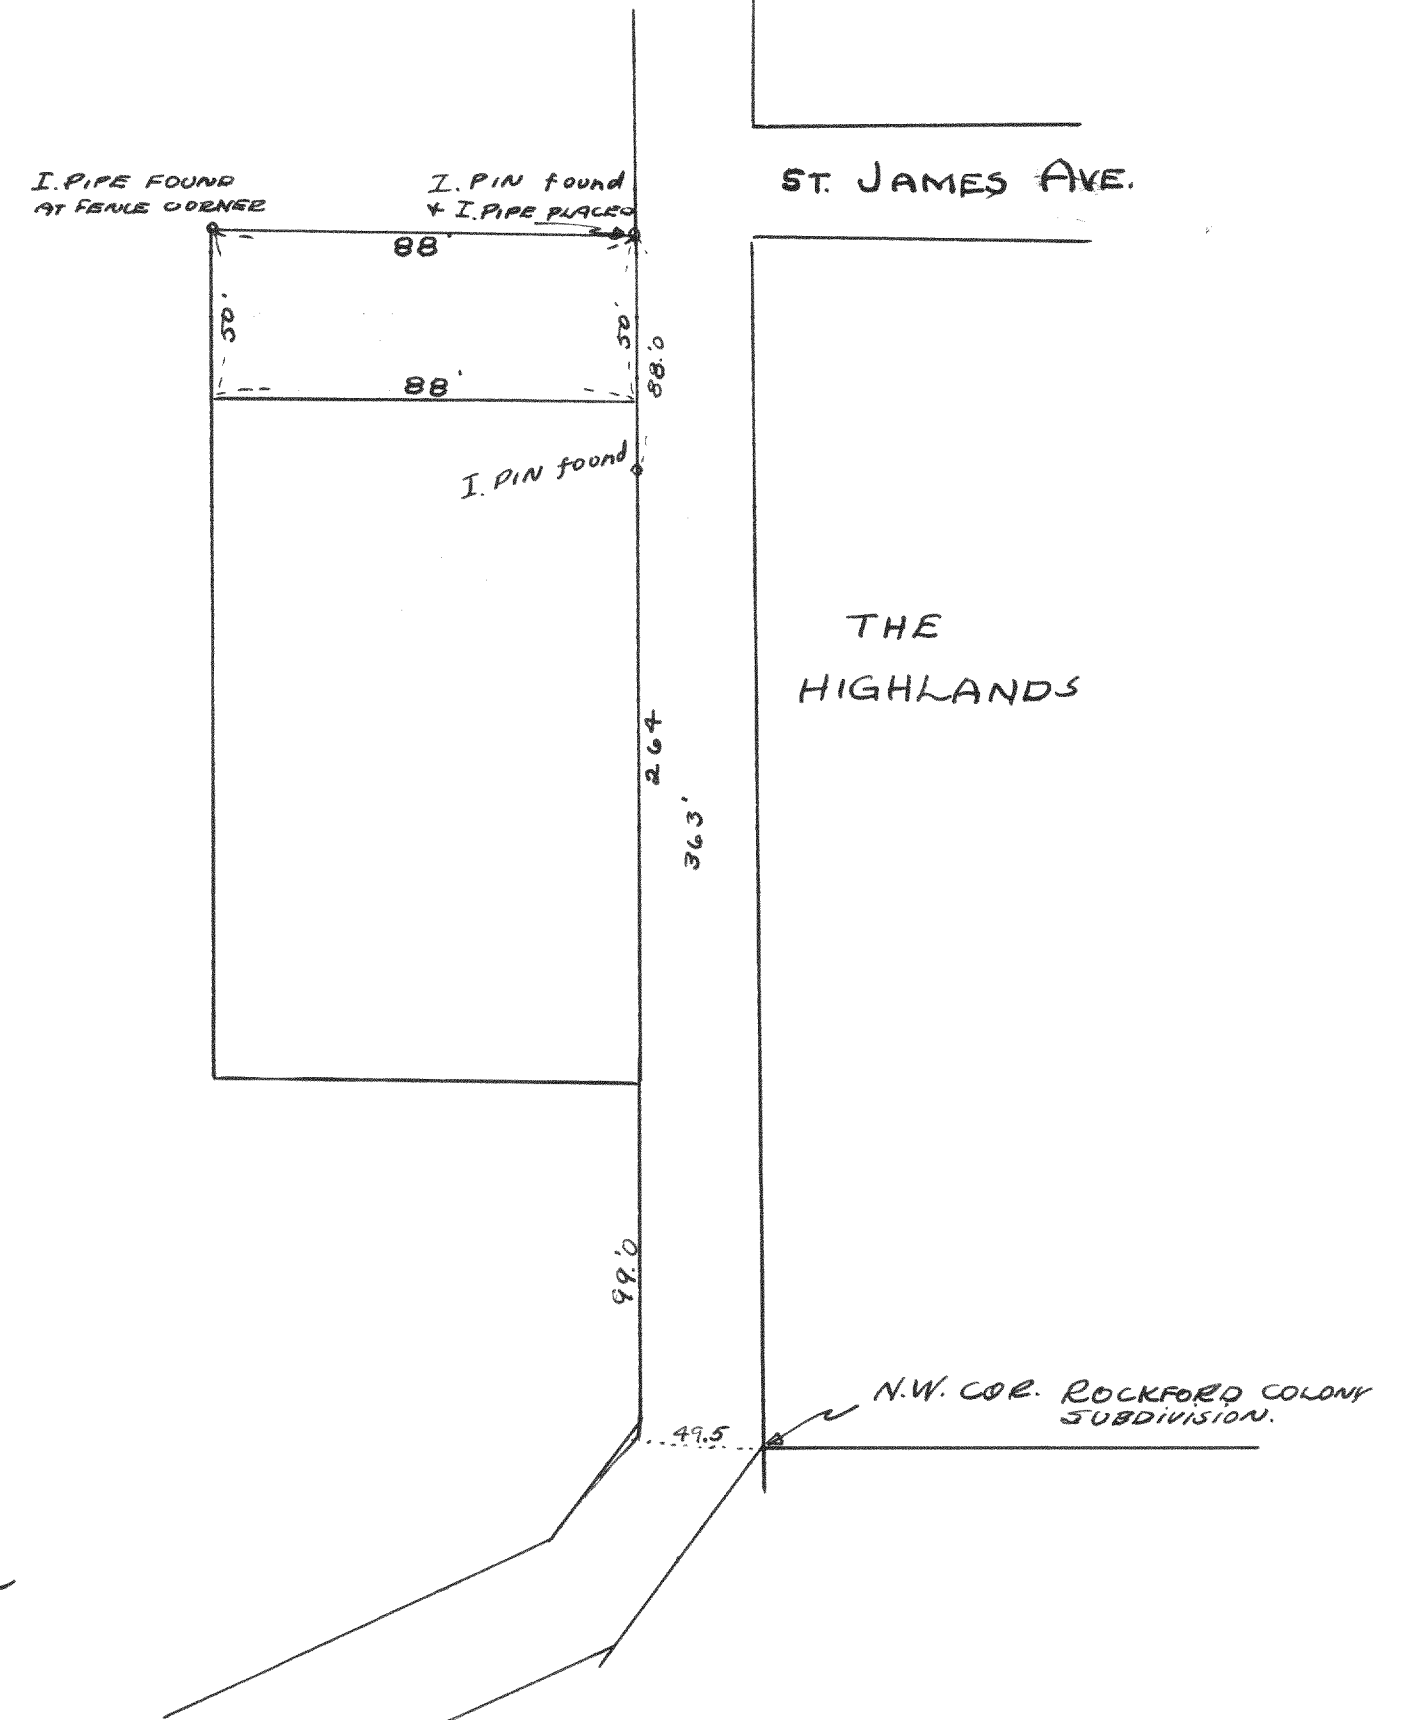

Survey of part of Highland property located in 28-2-16

11-26-37

Lloyd L. Jensen
by H.E.J.

271