


No 843

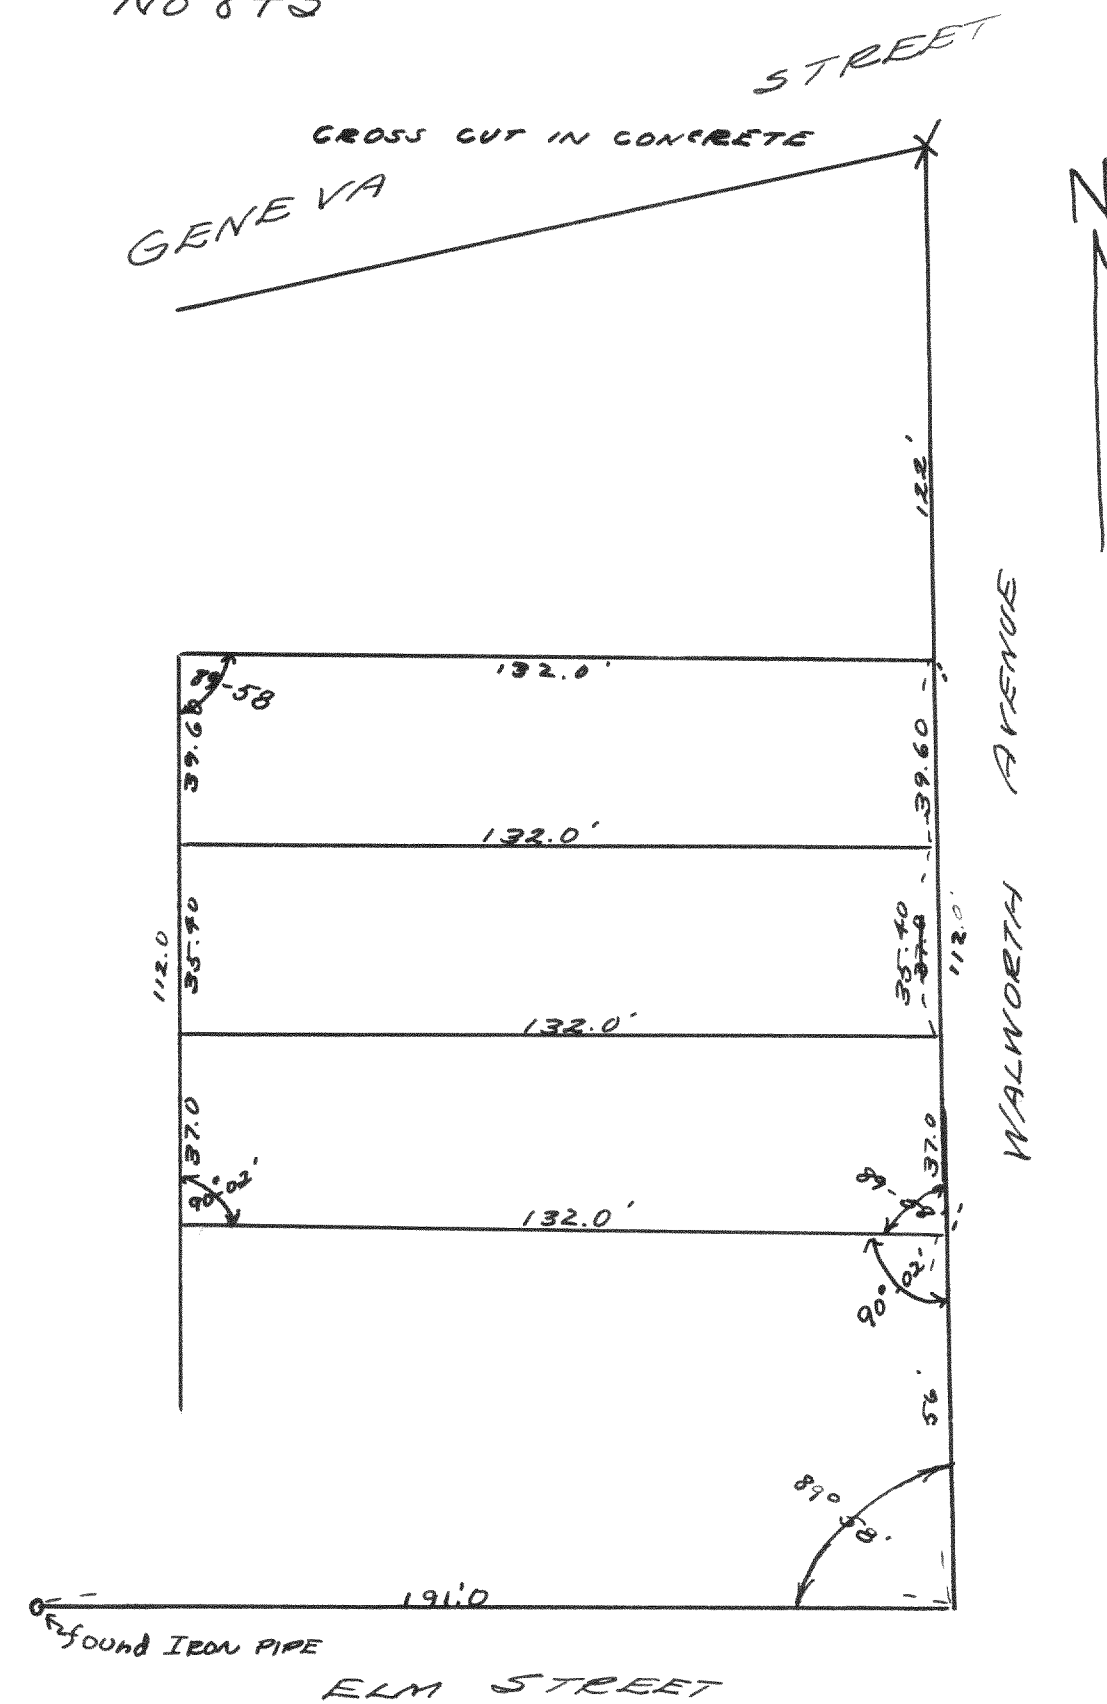


Survey of lot 1 - blk. 4 of
the original plat of Wms. Bay.

11-24+26-37

Lloyd L Jensen
by H. E. J.

No. 844

LAKE

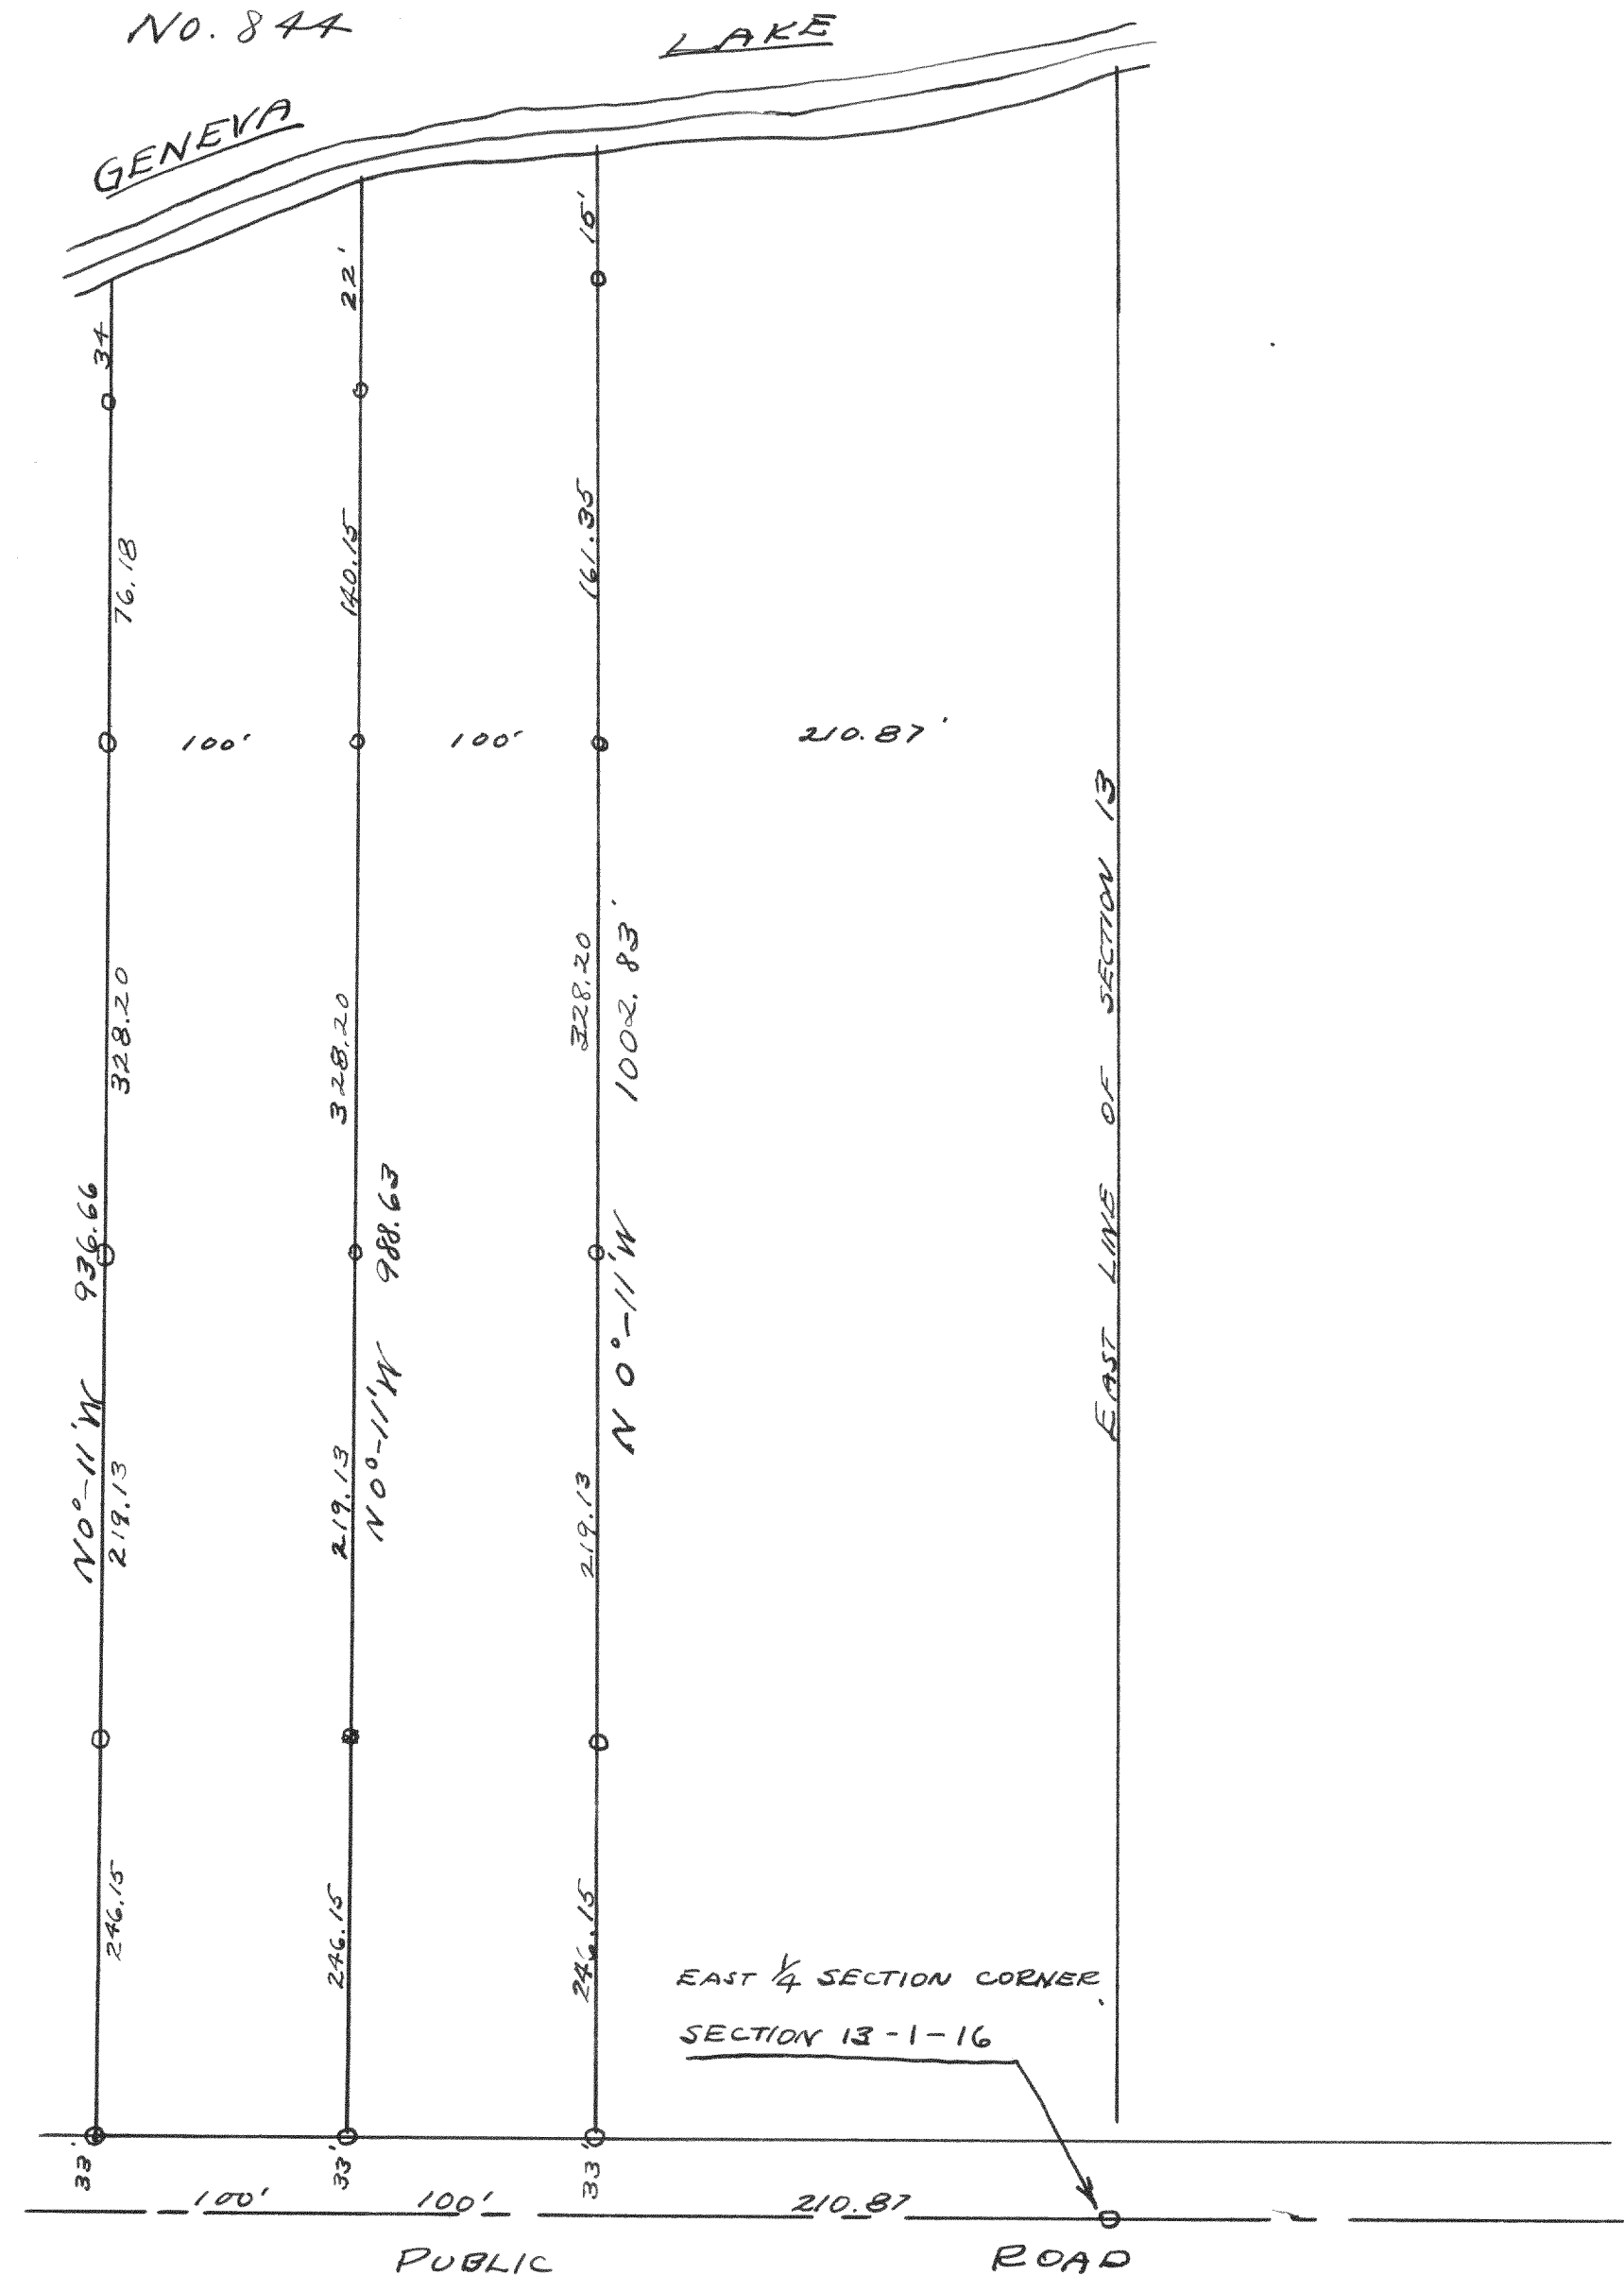

Survey of part of section 13-1-16
April 1938 Lloyd L. Jensen by N.E.P.