


NO. 854 -

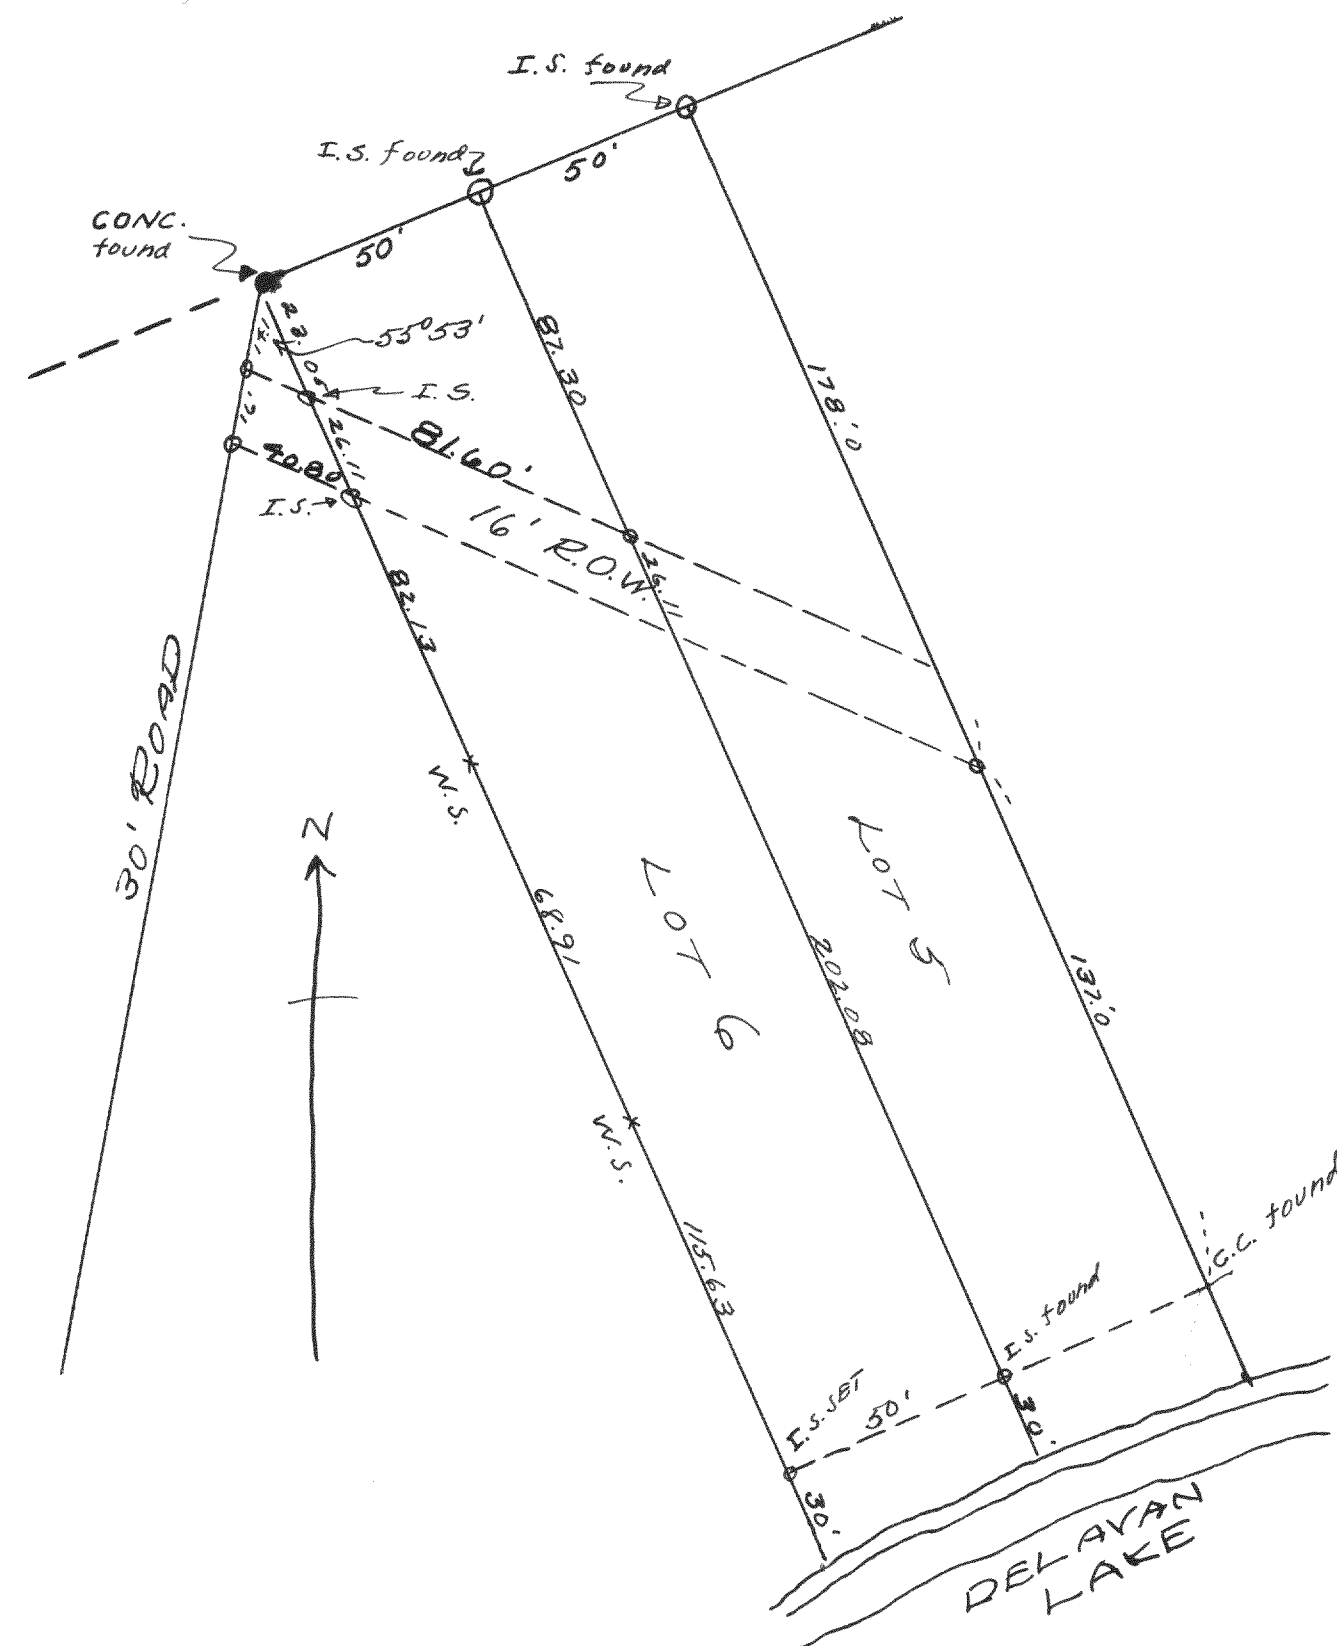


Survey of lot 6, Willow Point Park
Delavan Lake

April 15, 1938

Lloyd L. Jensen
by H. C. J.

NO. 855

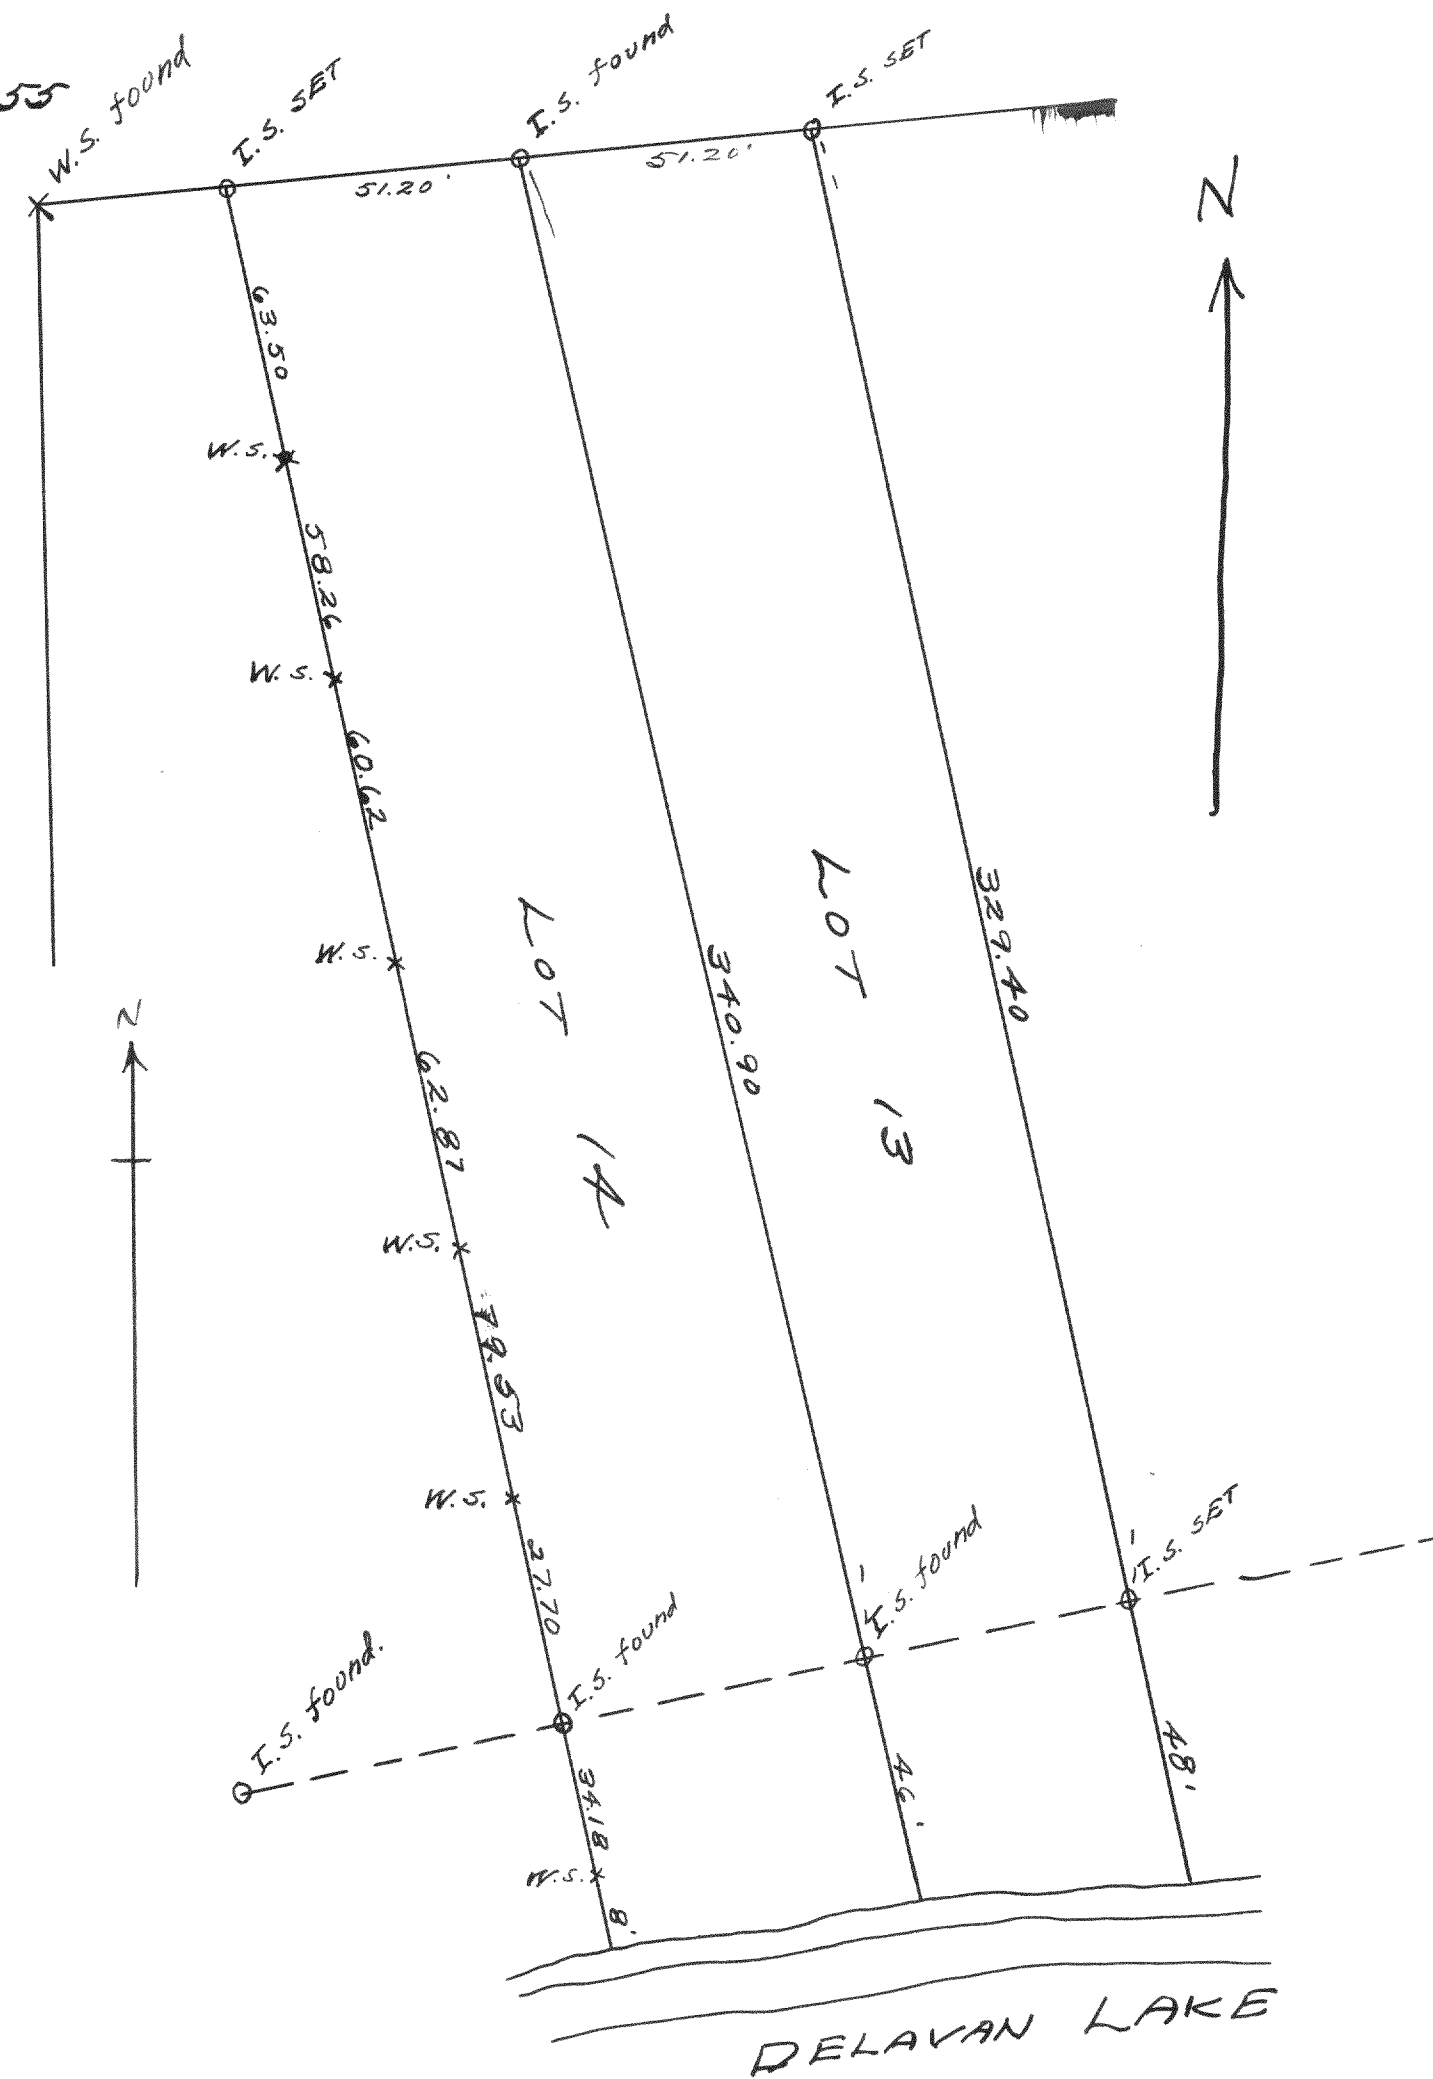

Survey of lots 13 & 14, St
Mary's Subd. Delavan Lake

April 11, 1938

Lloyd L. Jensen
by H. C. J.