


No. 859

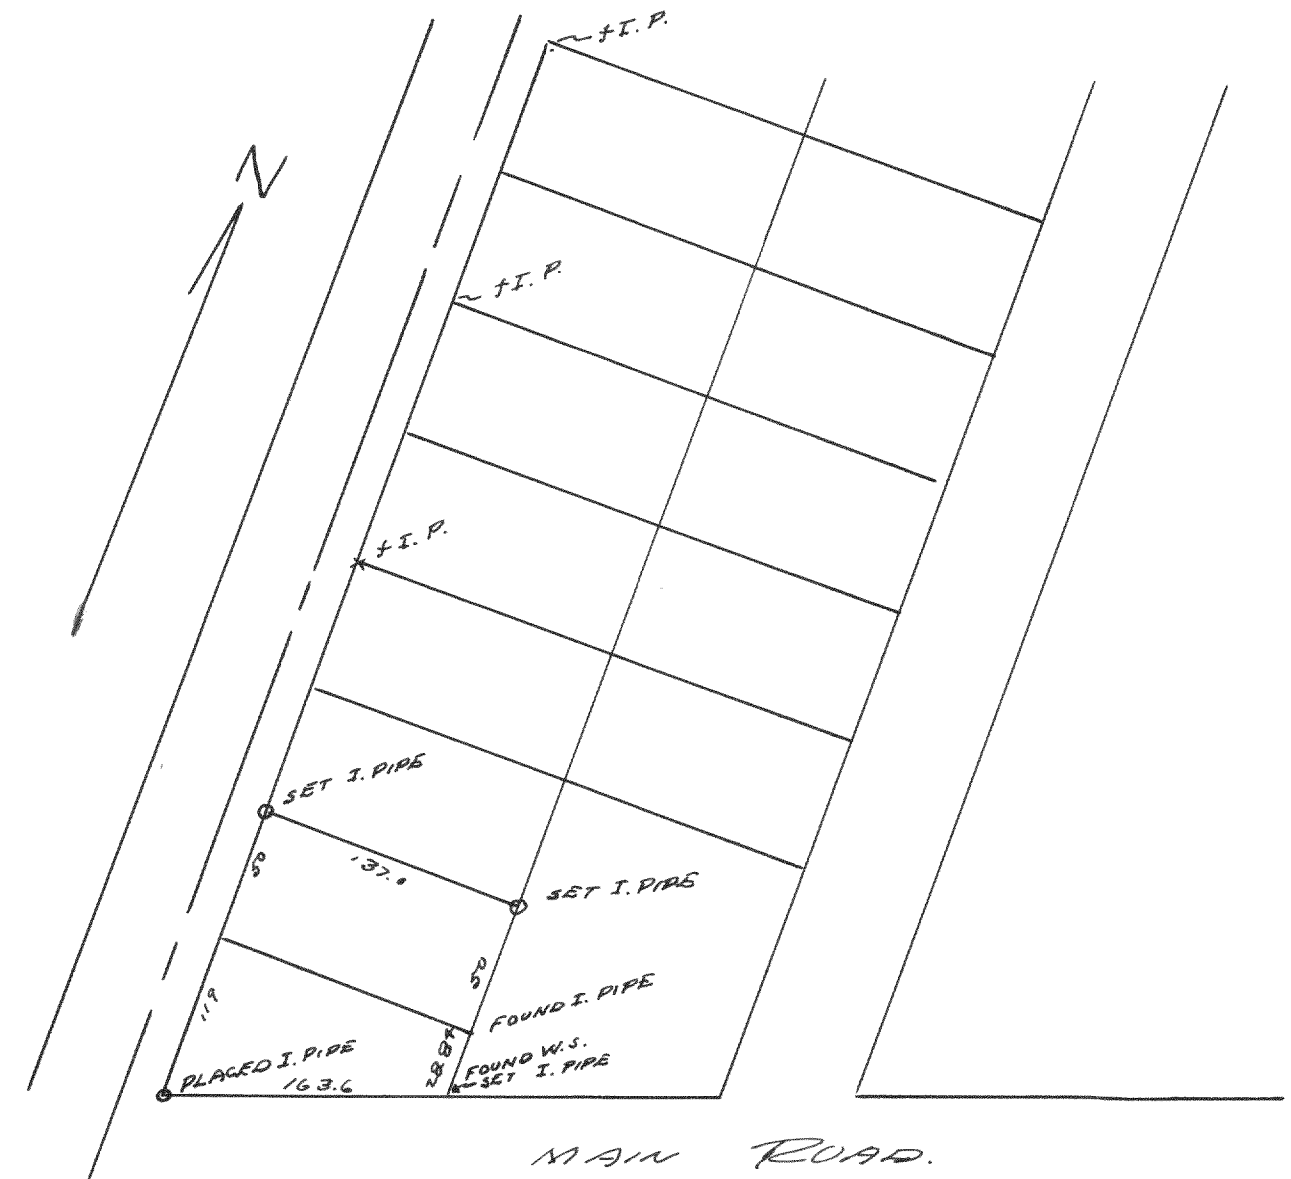


Survey of lots 52 & 53 of Lake View Subdivision.

August, 1937

Lloyd L. Jensen
by H.E.G.

No. 860

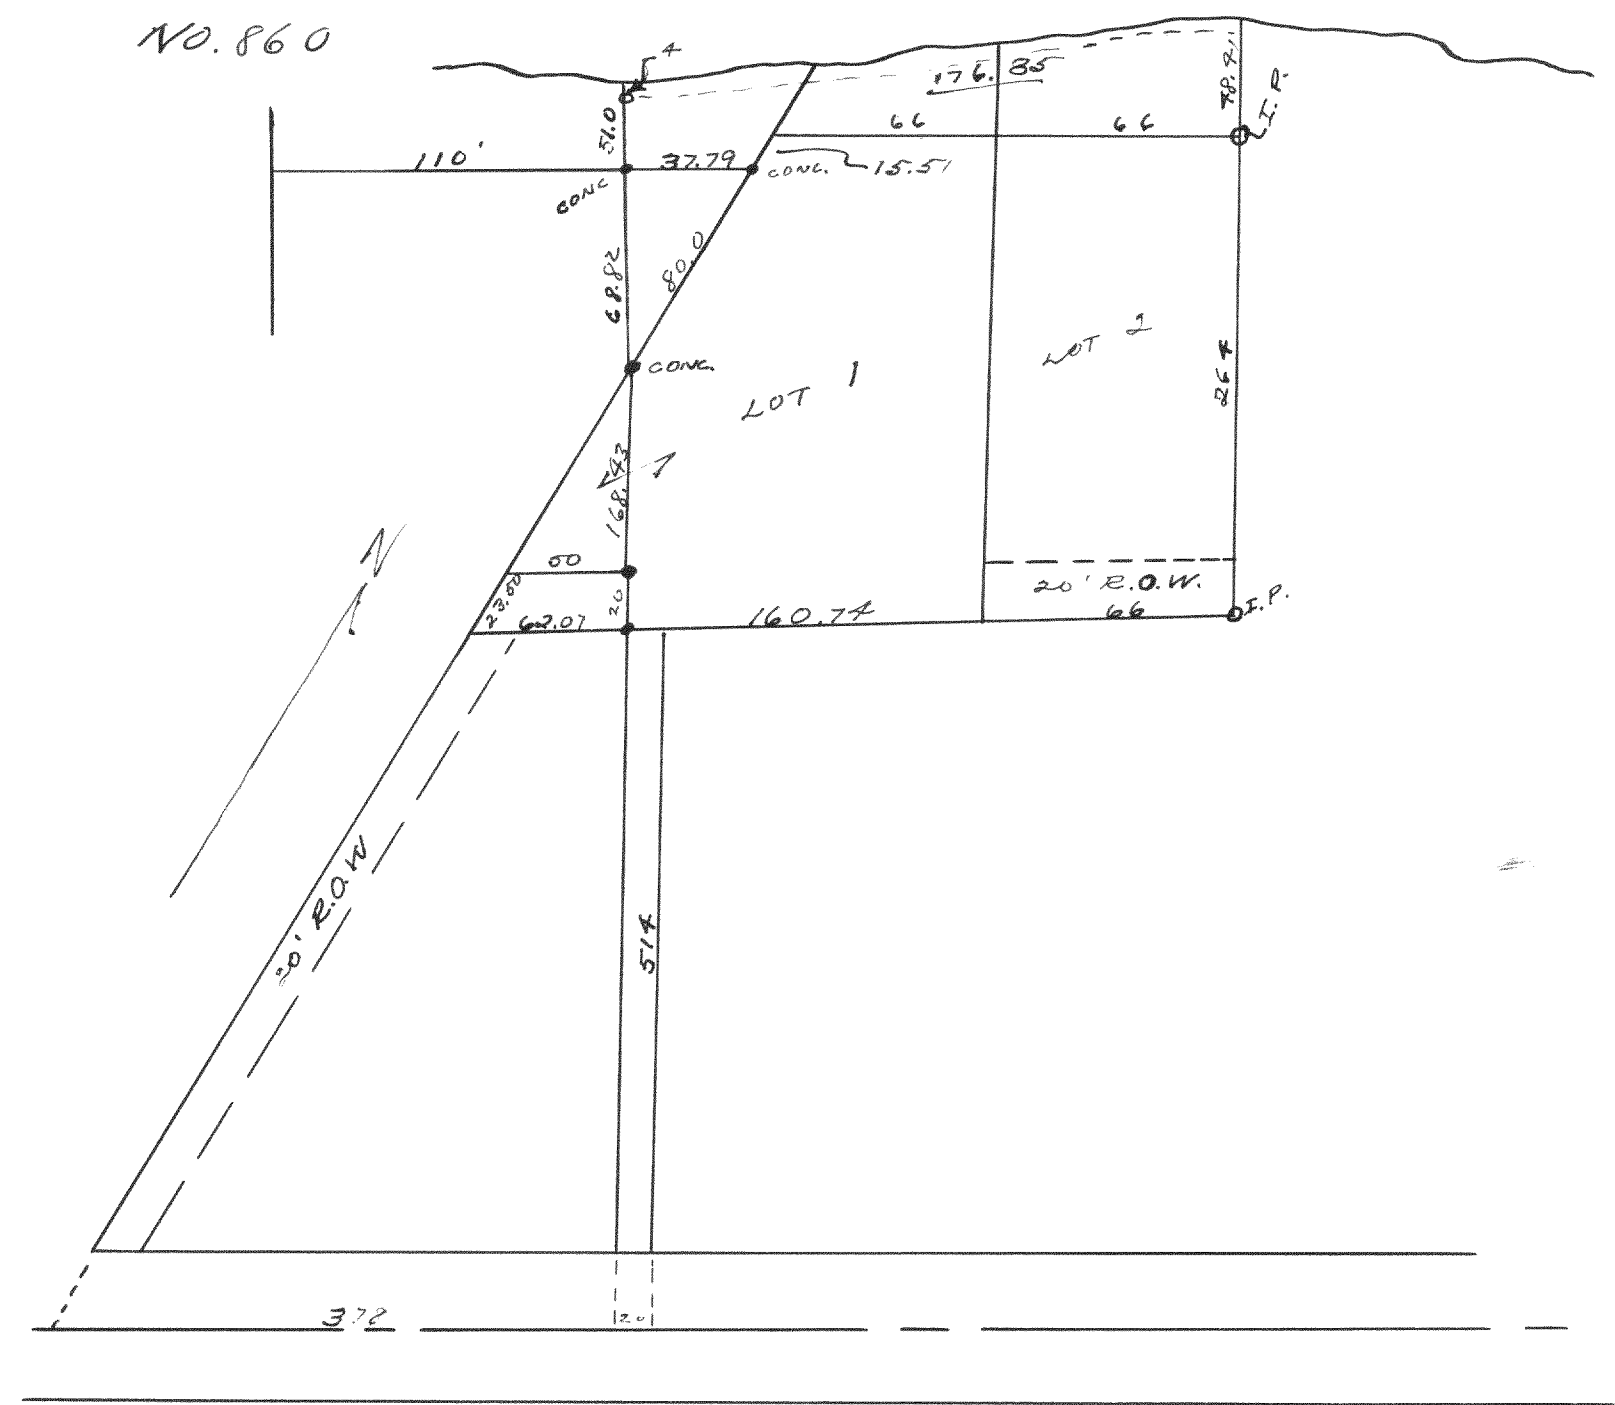

Survey of lot 2, part of lot 1 of Lackey's Springs Subdivision, part of lot 1 of Sunset Bluff and R.O.W.'s located in 32-2-16

Nov. 1937

Lloyd L. Jensen
by H.E.G.