




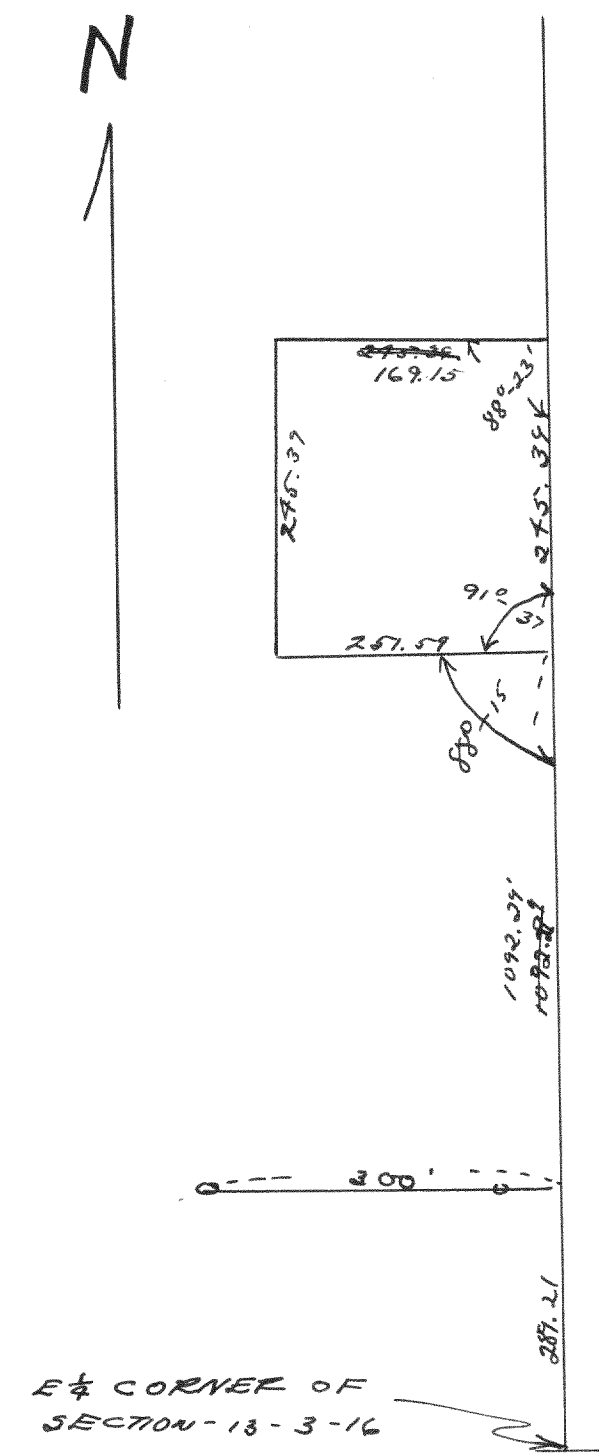

Survey made in section 13-3-16
Lloyd Jensen
by H.E.J.
Nov. 1937

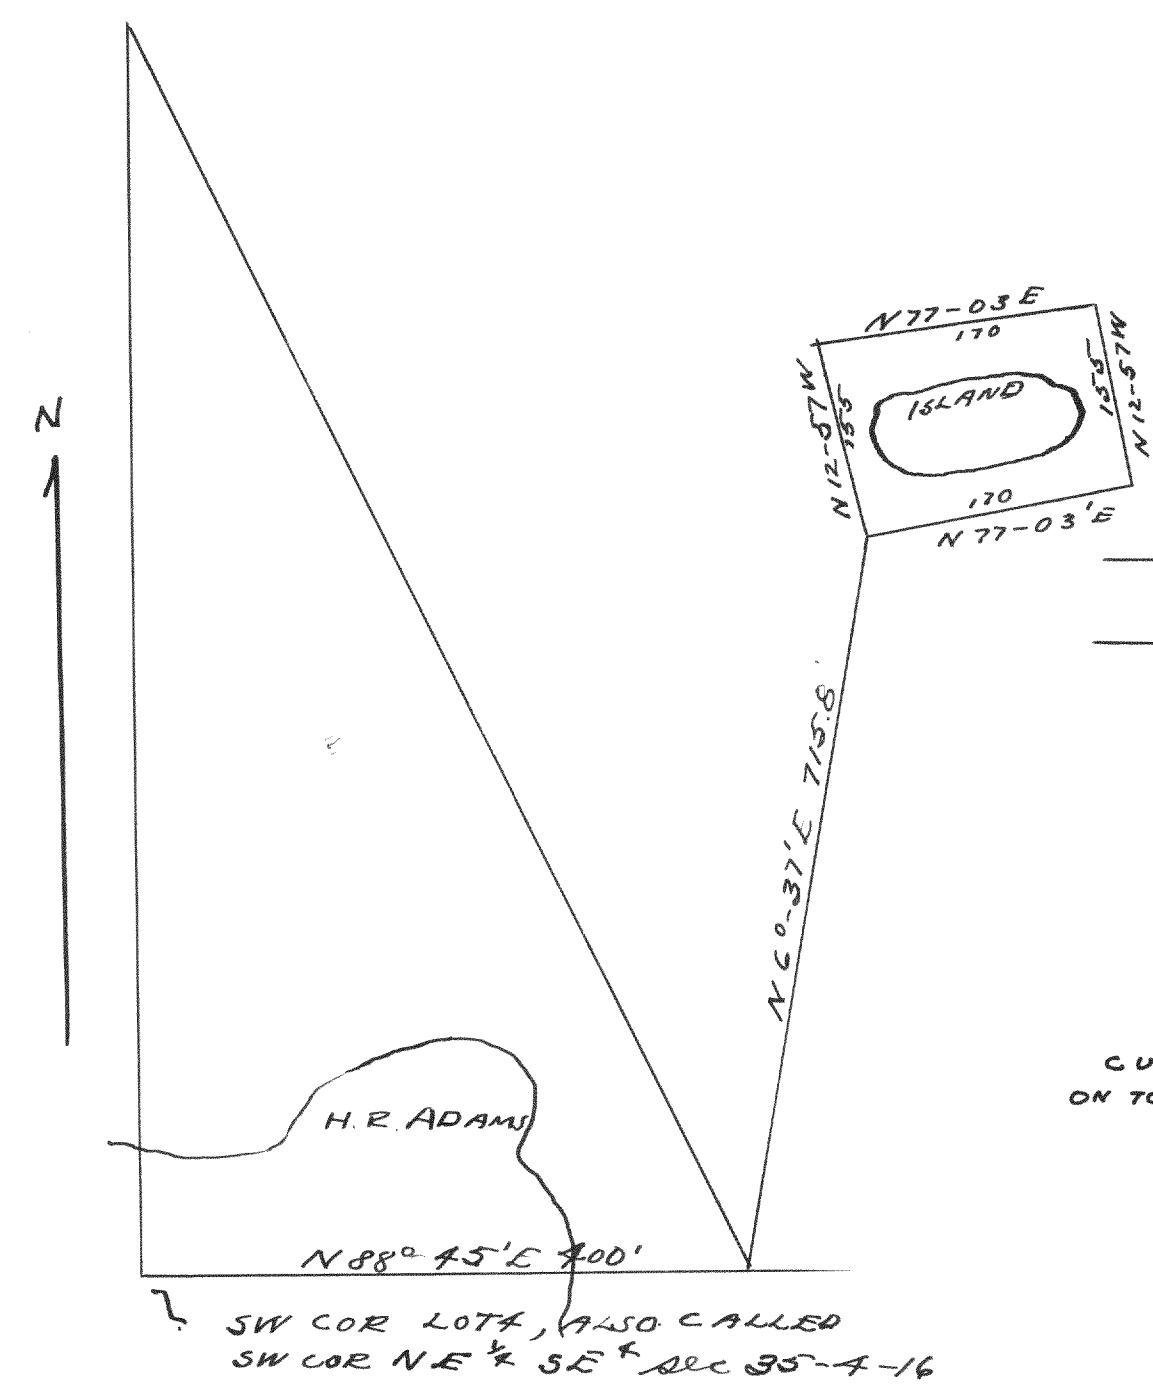

Survey of Island in
sec 35-4-16 - known
as Goose Island
Feb. 1938
Lloyd Jensen
by H.E.J.

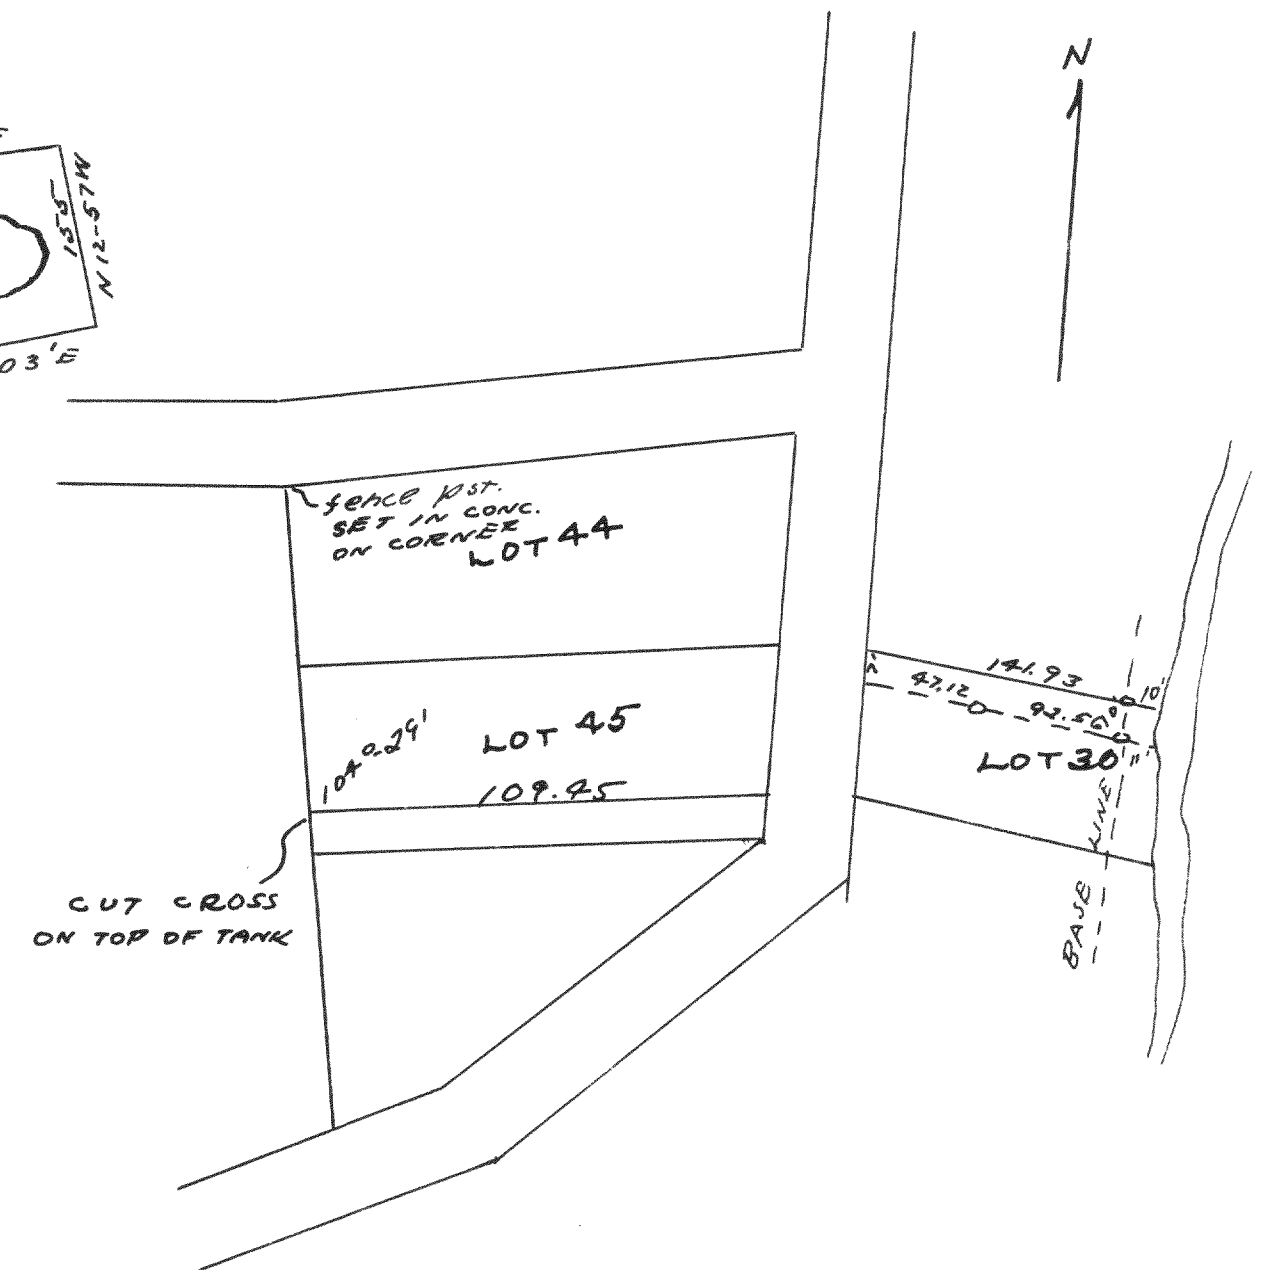

Survey of lots 44 and 45 of
Green Lake park & strips to
Lake shore
1938
Lloyd L. Jensen
by H.E.J.