


284
NO. 875

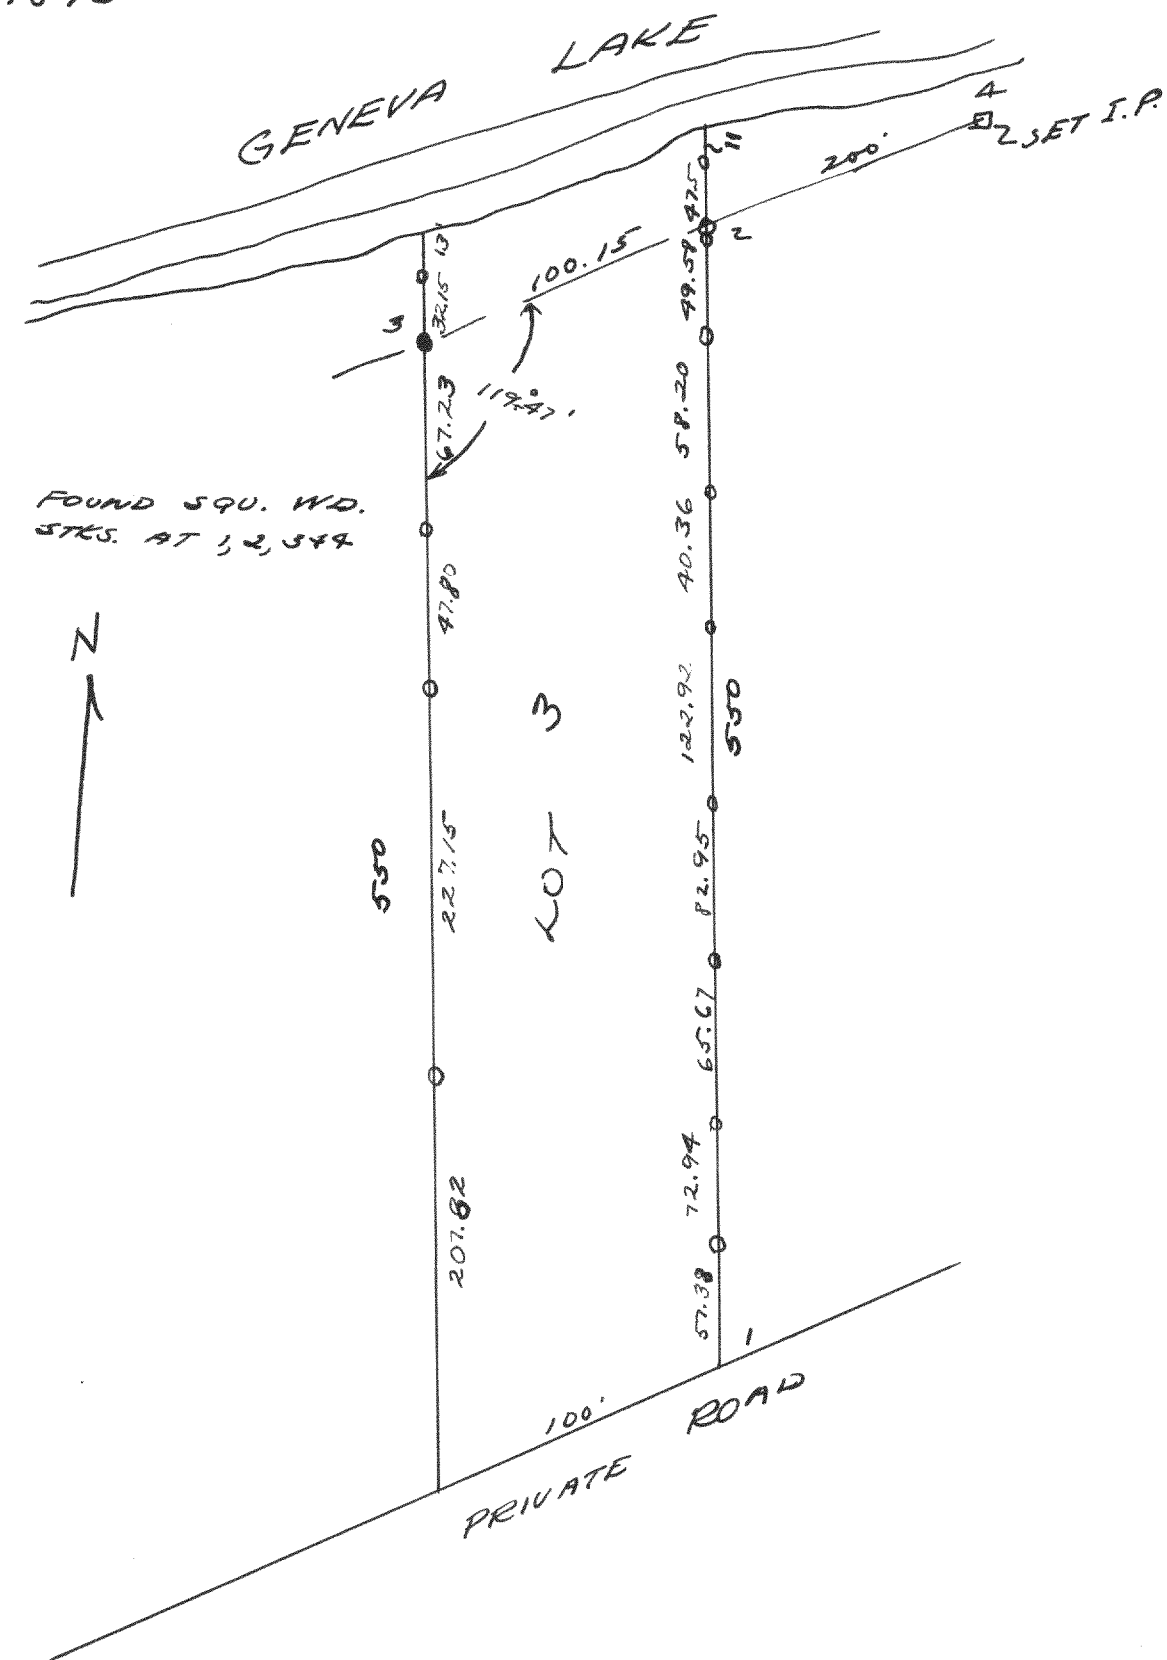


Survey of lot 3 of the Birches
Subd. in sec. 10-1-17

March 1938


Lloyd Jensen
by K.E.J.

No 876

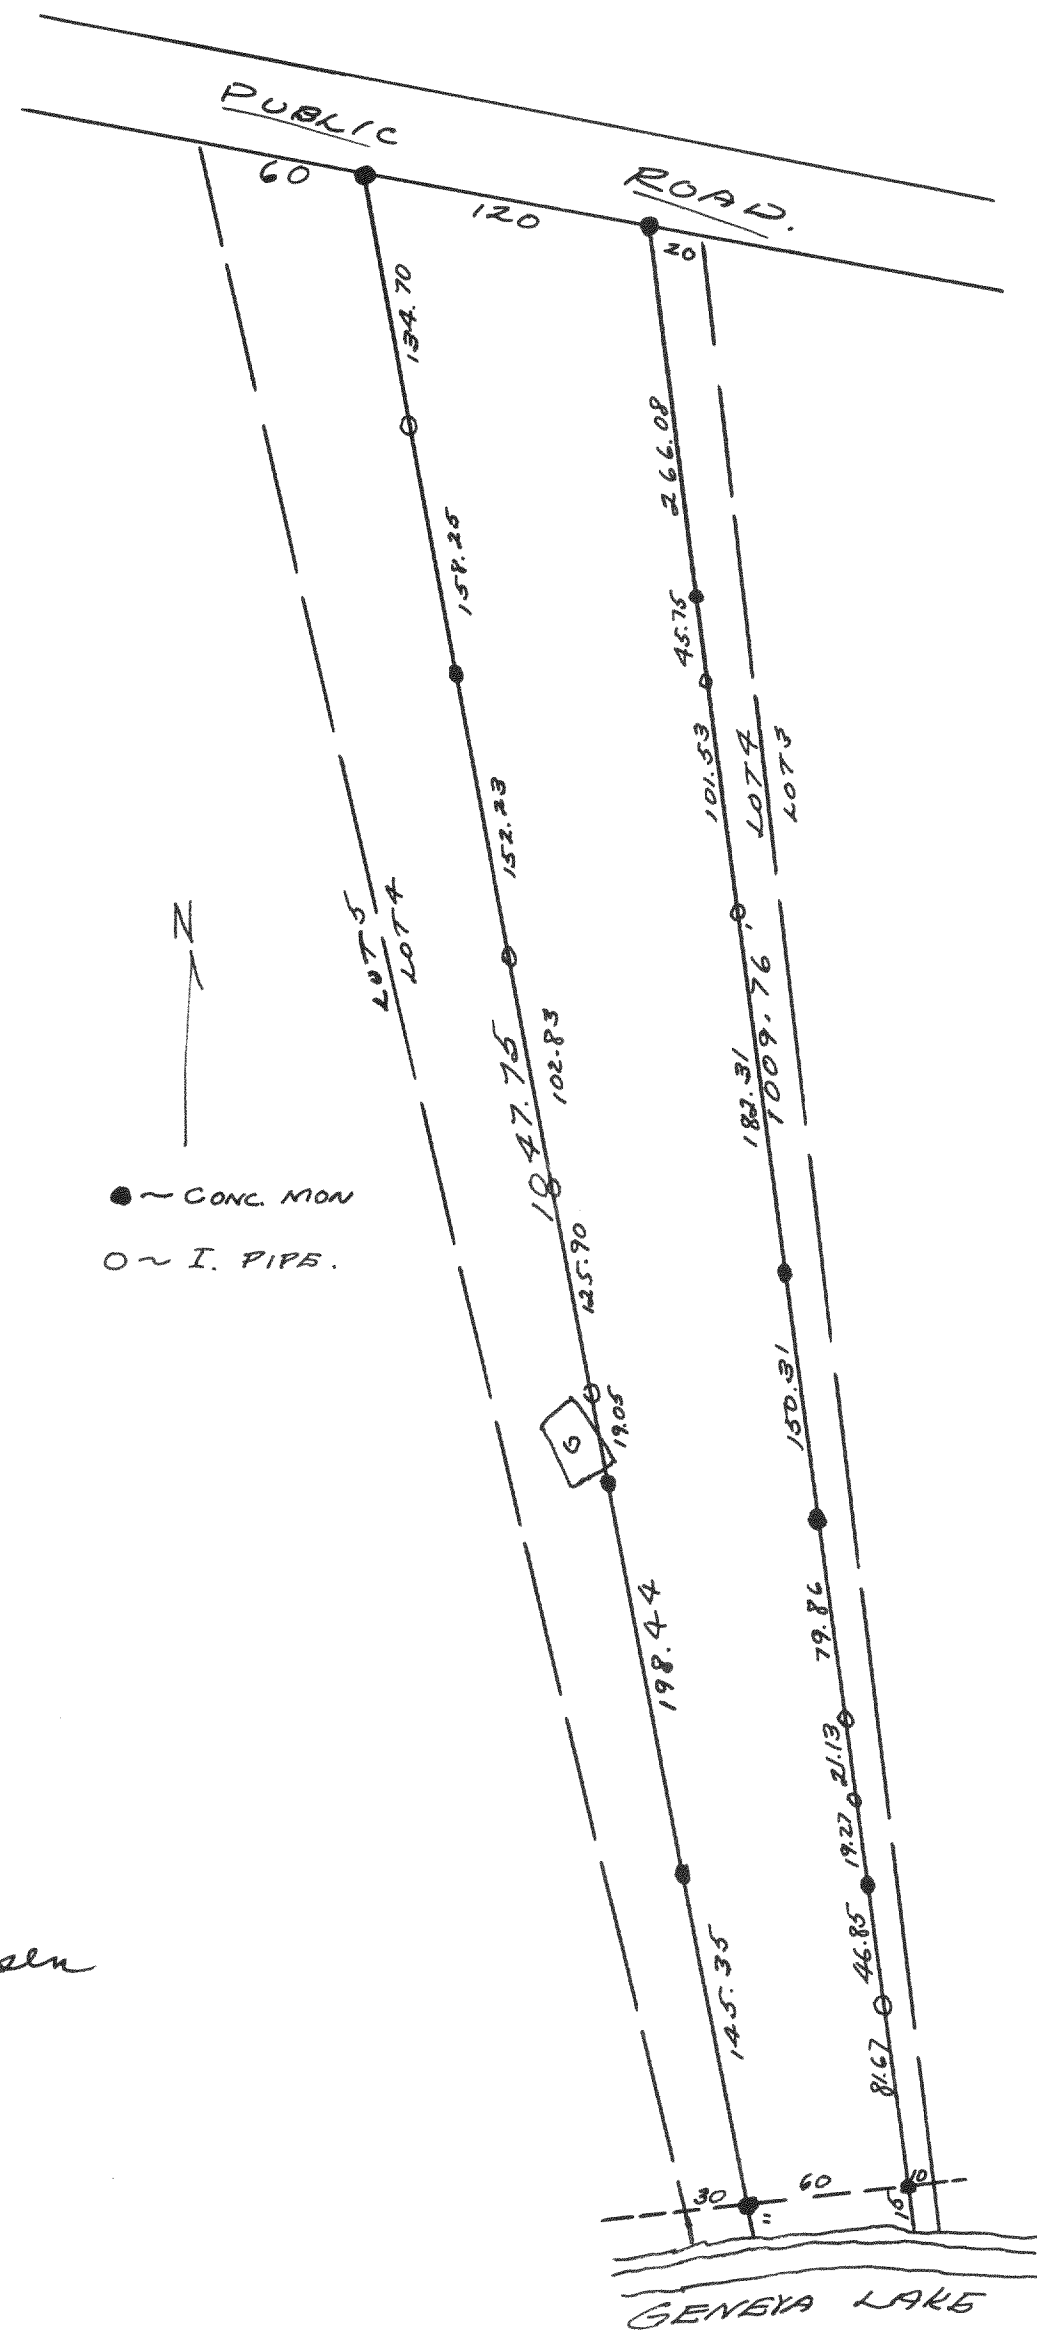

Survey of part of lot 4
of Blk. I of Rowena Park in sec. 5-1-17
Aug. 1937.
Lloyd Jensen by K.E.J.

No. 877

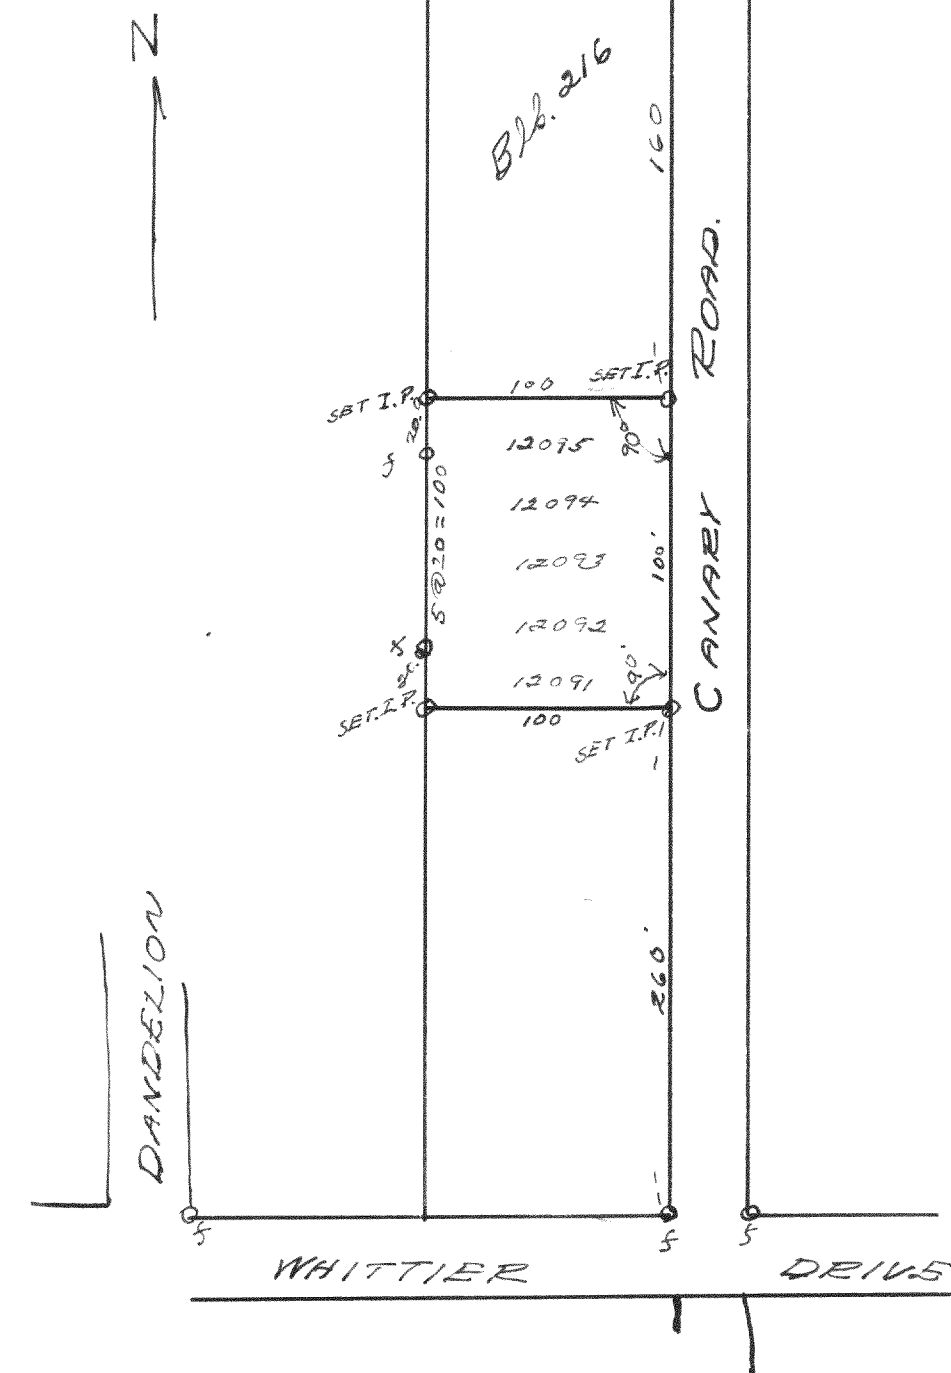

Survey of Lots 12091 to 12095
of Lake Como Beach

July 1938

Lloyd Jensen
by K.E.J.