


NO-878

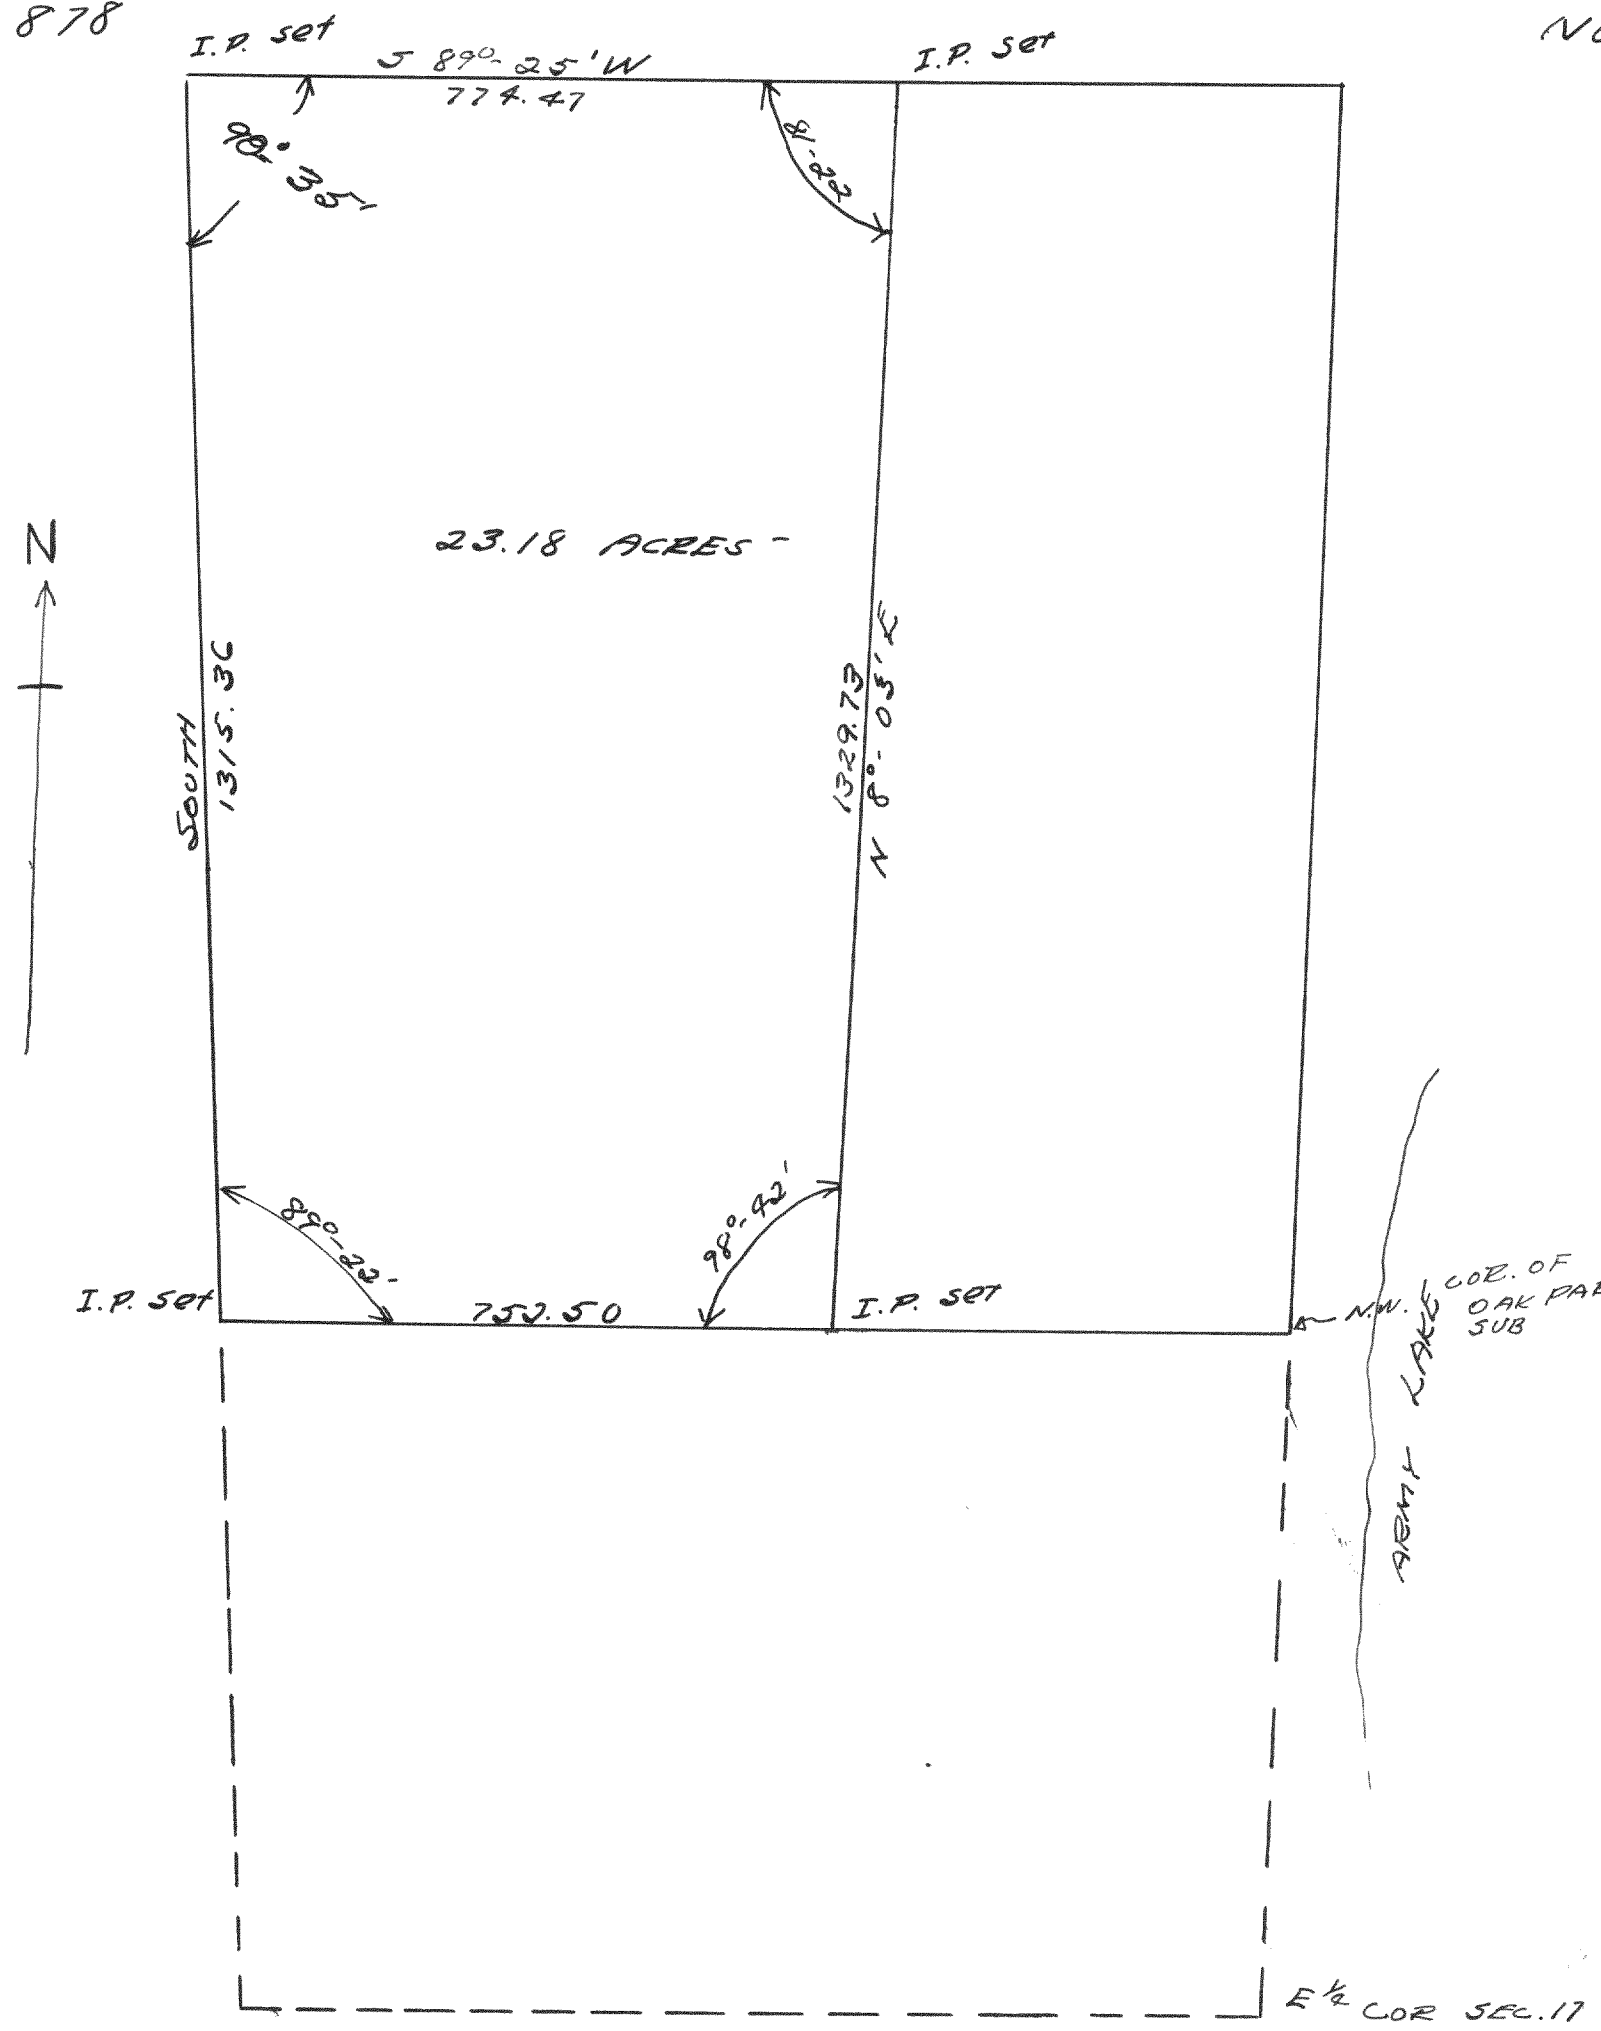


Part of sec. 17 T4N R18E

March 31, 1938

Lloyd Jensen
by K.E.J.

NO 879

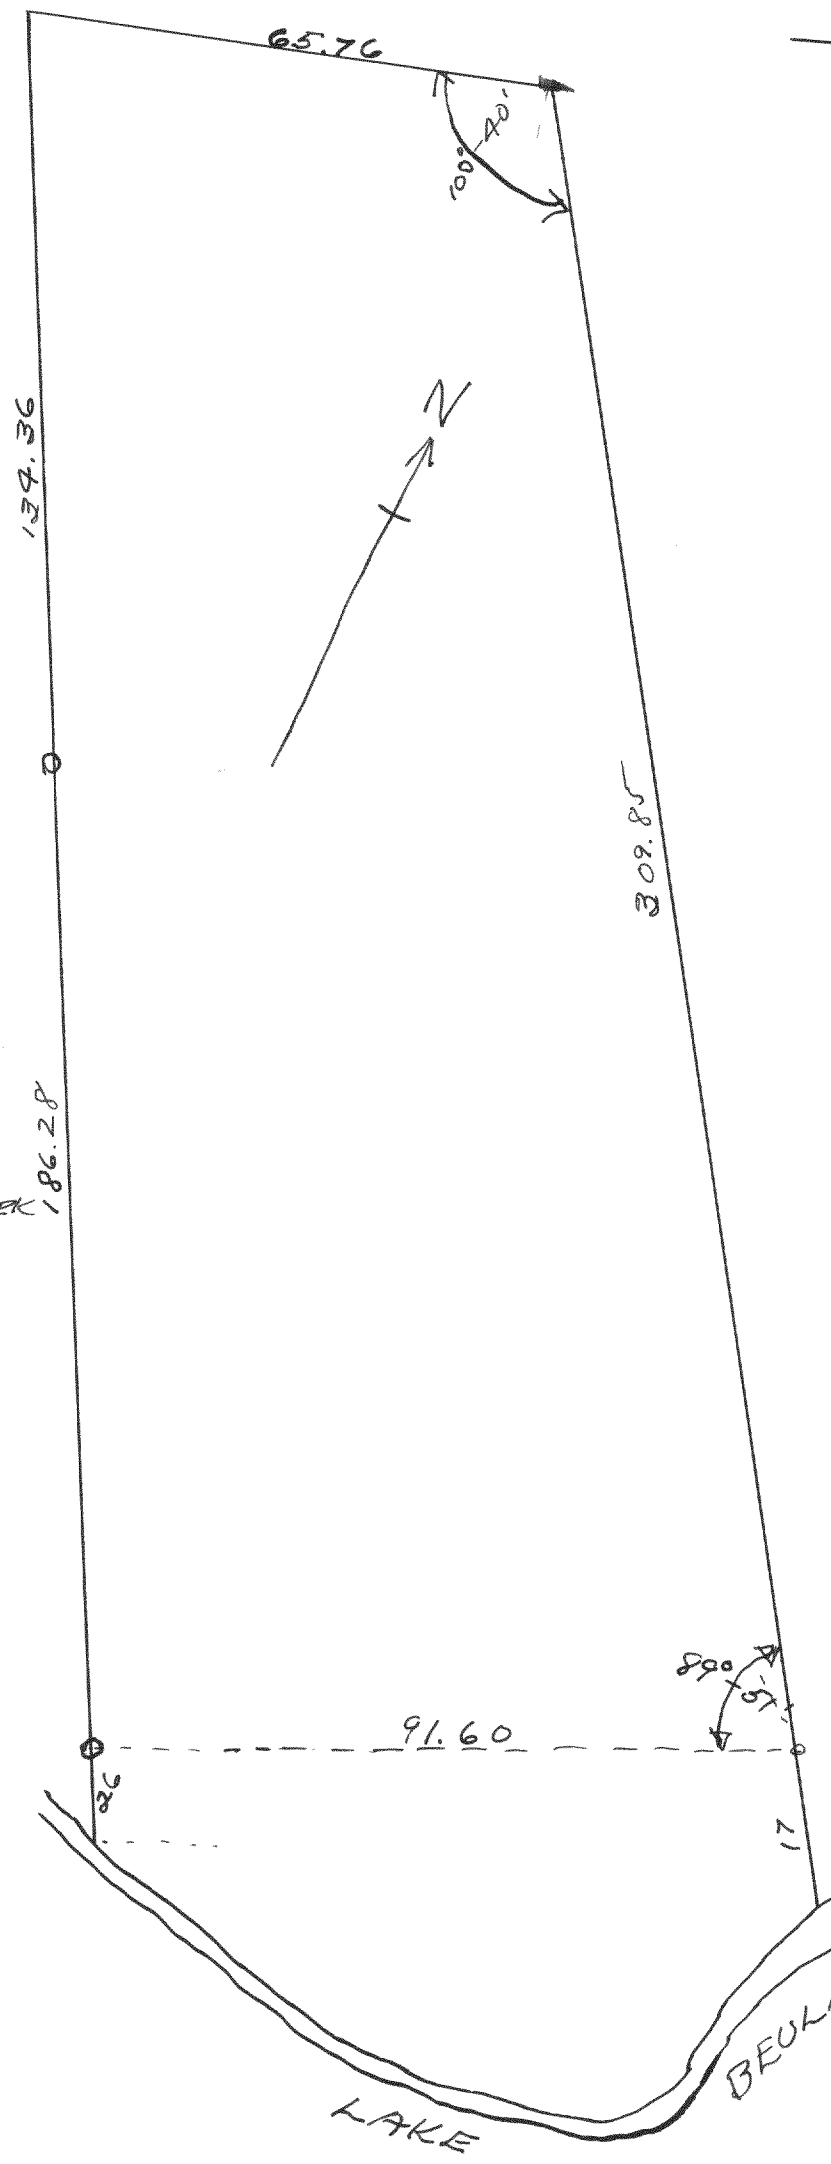


Survey of lot 8 Blk. I of Romadka Park
in sec. 5-4-18 N 8-4-18

July 17 - 1938

Lloyd Jensen
by K.E.J.

NO. 880

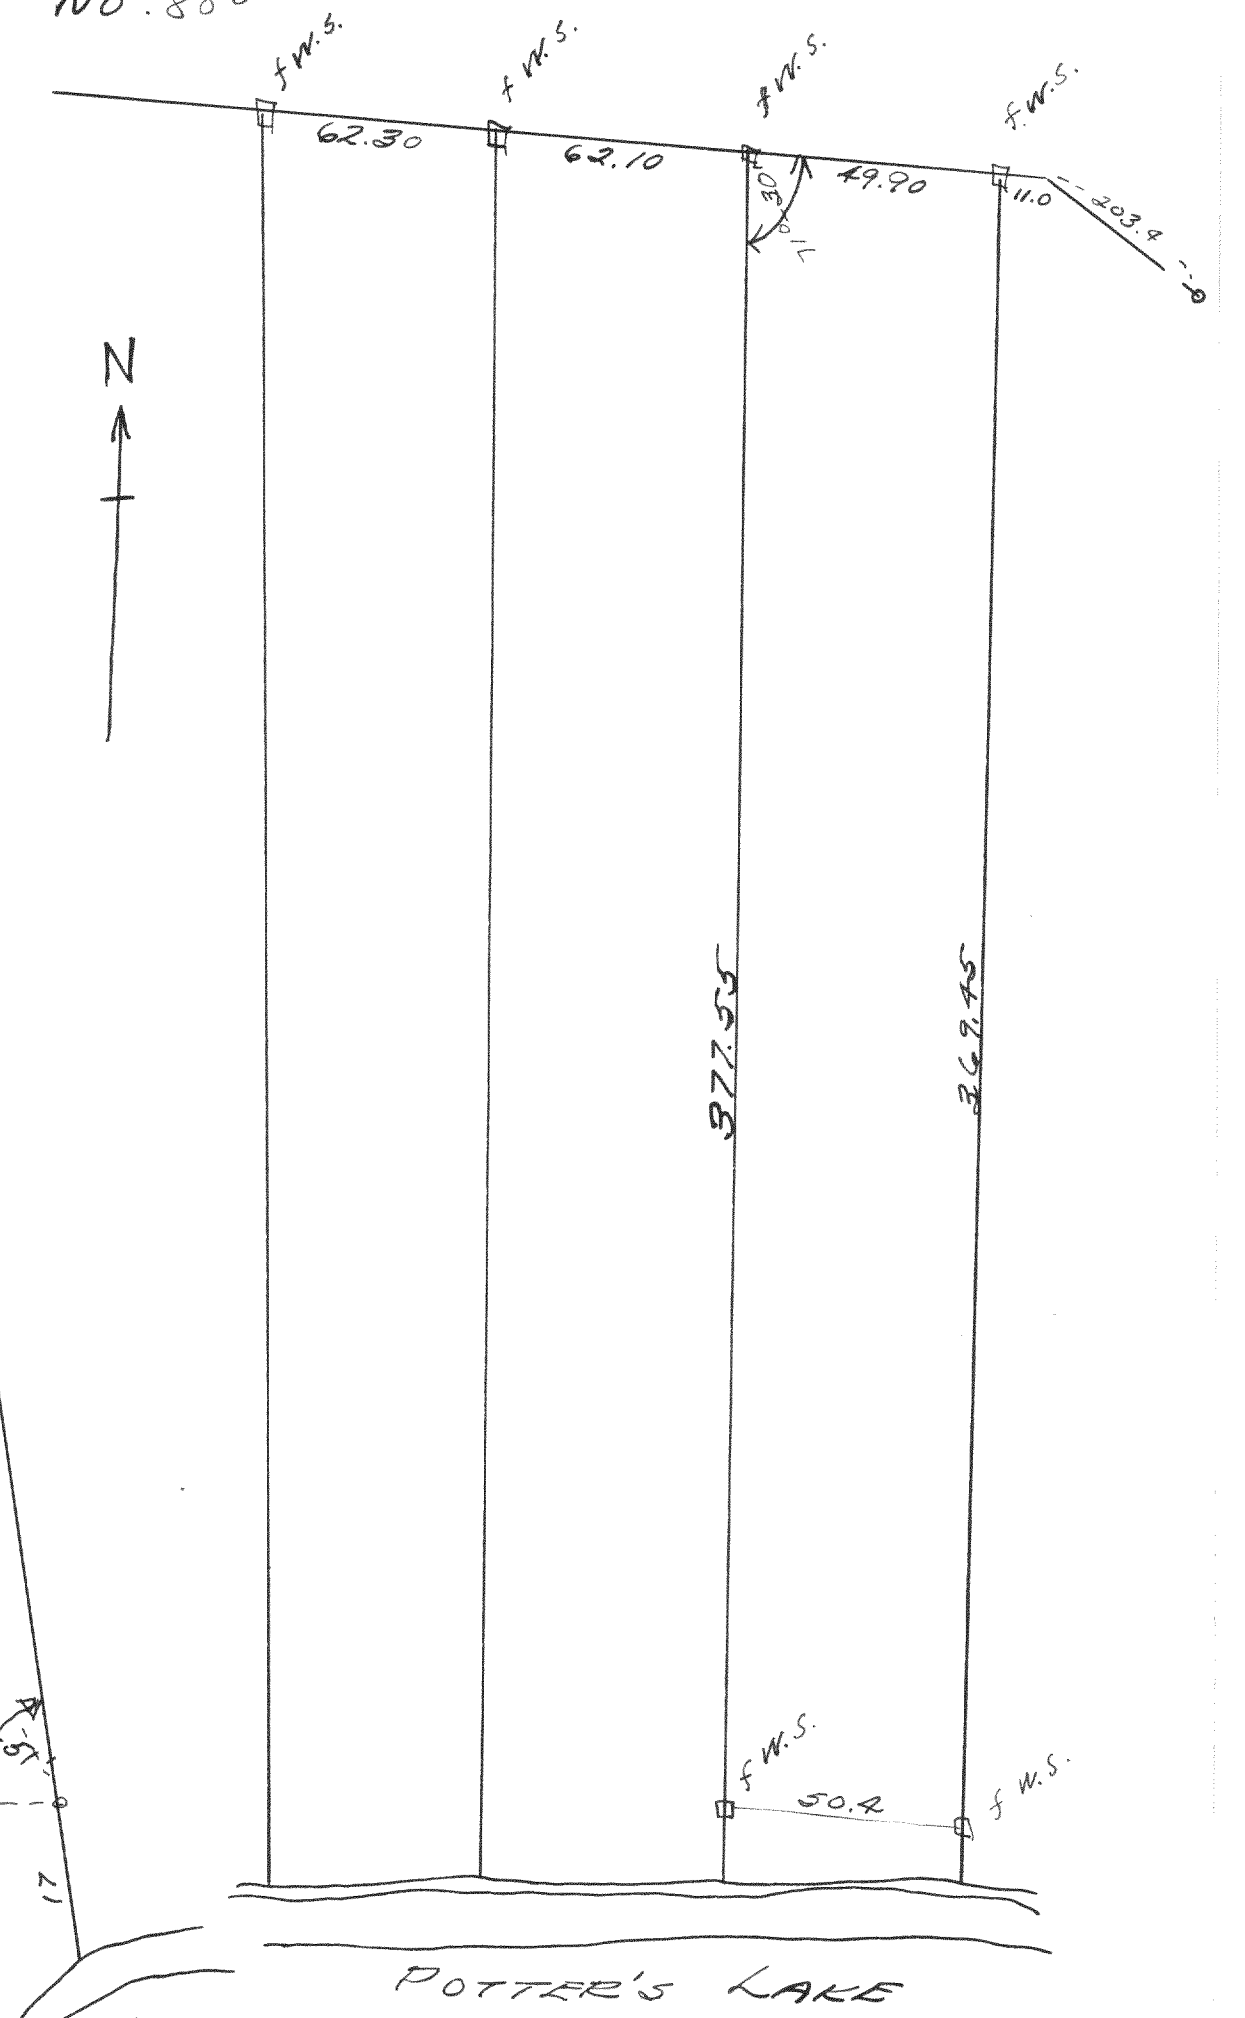

Survey of lot 23 Blk. I
Miramar Subd. T4N R18E

7-18-38

Lloyd Jensen
by K.E.J.