



No. 884

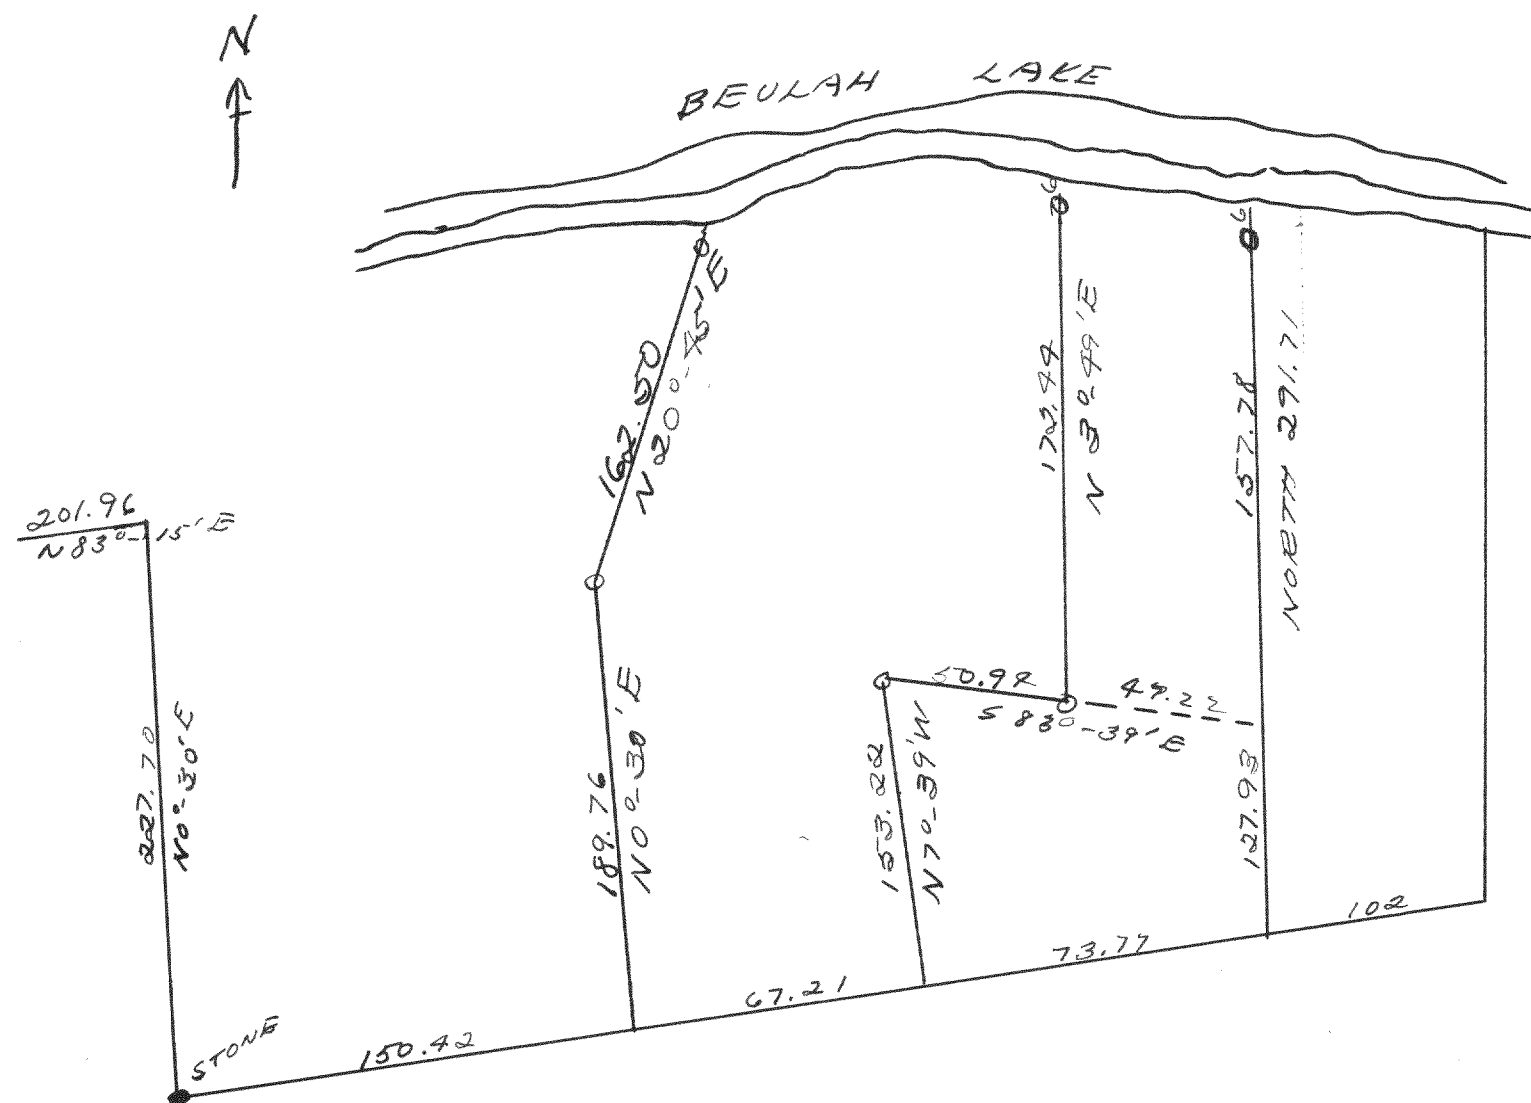

Survey of part of sec 9-4-18
Oct. 17, 1938
Lloyd Jensen
by K.E.J.

No. 885

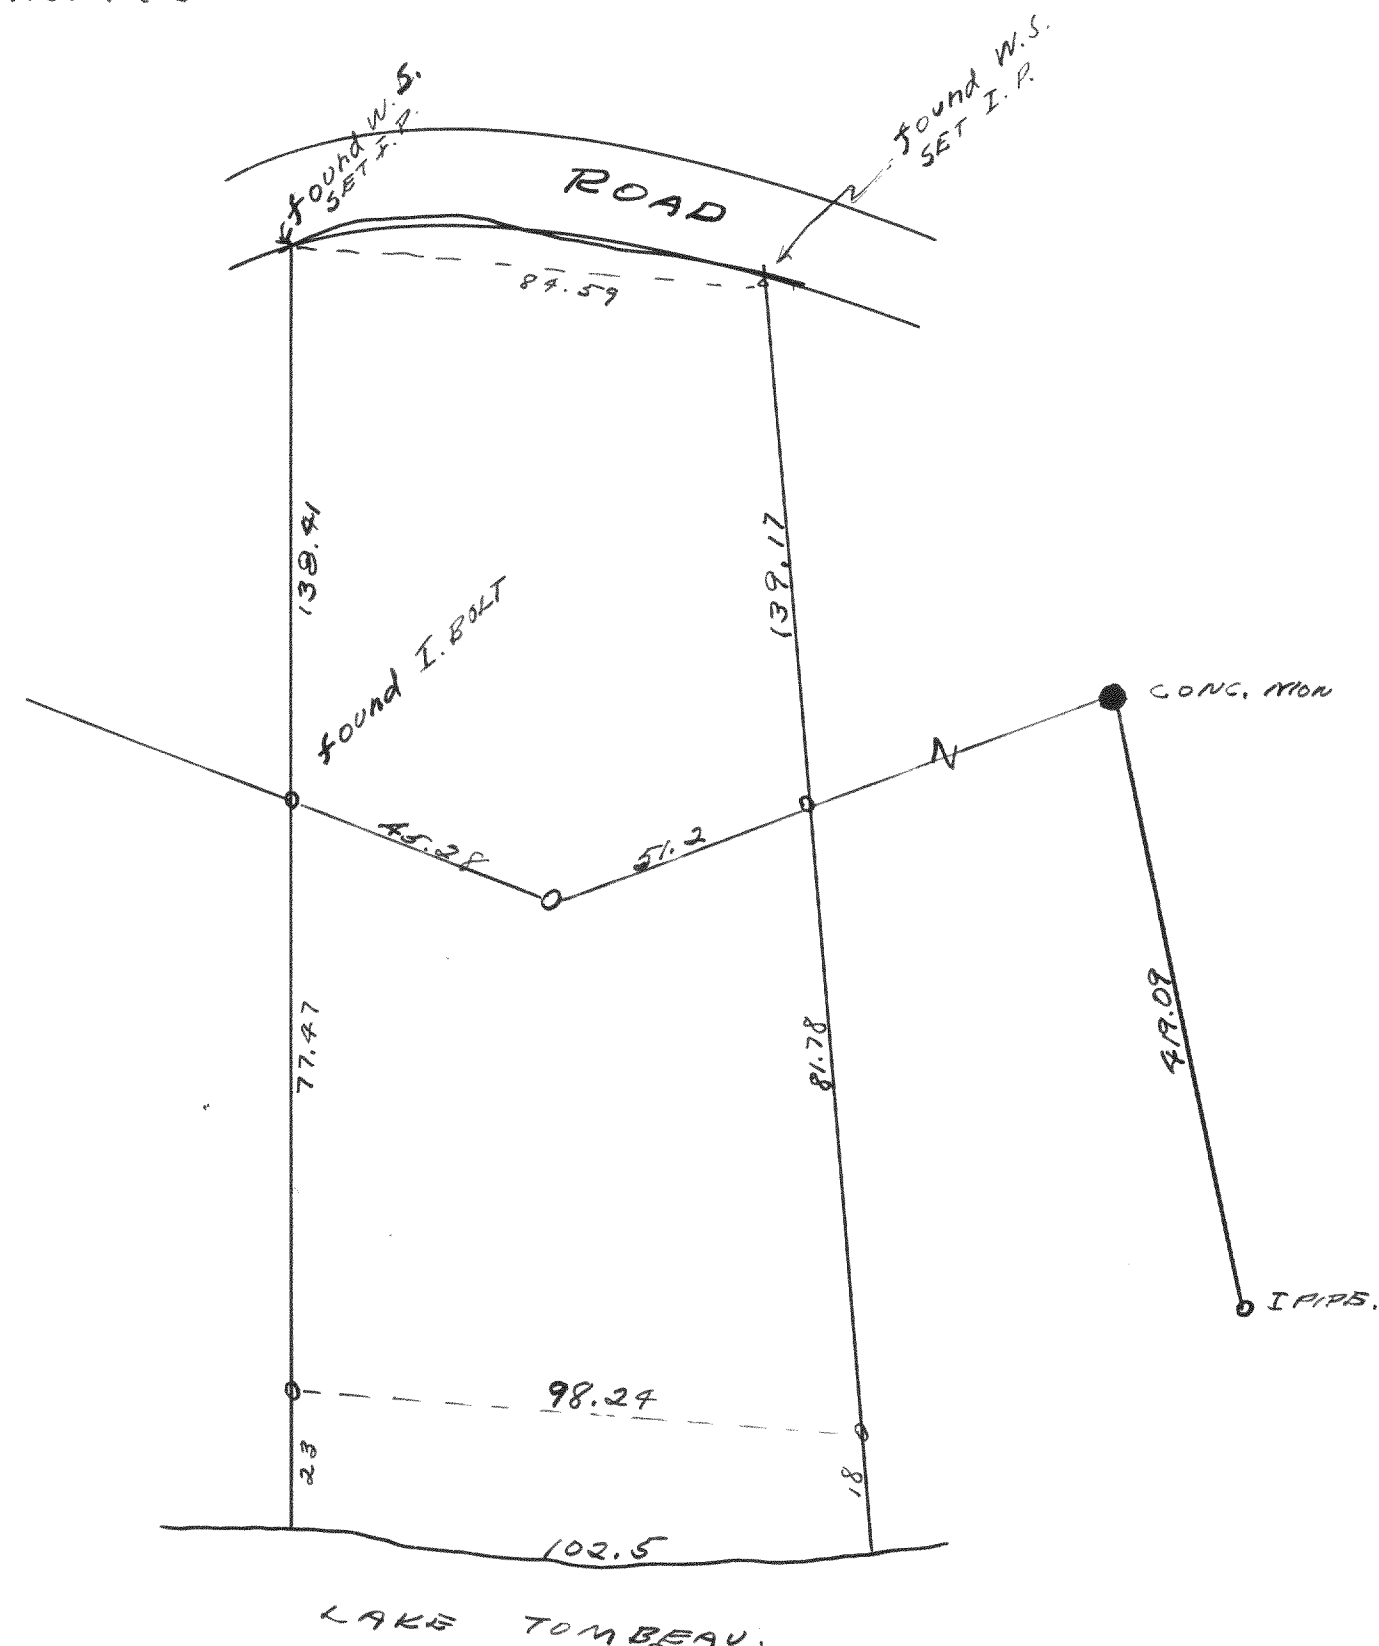

Survey of lot 2 Blk. I Nipperville Park - TINKER
7/6/38
Lloyd Jensen
by K.E.J.