


No. 893

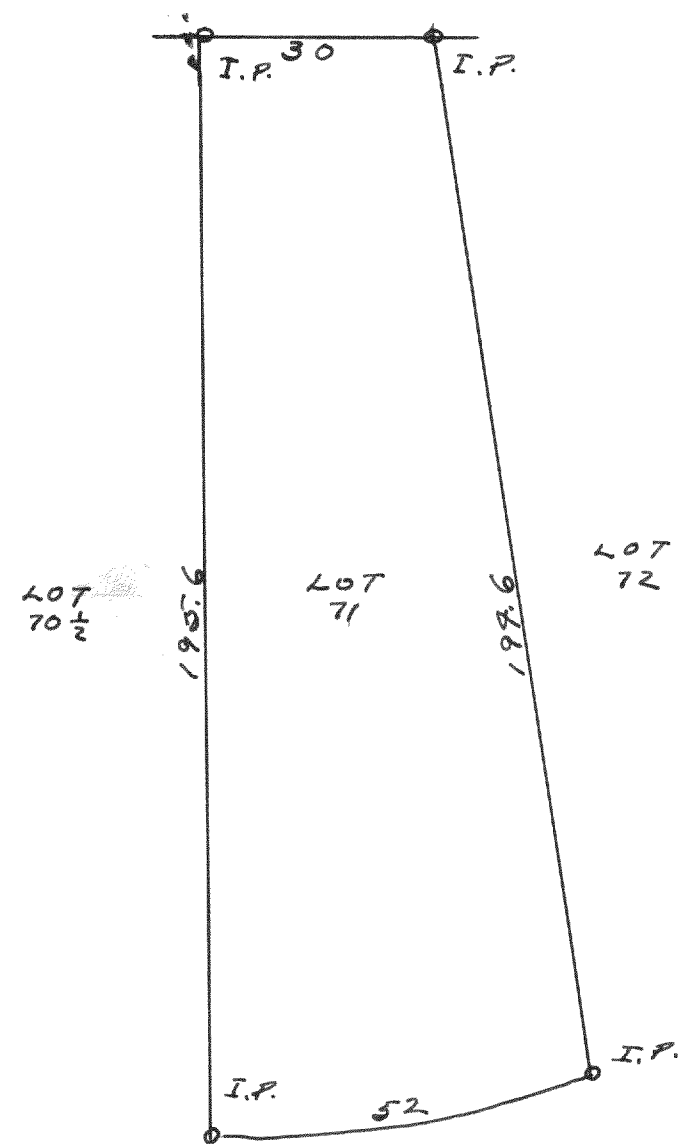


Survey of lot 71 of first add.
to Cedar pt. Park.

1938
NO DATE

Lloyd L. Jensen

No. 894.

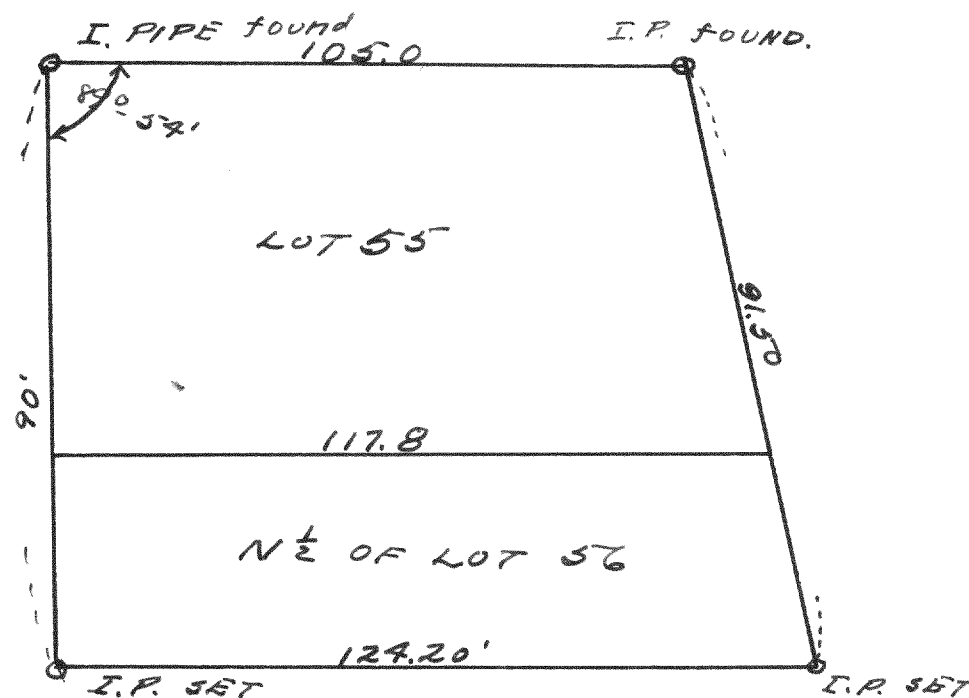


Survey of the lots 55
and the north one half of ~~lot~~ lot
56 of the original plat of
Cedar Point Park, Williams
Bay Wisconsin

Oct. 22, 1937

Lloyd L. Jensen
by W.E.J.

No. 895.

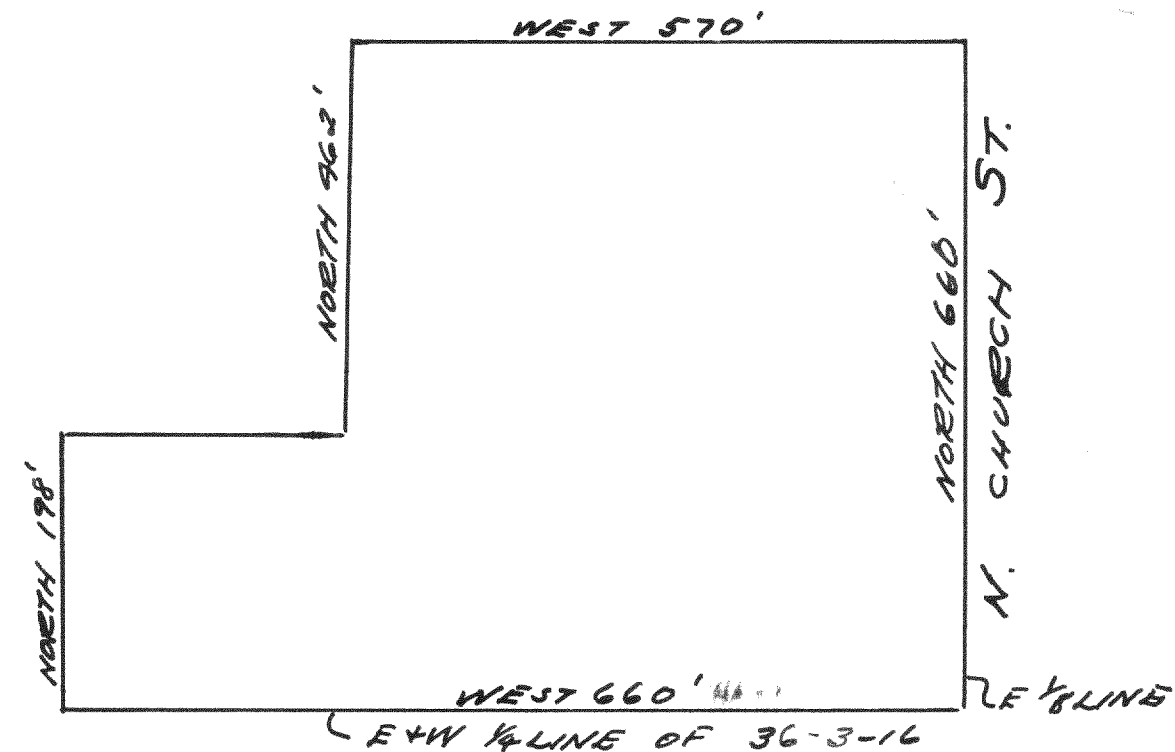

Survey of Holton
property in NE 1/4 36-3-16
in the city of Elkhorn.

Aug. 1938

Lloyd L. Jensen
by N.E.J.