


292

No. 899

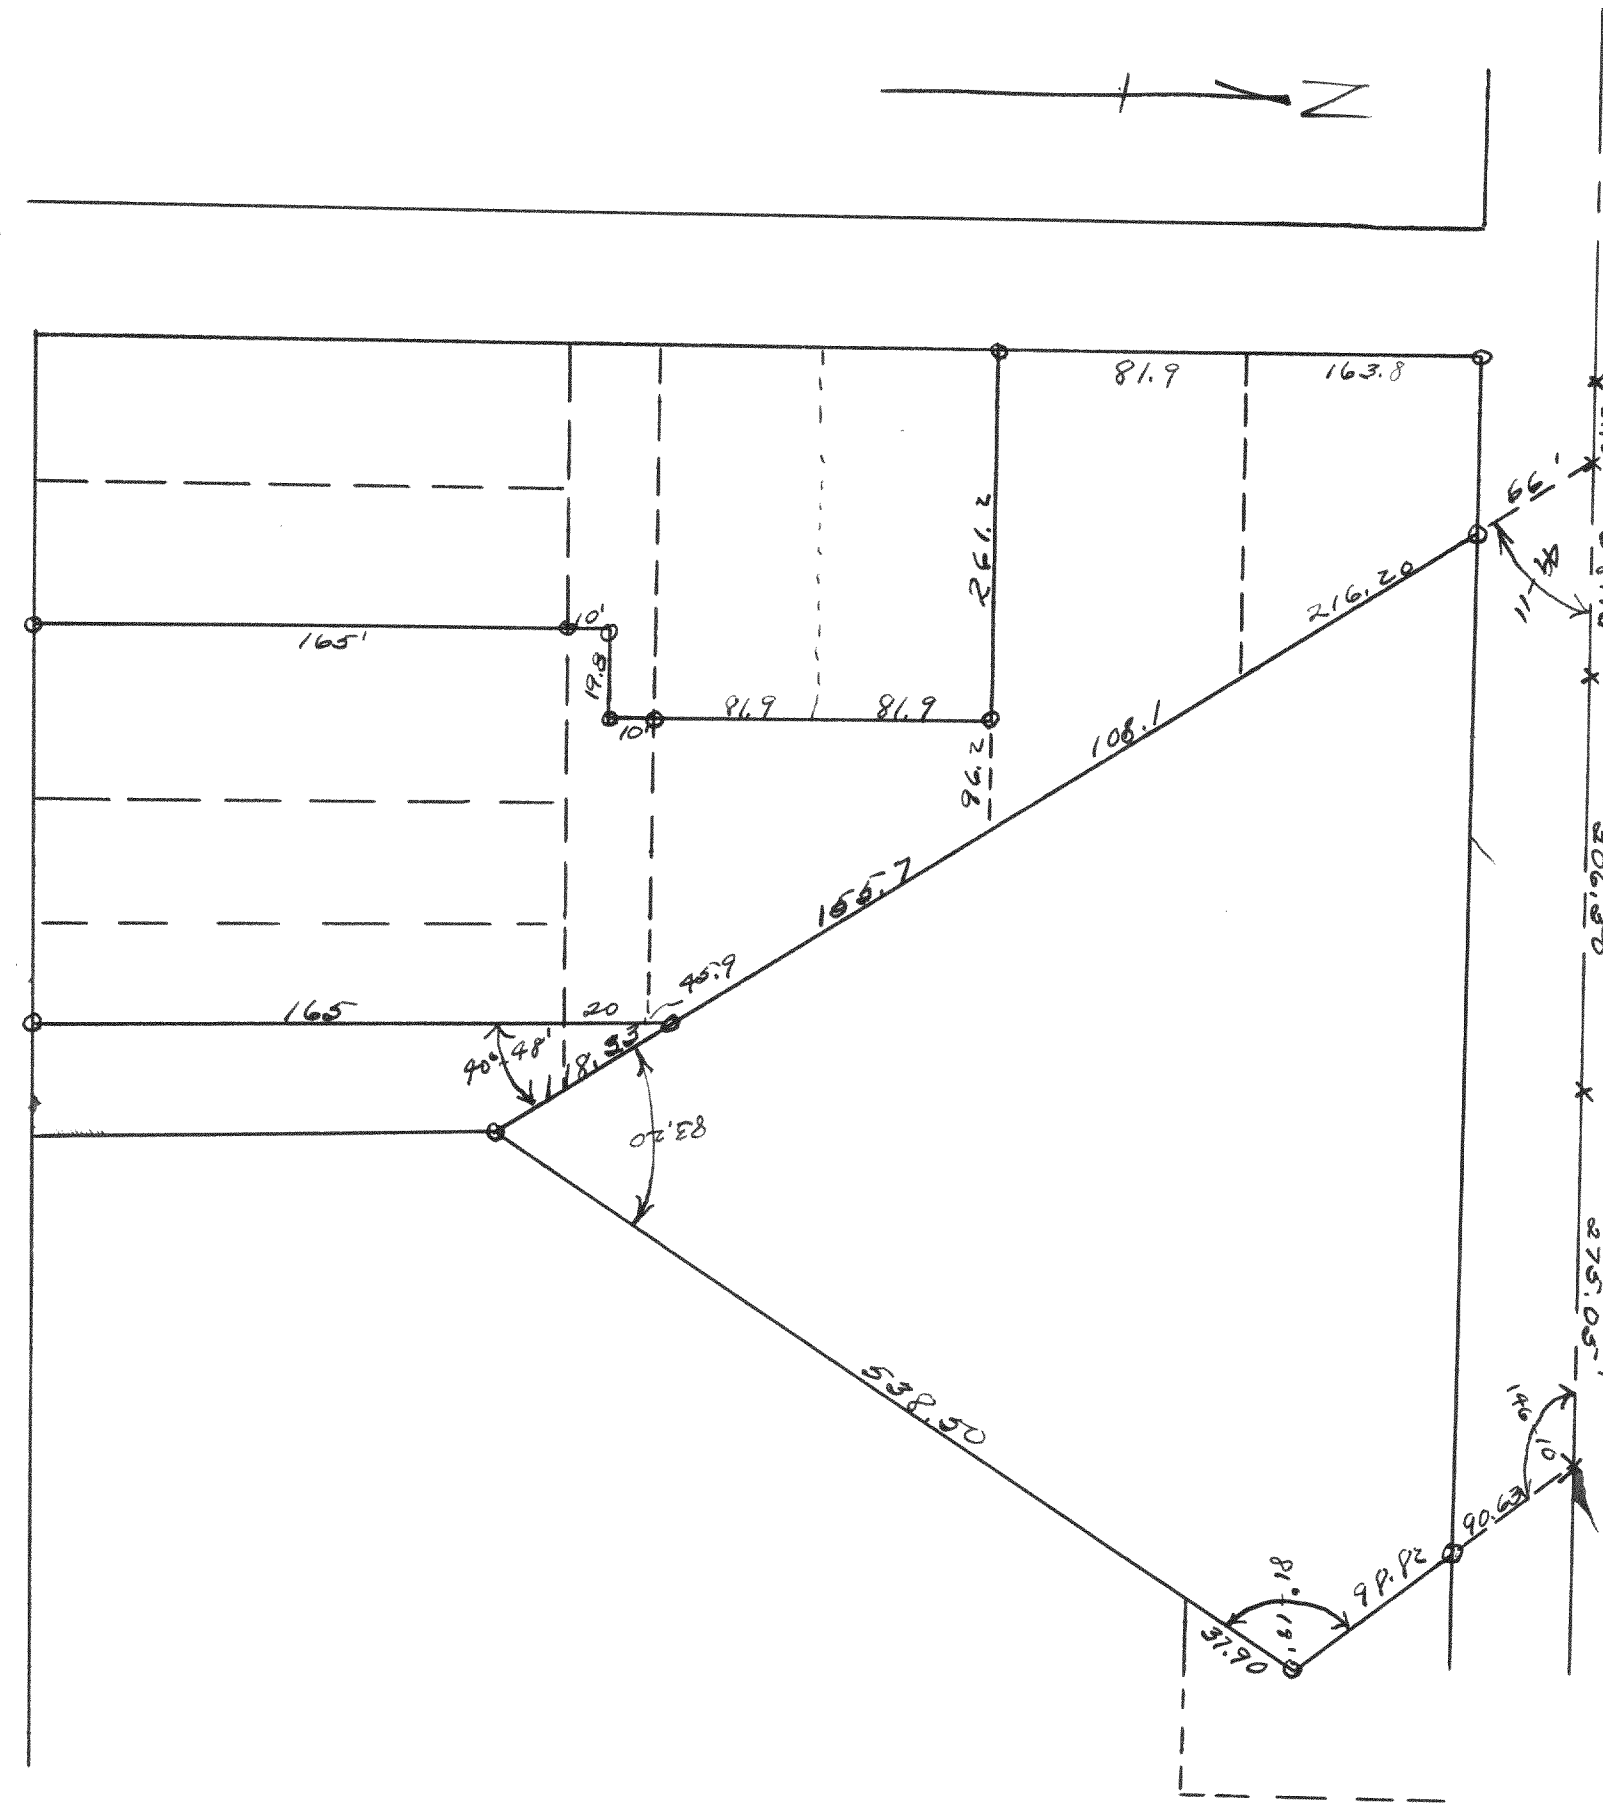


Survey of lots 1, 2, 5, 6, 7 & 8 of Blk. 5 of F.K.
Phoenix West add to the city of Delavan

July 25, 1938

Lloyd L. Jensen
by H.E.G.

No. 900

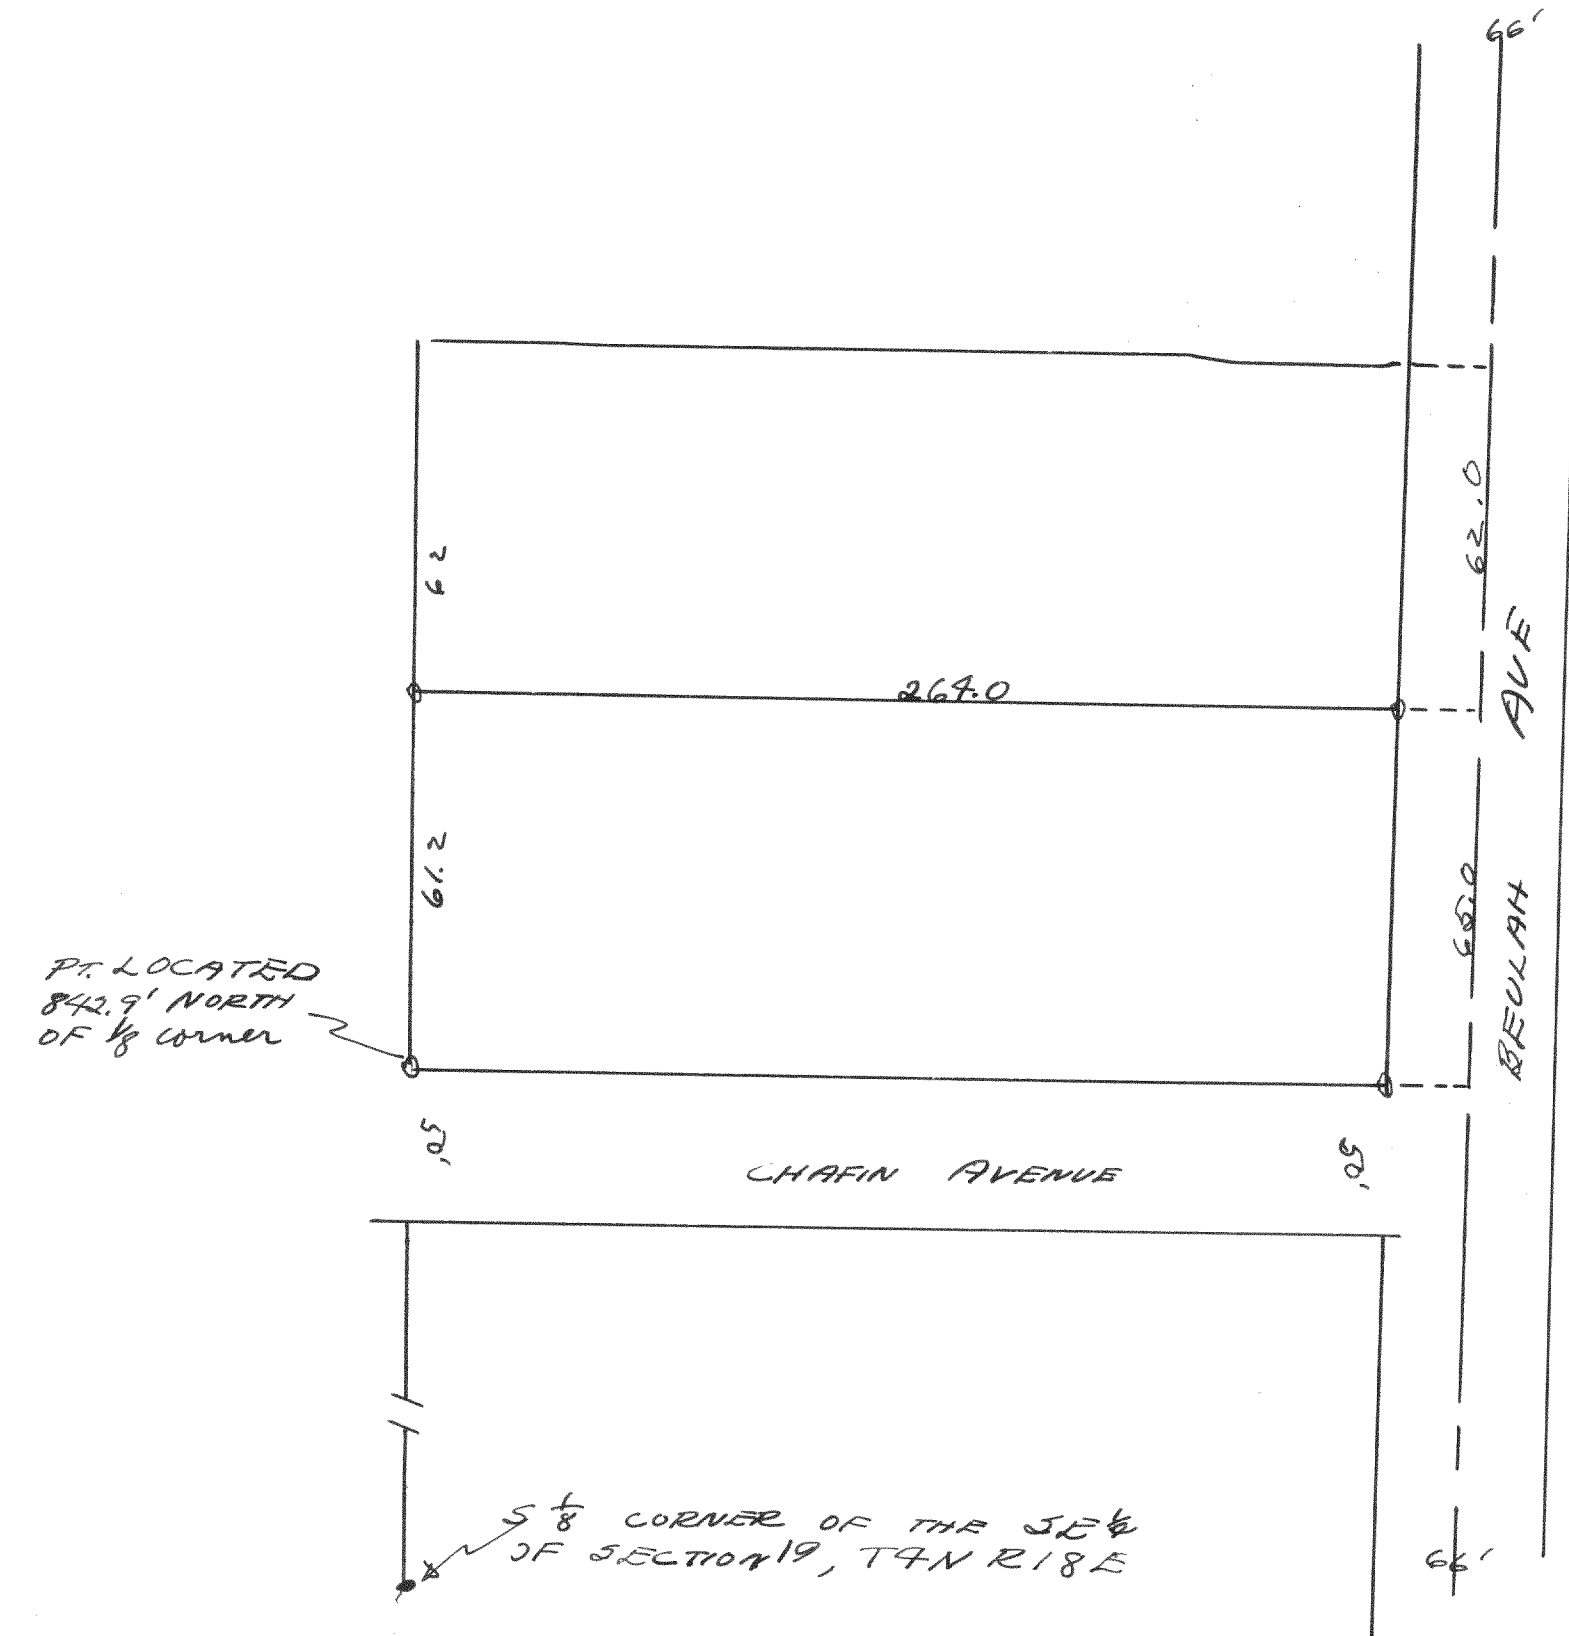

Survey of part of the SE 1/4 of
section 19 in the village of
East Troy.

6-23-37

Lloyd L. Jensen
by H.E.G.