


2961

No. 908

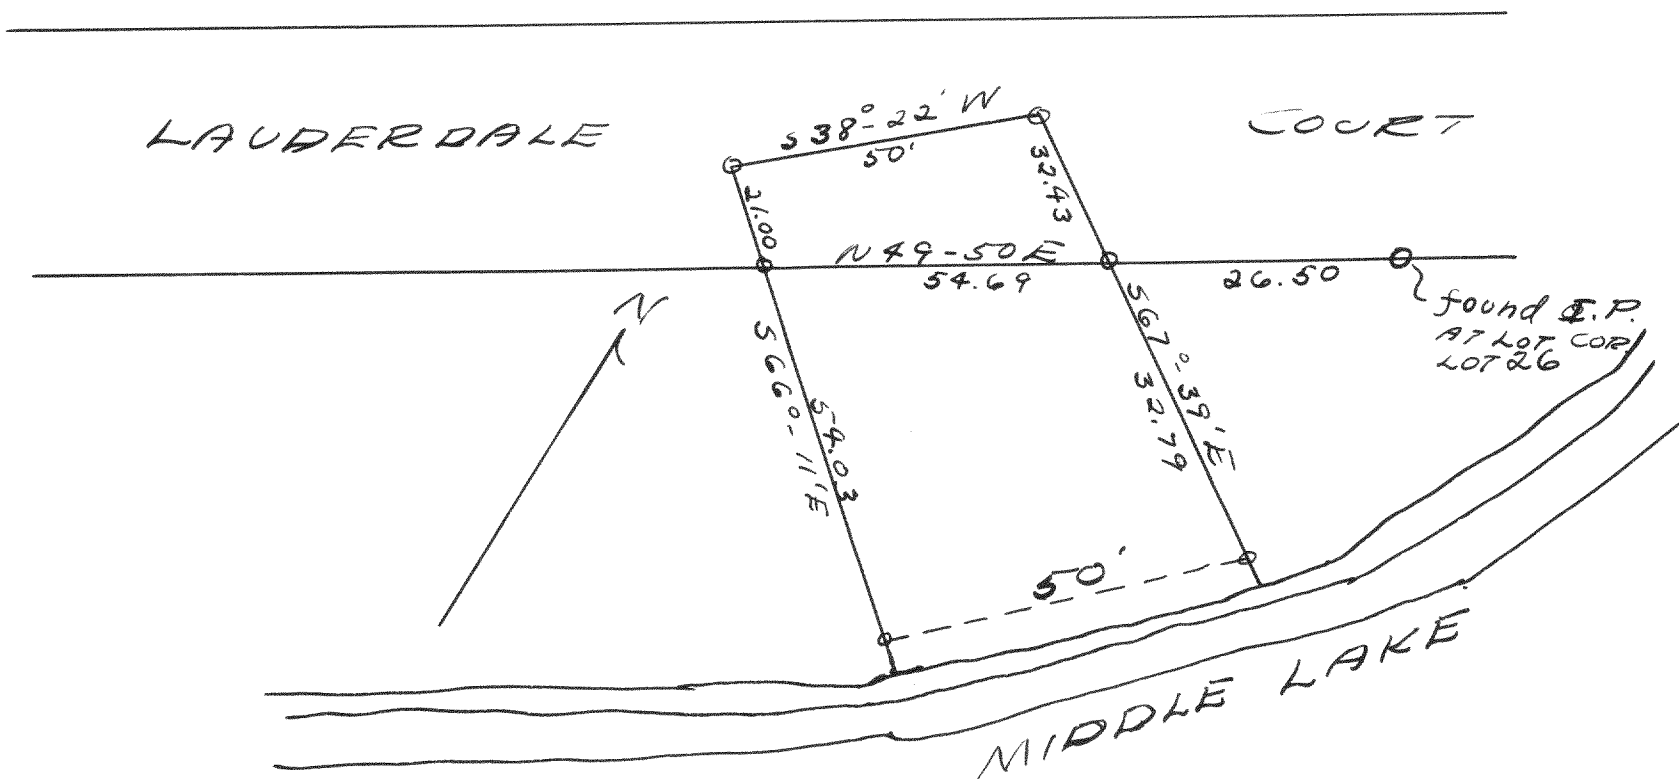


Plot of Survey of part of lot 25
of Green Island & Lauderdale
Court of Green Island

9-3-38

Lloyd L. Jensen
by *W. E. J.*

No. 909,

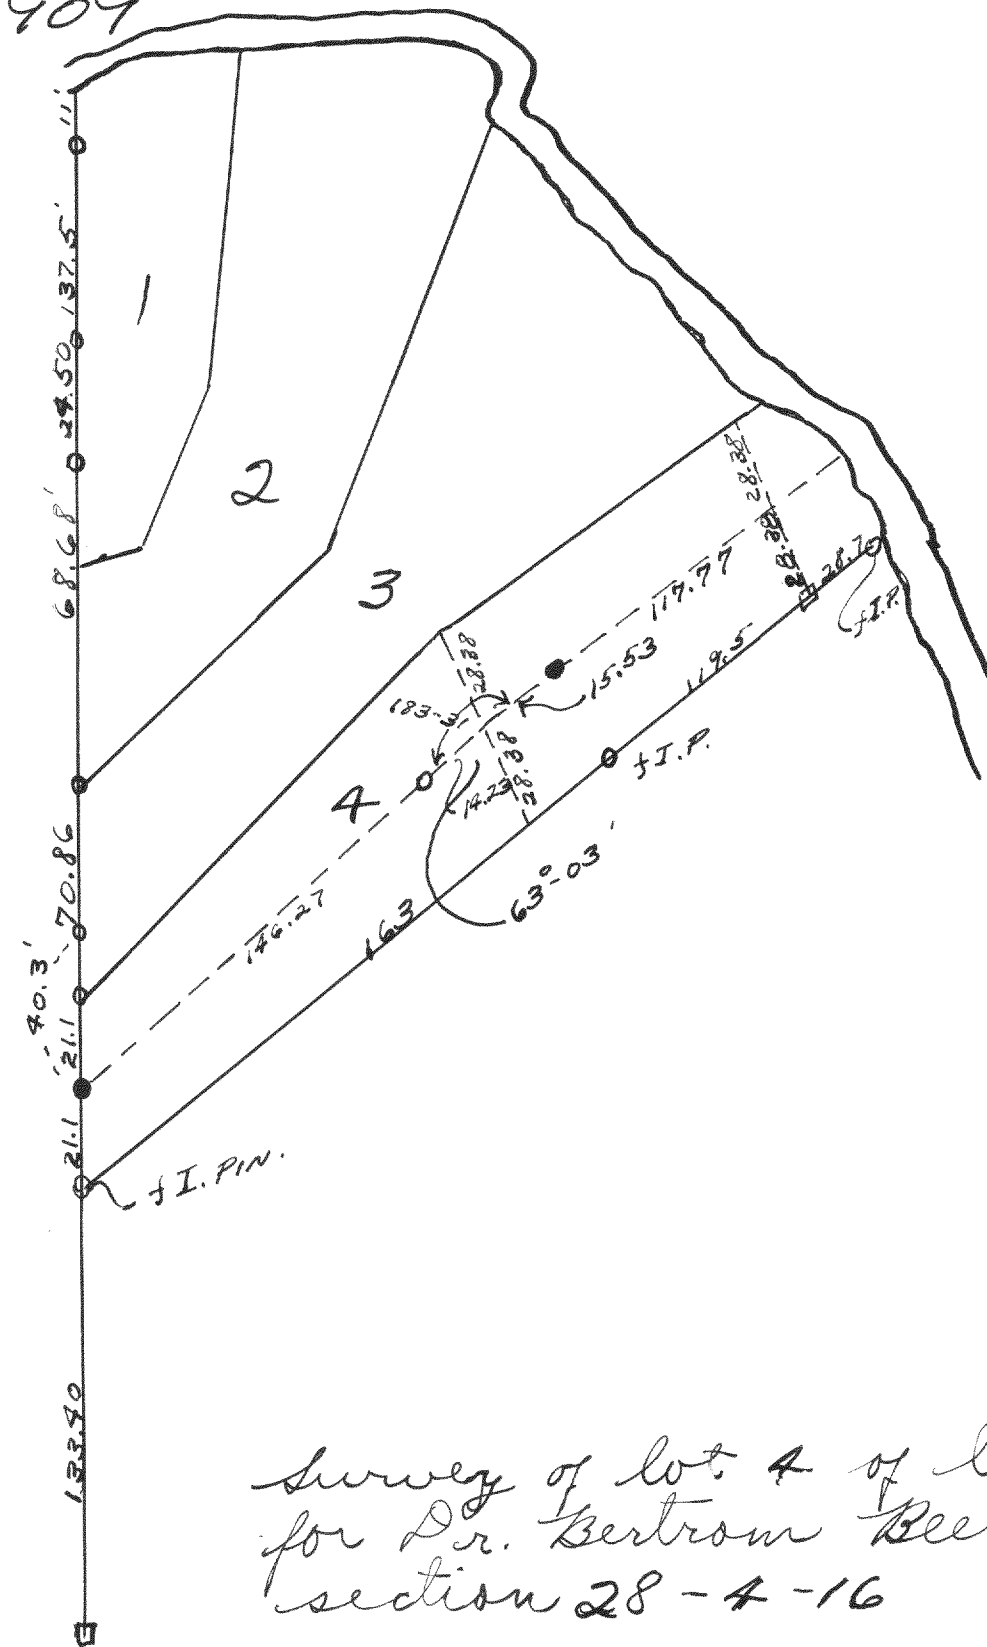

Survey of lot 4 of long point
for Dr. Bertram Beers. In
section 28-4-16

9-7-37

Lloyd L. Jensen
by K. E. G.