


No. 909

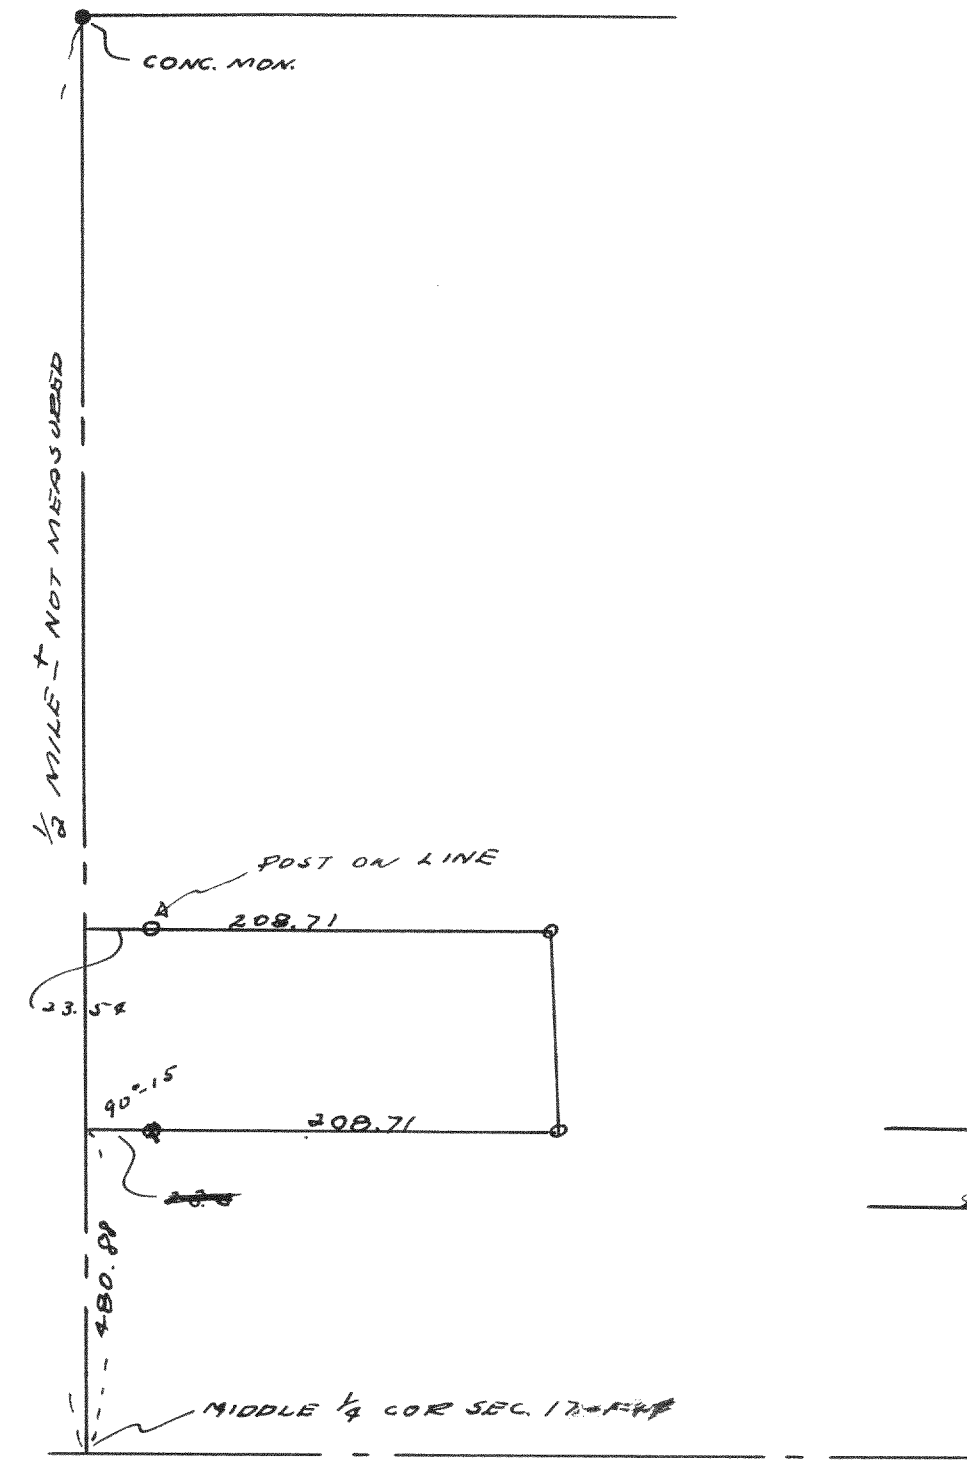


2

Survey of one acre of land in
the SE quarter of 17-1-17

1937

Lloyd L. Jensen
by N. E. J.


No. 110

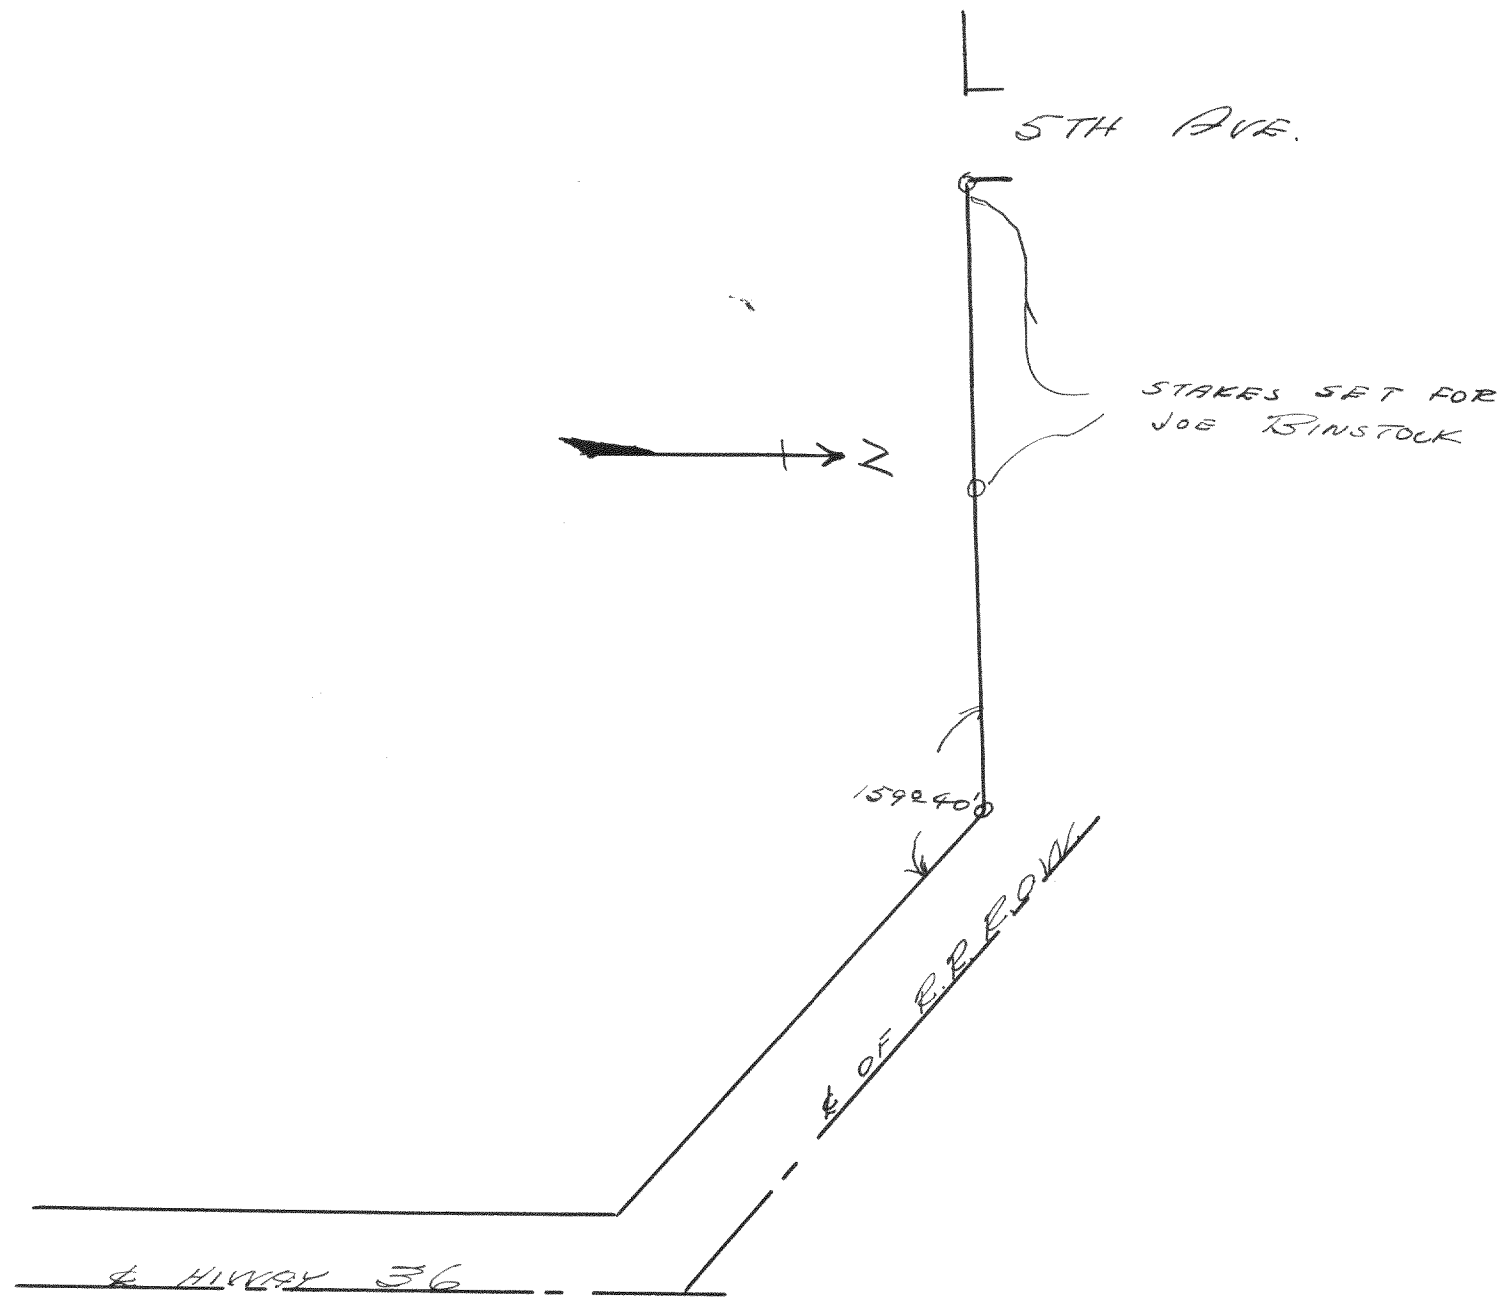

7-10-37

Survey of road fork
Village of Walworth
Lloyd L. Jensen
by N. E. J.

No. 711

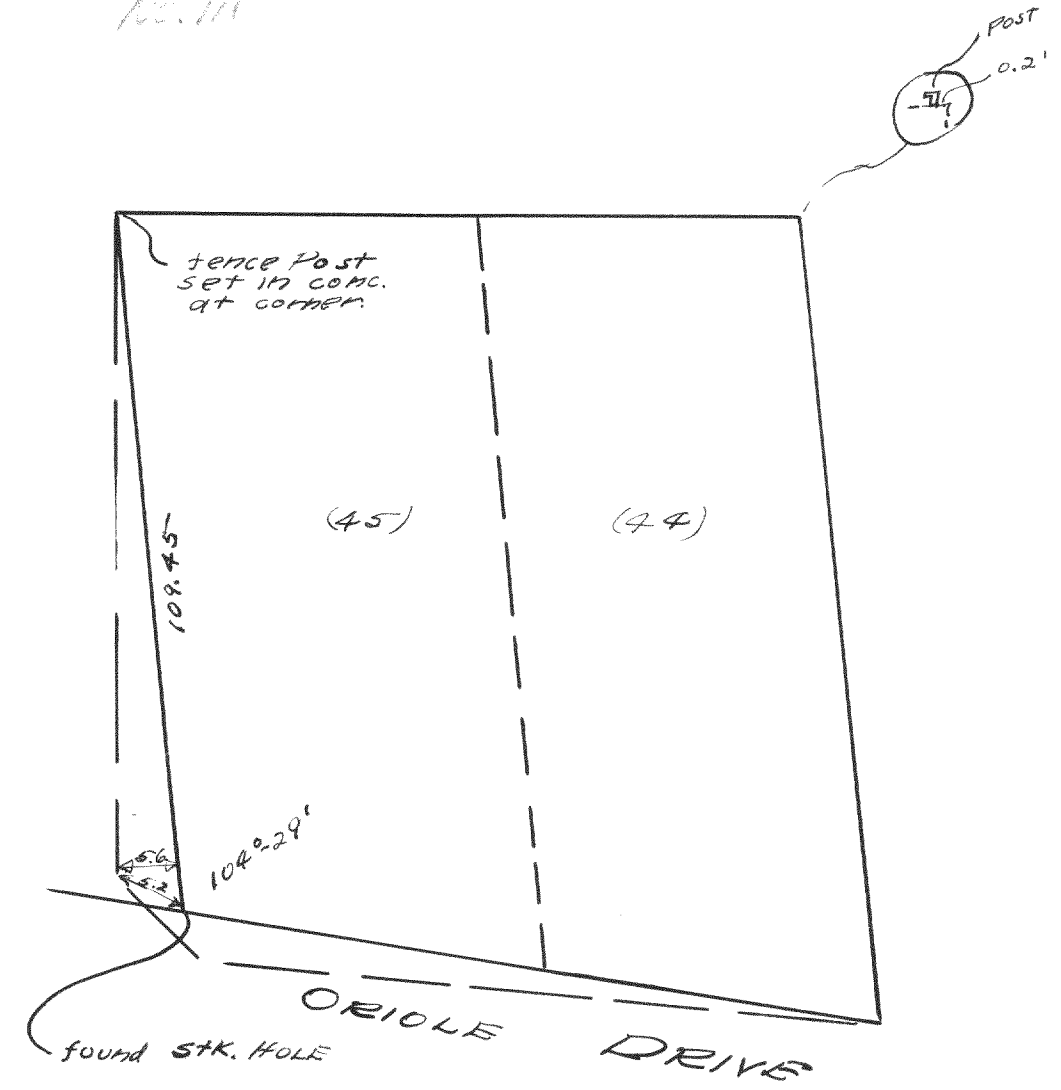

Survey of lots 44 and 45 of
Froberts Green Lake Park.

Aug., 1937

Lloyd L. Jensen
by N. E. J.