



No. 912

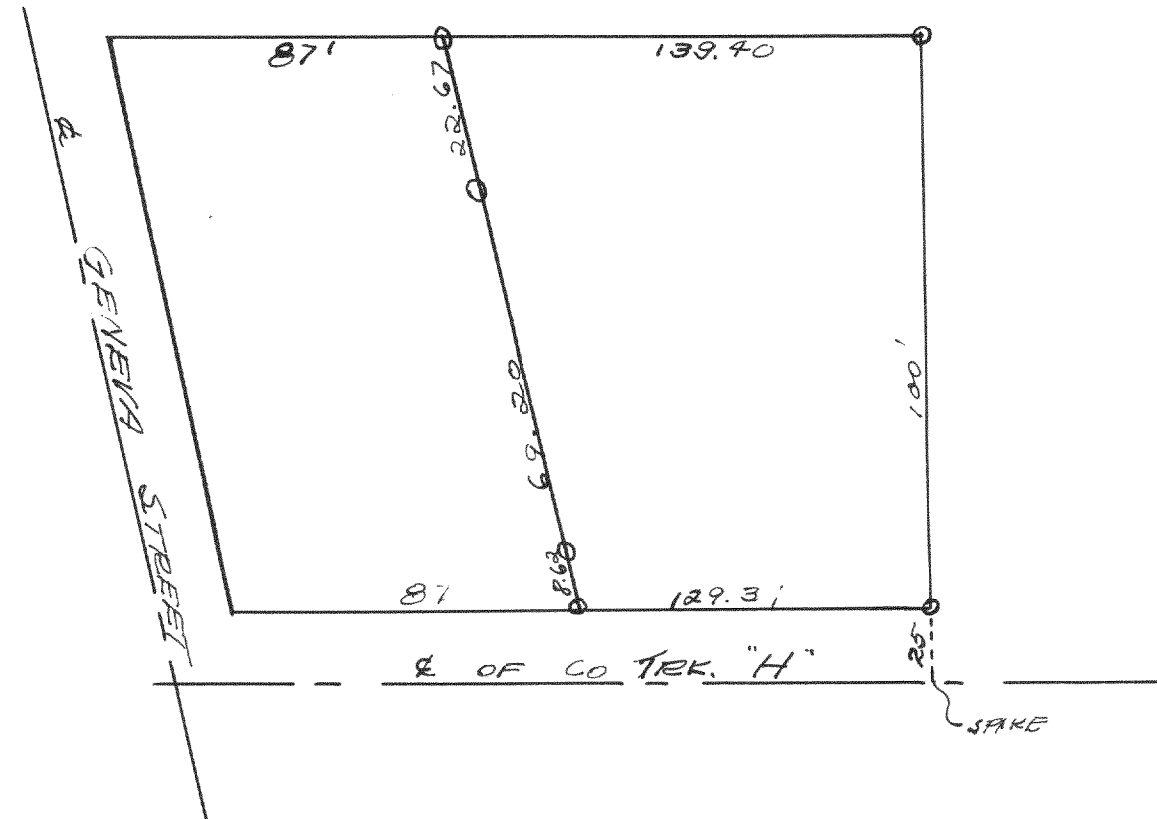


Survey of lots 8 & 9 of Blk. I of
original plat of Wms. Bay.
8-22-37 Lloyd L Jensen
by H.E.J.

No. 912

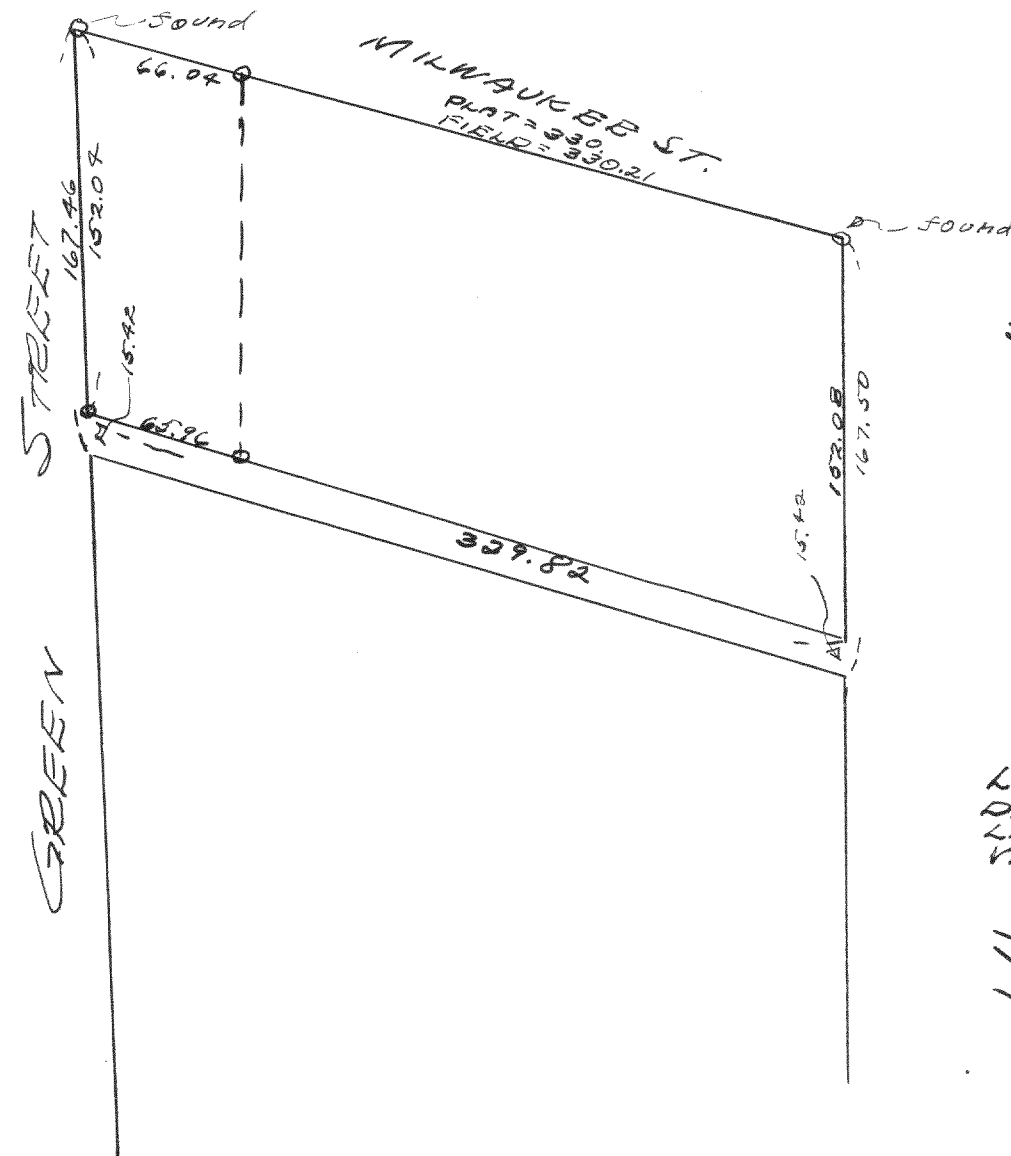

Survey of lot 5 of Blk. 2 of
Nriep & Posey's Subd. of
Blk. 10 in the city of
Whitewater.
N.D. Lloyd L Jensen
by H.E.J.

No. 917

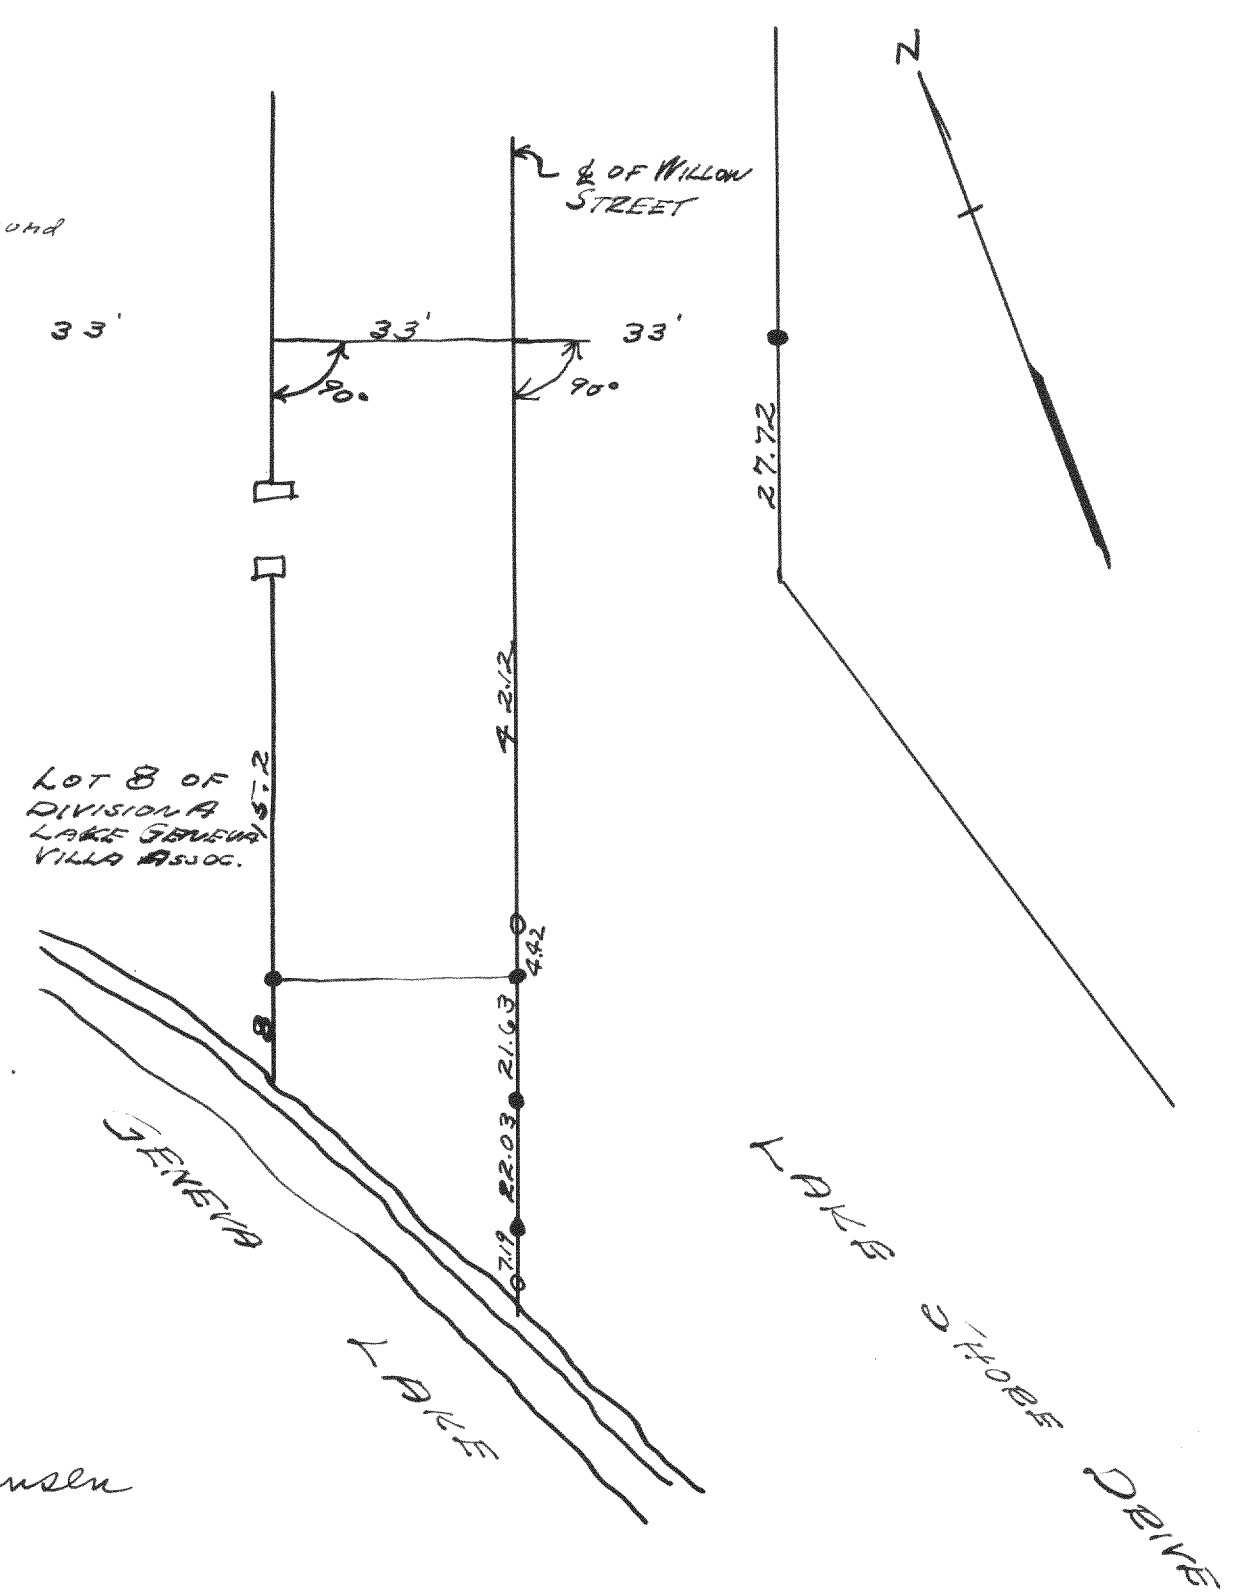

Survey of centerline of Willow
Street in the city of Lake
Geneva, in section 1-1-17
August 1937 Lloyd L Jensen
by H.E.J.