


Record of Survey.

Township 4 N, North of Range 18 E of 4 Principal Meridian  
as presented by the courses and distances on the following plat, and annexed field-notes of survey:  
Established the center of the section at the point of intersection of STRAIGHT quarter lines.  
Established all quarter-quarter corners upon the section boundary at proportional distances between known section and quarter section corners, according to the original field-notes of the Government survey.  
Established all lost corners at proportionate distances between known corners, according to the original field notes of the Government survey.

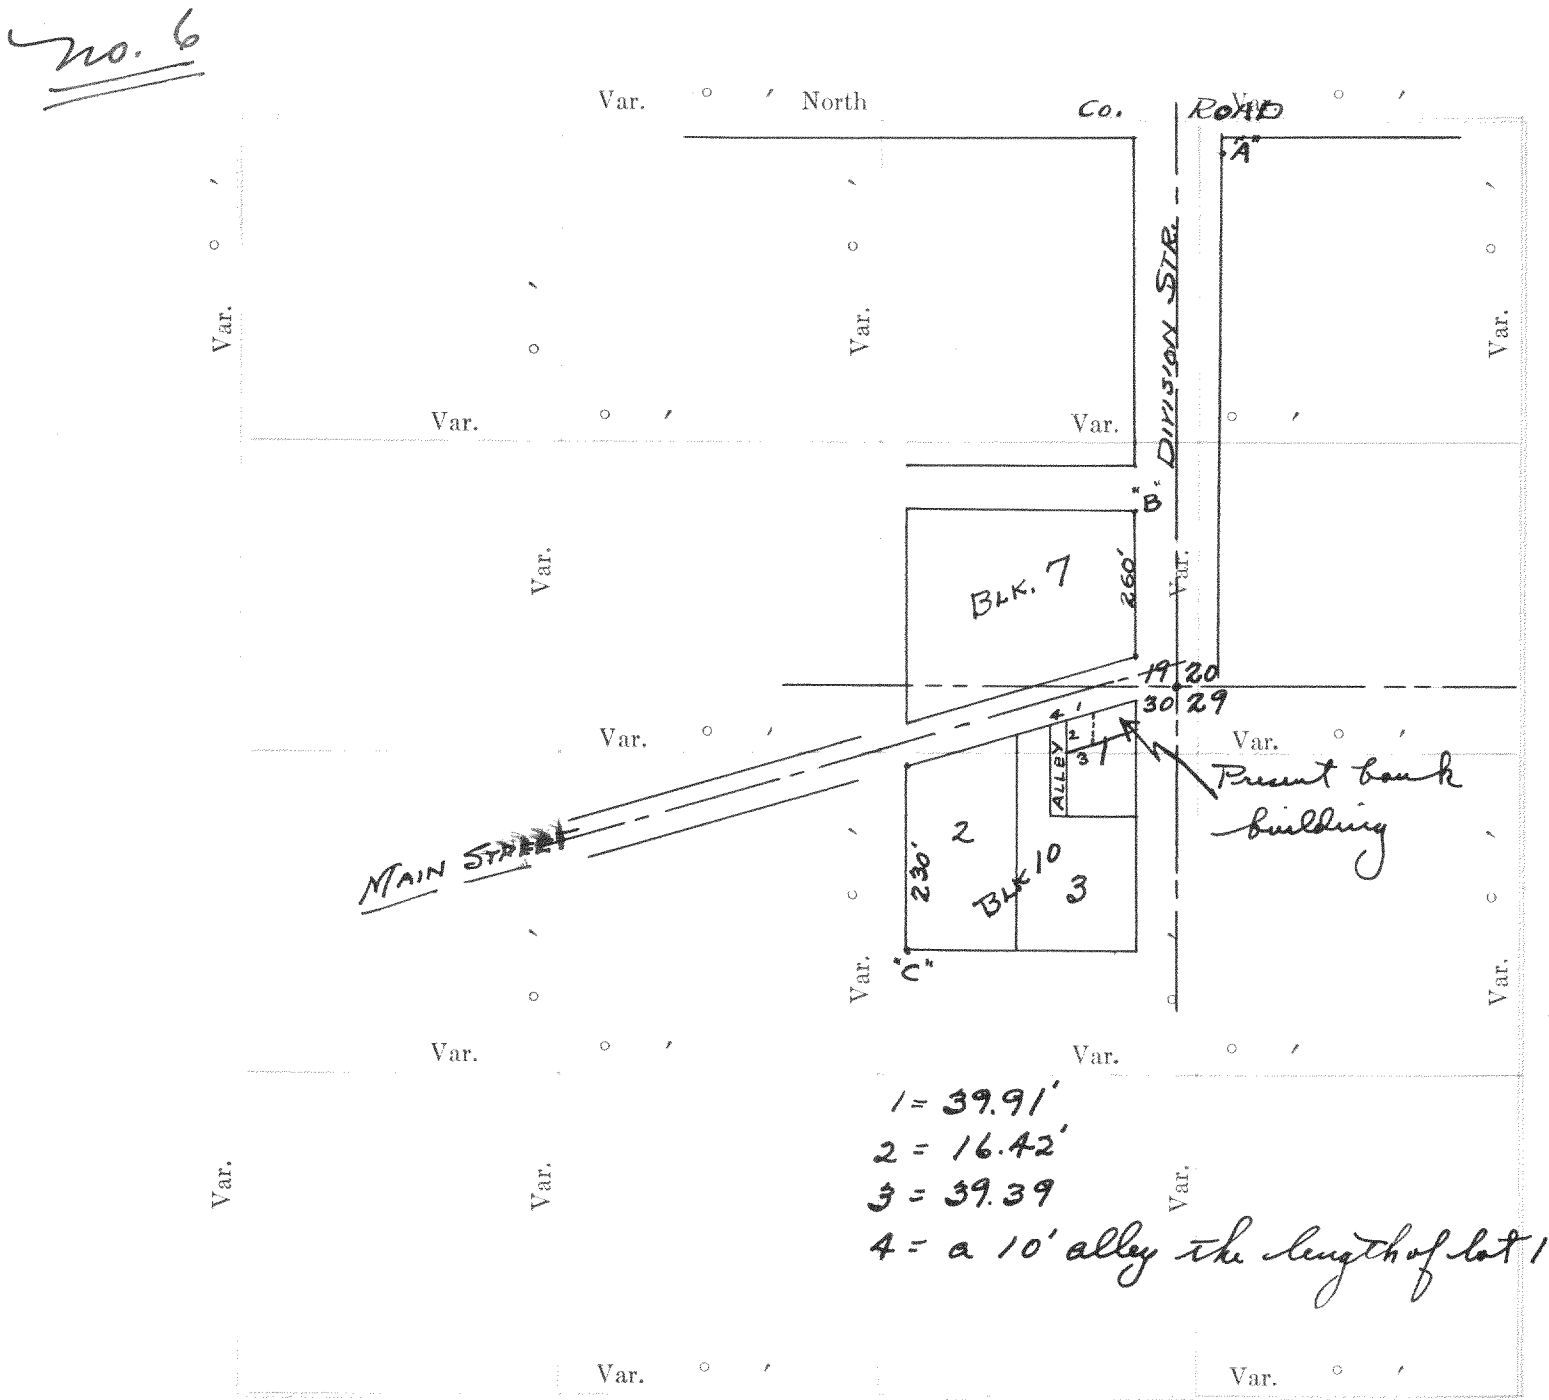

Plat of Section 30, Township 4 North, Range 18 E of 4 Principal Meridian Scale 80 chains to 6 inches. The figures in red ink are the lengths of the lines as stated in the field-notes of the Government survey.  
Declination of the Magnetic Meridian from the True Meridian \_\_\_\_\_  
Surveyed and sub-divided \_\_\_\_\_ A. D. 1 \_\_\_\_\_, in accordance with the State Laws and Instructions of the Commissioner of the General Land office, and recorded on pages \_\_\_\_\_ of Register in the County Clerk's office.

Witness my hand this \_\_\_\_\_ day of \_\_\_\_\_ A. D. 1  
Surveyed Dec. 27, 1932 Lloyd L. Jensen SURVEYOR.  
Revised Feb 18, 1933

DESCRIPTION

OF SECTION, QUARTER SECTION AND QUARTER QUARTER SECTION CORNERS

| H. C. MILLER CO. MFG. STATIONERS, MILWAUKEE WIS 5000 |  |  |  |         |      |           |         |         |      |           |         |         |      |           |         |
|------------------------------------------------------|--|--|--|---------|------|-----------|---------|---------|------|-----------|---------|---------|------|-----------|---------|
| GOVERNMENT CORNERS                                   |  |  |  | Bearing | In.  | Courses   | Links   | Bearing | In.  | Courses   | Links   | Bearing | In.  | Courses   | Links   |
|                                                      |  |  |  | Trees   | Dia. | they bear | Distant | Trees   | Dia. | they bear | Distant | Trees   | Dia. | they bear | Distant |
| No.                                                  |  |  |  |         |      |           |         |         |      |           |         |         |      |           |         |
| 1. N. W. Sec. Cor. identified,                       |  |  |  |         |      |           |         |         |      |           |         |         |      |           |         |
| 2. N. E. Sec. Cor. identified,                       |  |  |  |         |      |           |         |         |      |           |         |         |      |           |         |
| 3. S. E. Sec. Cor. identified,                       |  |  |  |         |      |           |         |         |      |           |         |         |      |           |         |
| 4. S. W. Sec. Cor. identified,                       |  |  |  |         |      |           |         |         |      |           |         |         |      |           |         |
| 5. N. 1/4 Sec. Cor. identified,                      |  |  |  |         |      |           |         |         |      |           |         |         |      |           |         |
| 6. E. 1/4 Sec. Cor. identified,                      |  |  |  |         |      |           |         |         |      |           |         |         |      |           |         |
| 7. S. 1/4 Sec. Cor. identified,                      |  |  |  |         |      |           |         |         |      |           |         |         |      |           |         |
| 8. W. 1/4 Sec. Cor. identified,                      |  |  |  |         |      |           |         |         |      |           |         |         |      |           |         |
| Subdivision Corners                                  |  |  |  |         |      |           |         |         |      |           |         |         |      |           |         |
| No.                                                  |  |  |  |         |      |           |         |         |      |           |         |         |      |           |         |
| 1. Center 1/4 Sec. Cor.                              |  |  |  |         |      |           |         |         |      |           |         |         |      |           |         |
| 2. North 1/4-1/4s N. W. qr.,                         |  |  |  |         |      |           |         |         |      |           |         |         |      |           |         |
| 3. East 1/4-1/4s N. W. qr.,                          |  |  |  |         |      |           |         |         |      |           |         |         |      |           |         |
| 4. South 1/4-1/4s N. W. qr.,                         |  |  |  |         |      |           |         |         |      |           |         |         |      |           |         |
| 5. West 1/4-1/4s N. W. qr.,                          |  |  |  |         |      |           |         |         |      |           |         |         |      |           |         |
| 6. Center 1/4-1/4s N. W. qr.,                        |  |  |  |         |      |           |         |         |      |           |         |         |      |           |         |
| 7. North 1/4-1/4s N. E. qr.,                         |  |  |  |         |      |           |         |         |      |           |         |         |      |           |         |
| 8. East 1/4-1/4s N. E. qr.,                          |  |  |  |         |      |           |         |         |      |           |         |         |      |           |         |
| 9. South 1/4-1/4s N. E. qr.,                         |  |  |  |         |      |           |         |         |      |           |         |         |      |           |         |
| 10. Center 1/4-1/4s N. E. qr.,                       |  |  |  |         |      |           |         |         |      |           |         |         |      |           |         |
| 11. East 1/4-1/4s S. E. qr.,                         |  |  |  |         |      |           |         |         |      |           |         |         |      |           |         |
| 12. South 1/4-1/4s S. E. qr.,                        |  |  |  |         |      |           |         |         |      |           |         |         |      |           |         |
| 13. West 1/4-1/4s S. E. qr.,                         |  |  |  |         |      |           |         |         |      |           |         |         |      |           |         |
| 14. Center 1/4-1/4s S. E. qr.,                       |  |  |  |         |      |           |         |         |      |           |         |         |      |           |         |
| 15. South 1/4-1/4s S. W. qr.,                        |  |  |  |         |      |           |         |         |      |           |         |         |      |           |         |
| 16. West 1/4-1/4s S. W. qr.,                         |  |  |  |         |      |           |         |         |      |           |         |         |      |           |         |
| 17. Center 1/4-1/4s S. W. qr.                        |  |  |  |         |      |           |         |         |      |           |         |         |      |           |         |

NAMES OF SWORN ASSISTANTS

CHAINMEN FLAGMEN AXMEN

No. 6 Survey - to locate boundary lines for East Troy State Bank  
 Location - Lot 1, Blk. 10 original town of East Troy  
 Sec. 30, T47N, R18E  
 Monuments - Found street line at A from which we  
 measured 33' west and obtained the sec. line  
 and E of Division Street.  
 "B" is the corner of the old Wilmes Bros. store  
 which is the NE. cor. of blk 7.  
 "C" the old original stake hole was found which  
 marks the SW. cor. of blk 10.  
 Procedure - Located the center lines of Division str. & of  
 main str. as shown. Located the alley line along  
 the West side of lot 1, Blk. 10. Then located the  
 intersection of the south line of main street and  
 the East line of the alley and determined the  
 size & location of the bank lot.

Survey - of lots in Village of Darien  
 Location - Lots 1 & 2, blk 23, John Bruce's Add. to Darien  
 Monuments - Found an iron pipe at "A" marking east boundary  
 of cemetery, measured West & located E of old road at "B"  
 Found iron pin at "C" - measured 617 feet east & located E  
 of same road.  
 Found original stone at "D" marking street & blk cor.  
 Procedure - Measured blk. 23 to determine its true length  
 and found it differed from plat. divided up errors in  
 proportion to size of lots and laid out the lots accordingly.  
 Survey made by Wal. C. Highway Supt.

Recorded by Lloyd S. Jensen  
 County Surveyor.

