



NO 9 SURVEY NO. 919

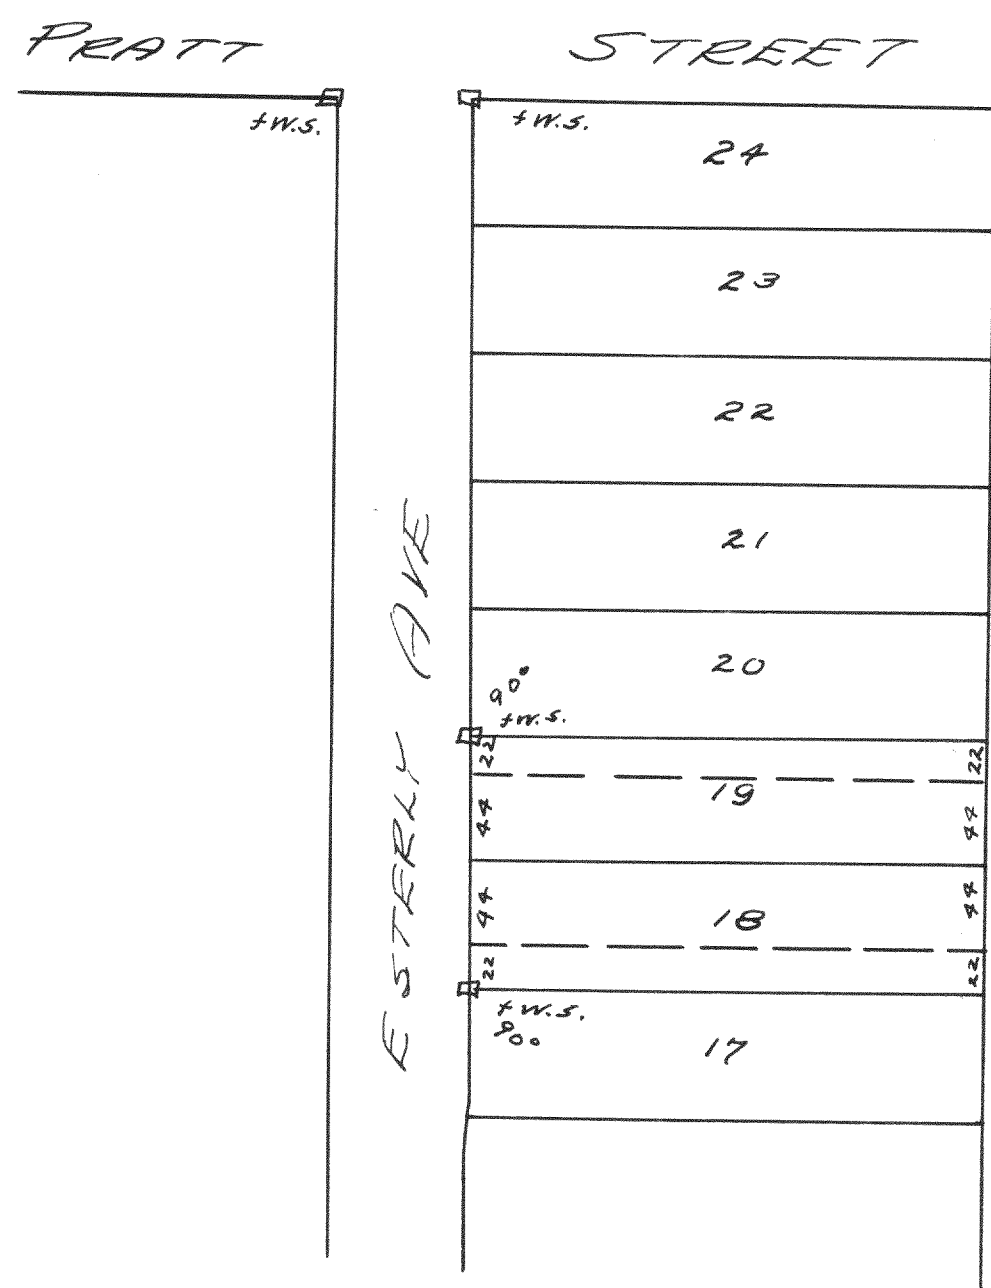


Survey of the N 44' of lot 18 and the S 44' of lot 19, Blk. 1 High + Johnson's Add to the City of Whitewater.

SURVEY NO. 920

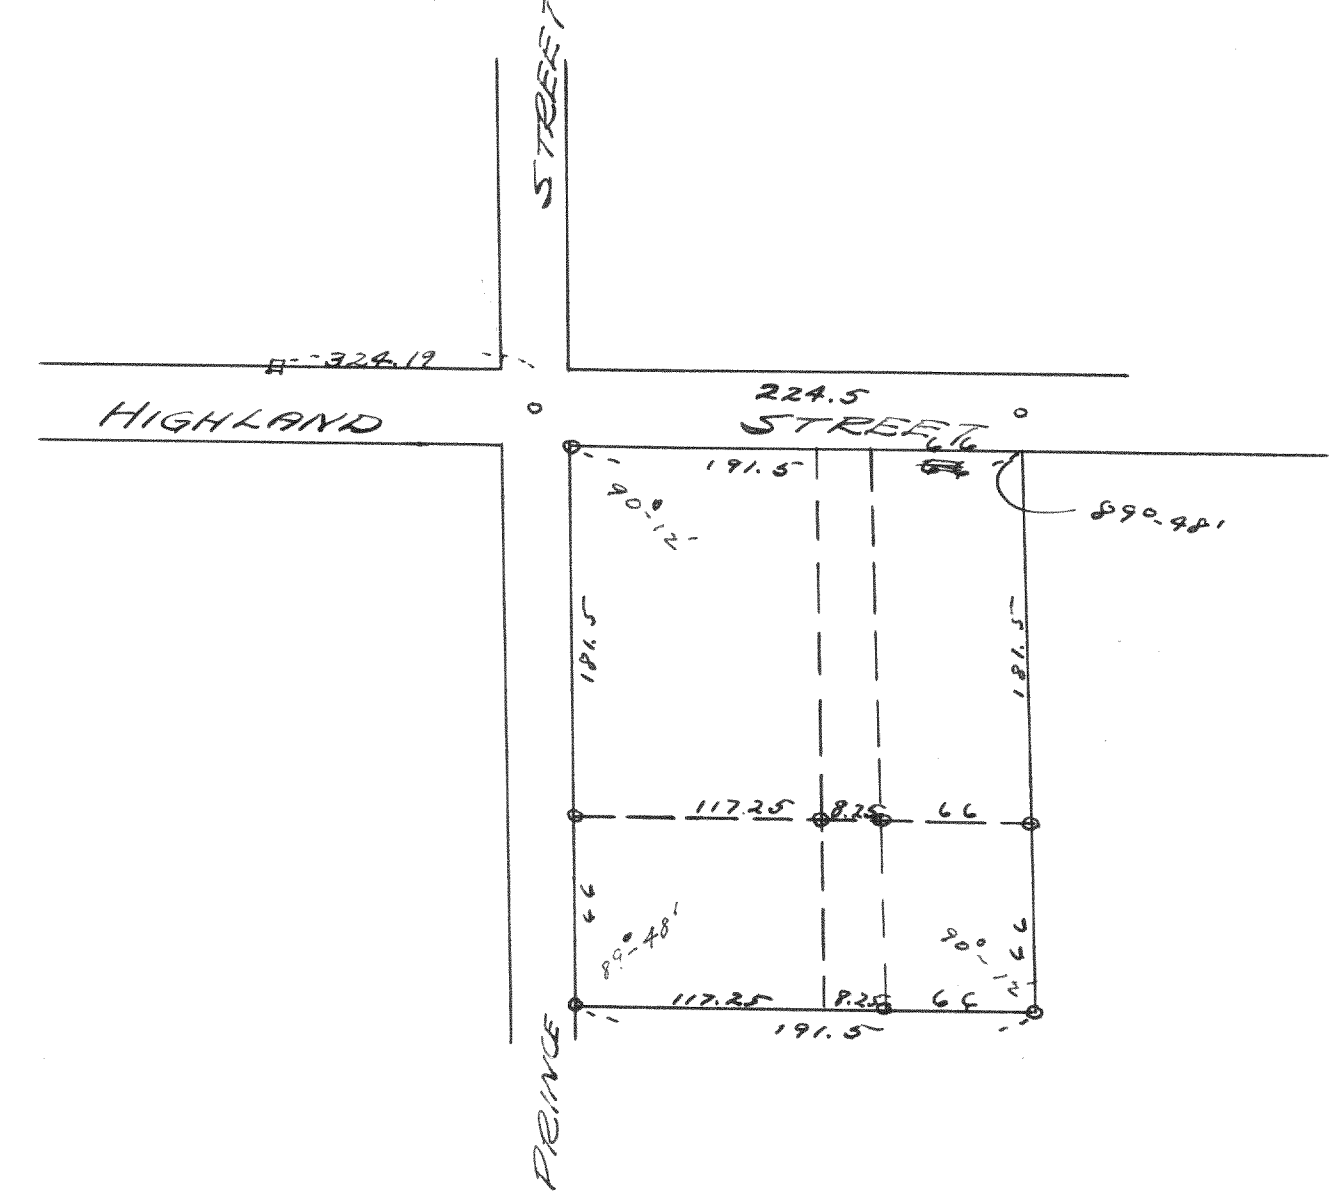

Survey of part of Block 5 of Birge's Add. to the City of Whitewater.

SURVEY NO. 921

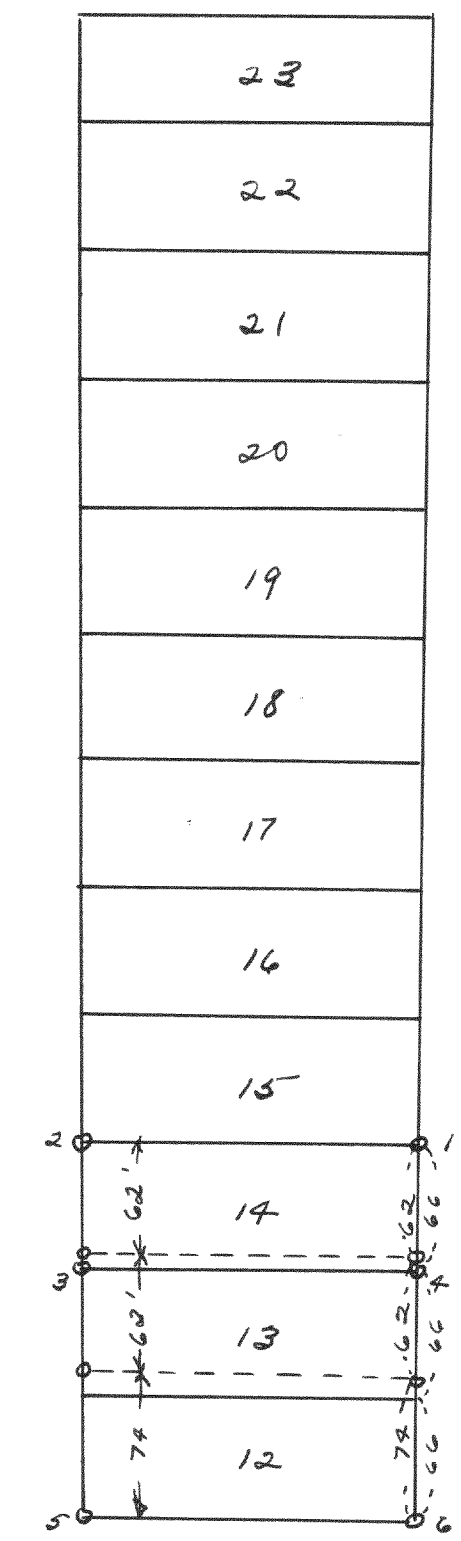

Survey of lots 12, 13, 14 of Cooper + Co's Add to the City of Whitewater.

(10-4-38) Lloyd L. Jensen by H.E.D.

FOUND I.P. AT 12, 13, 14, 15, 16, 17, 18, 19, 20, 21, 22, 23 SET OTHER I.P. AS INDICATED BY D