


SURVEY No 922

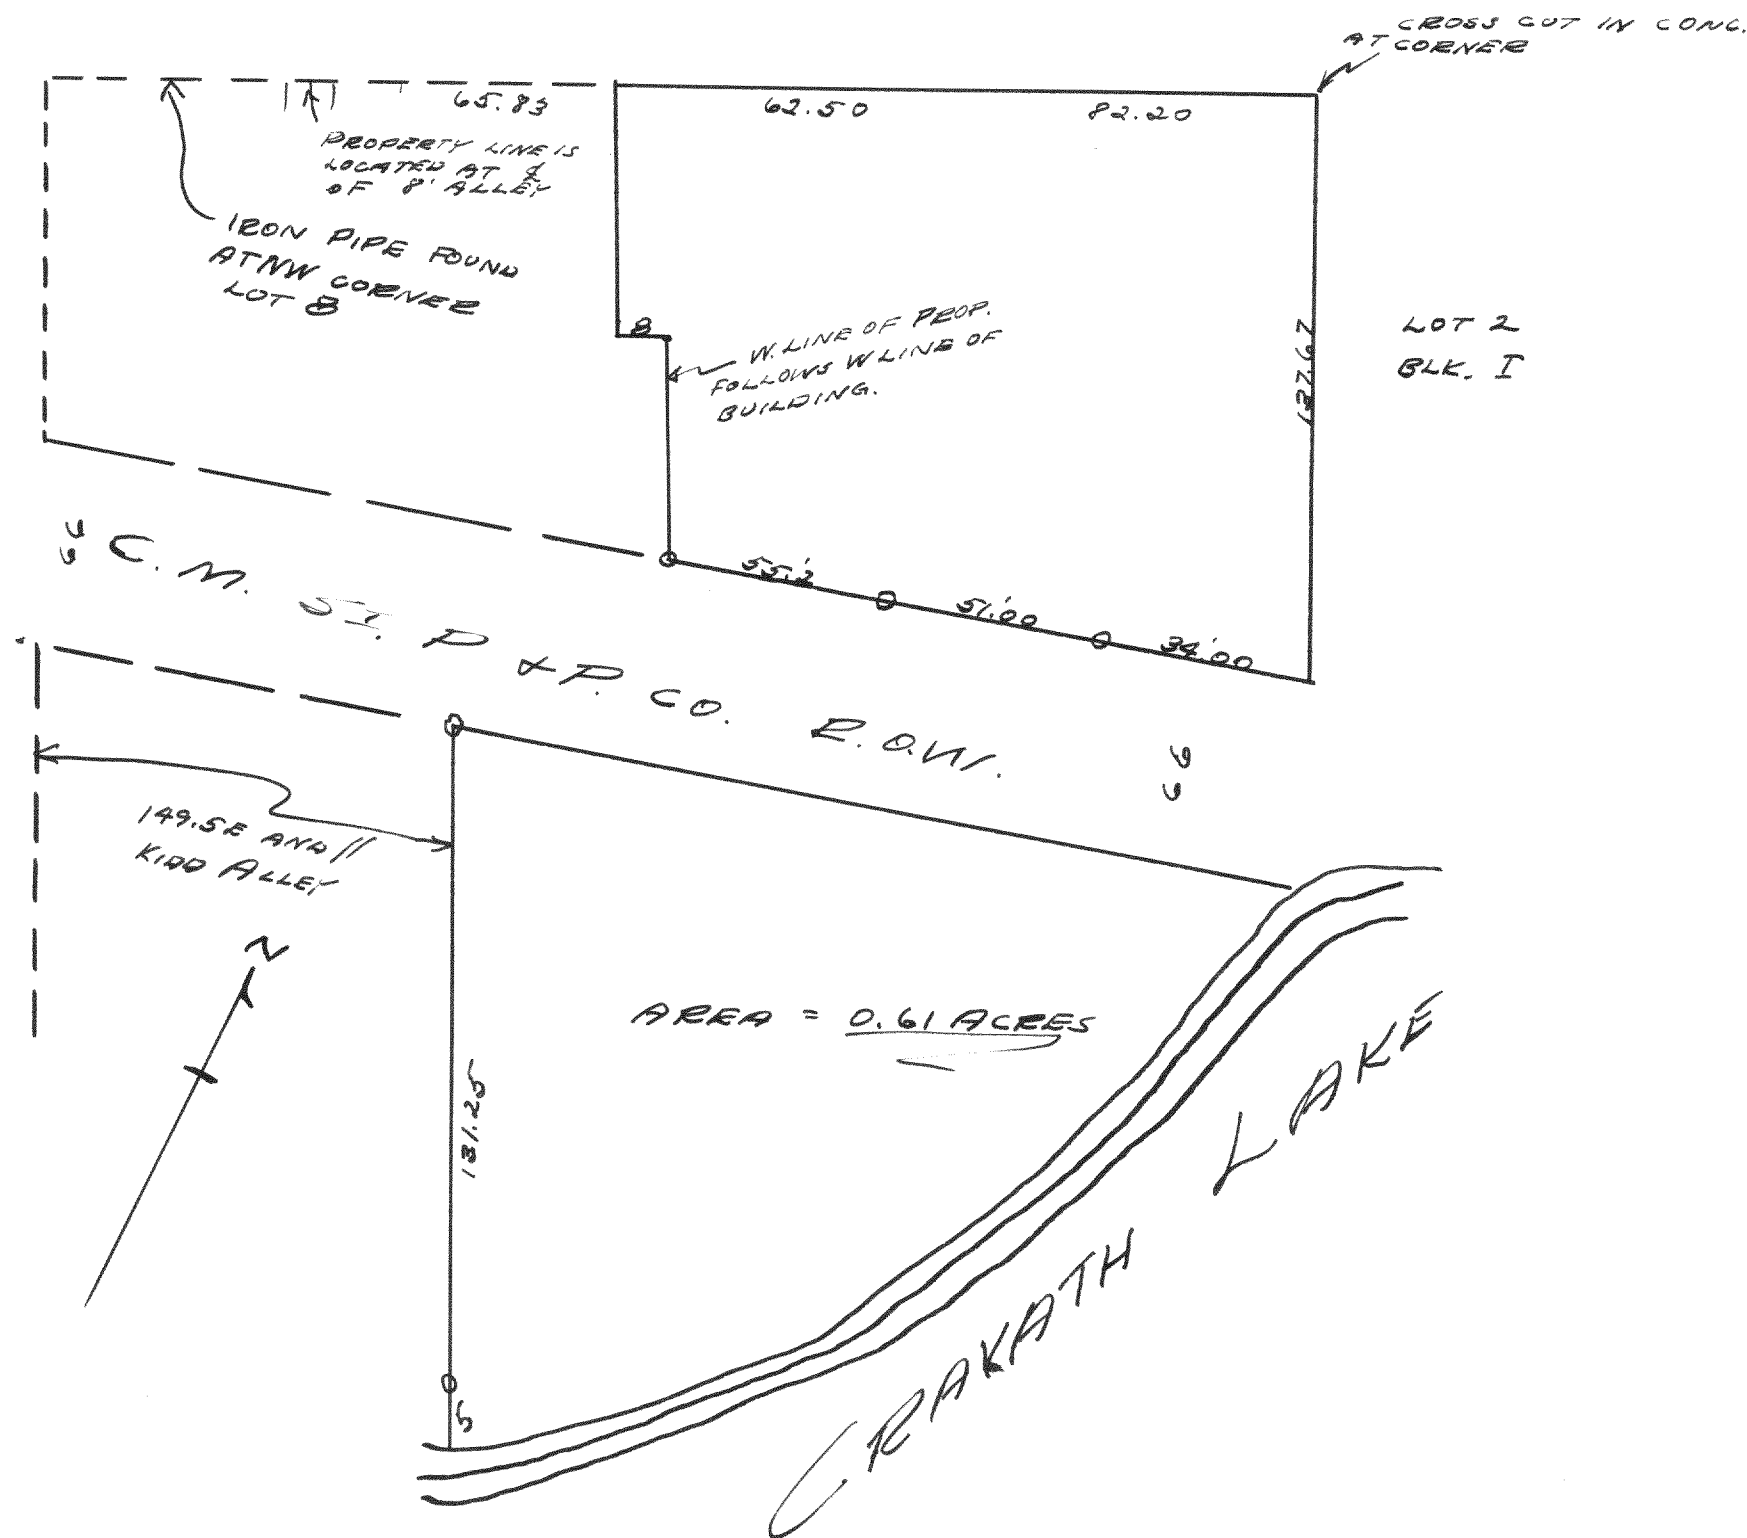


Plat of survey of lots 3, 4, and part of lot 5
Blk. I Berge Addition to the City of Whitewater

August 12, 1937

Lloyd Jensen
by H.E.J.

SURVEY No. 923

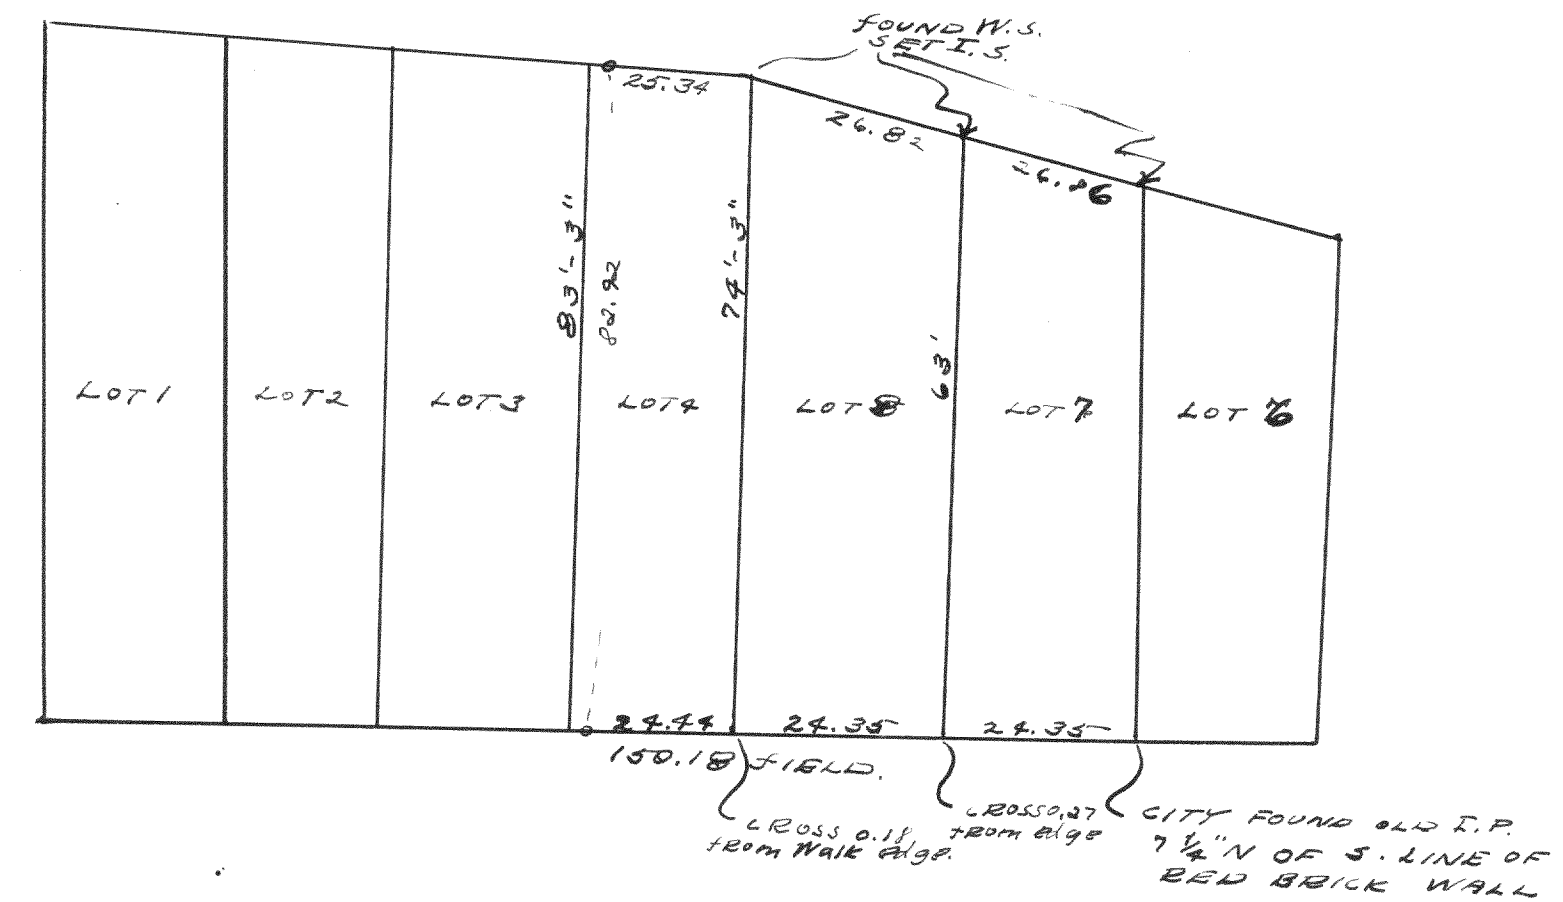

Survey of part of Block 13 of the
original plat of the City of Whitewater.

Sept. 15 & 16, 1937

Lloyd Jensen
by H.E.J.