


SURVEY No. 934

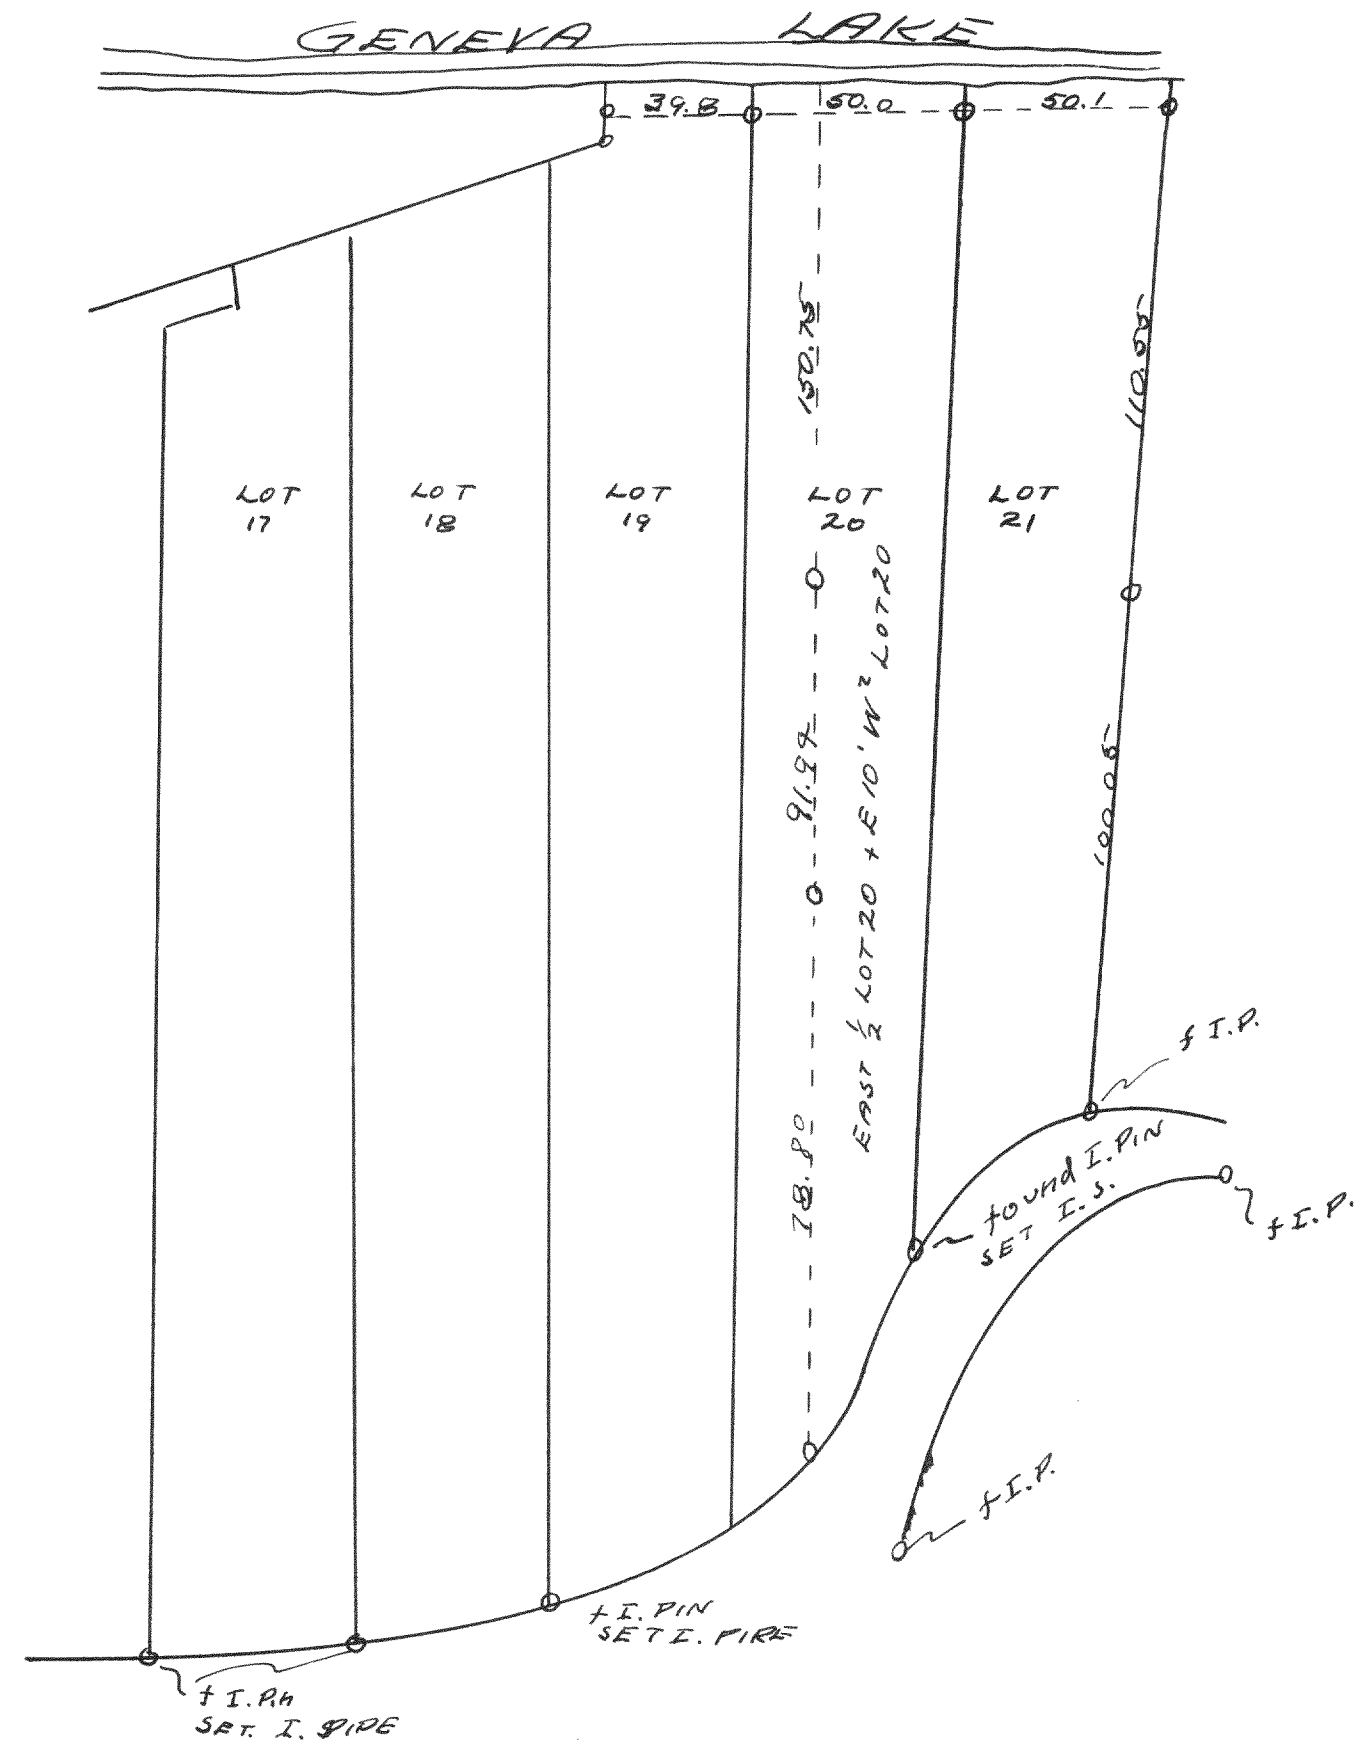

Survey of lots 20 + 21 of Indian Hill Subd.
in the Village of Fontana
May 92
Lloyd L. Jensen
of N. E. D.

Survey No. 935



Survey of the south 50' of lot 1
Block 1 also abd of lot ~~one~~ blk. 2 east of
a line $2\frac{1}{2}$ feet east of a well in
D. A. Reed's Add. to the Village of Frontana.
April 1925
Lloyd L. Jensen
by H. E. J.