



SURVEY No. 936

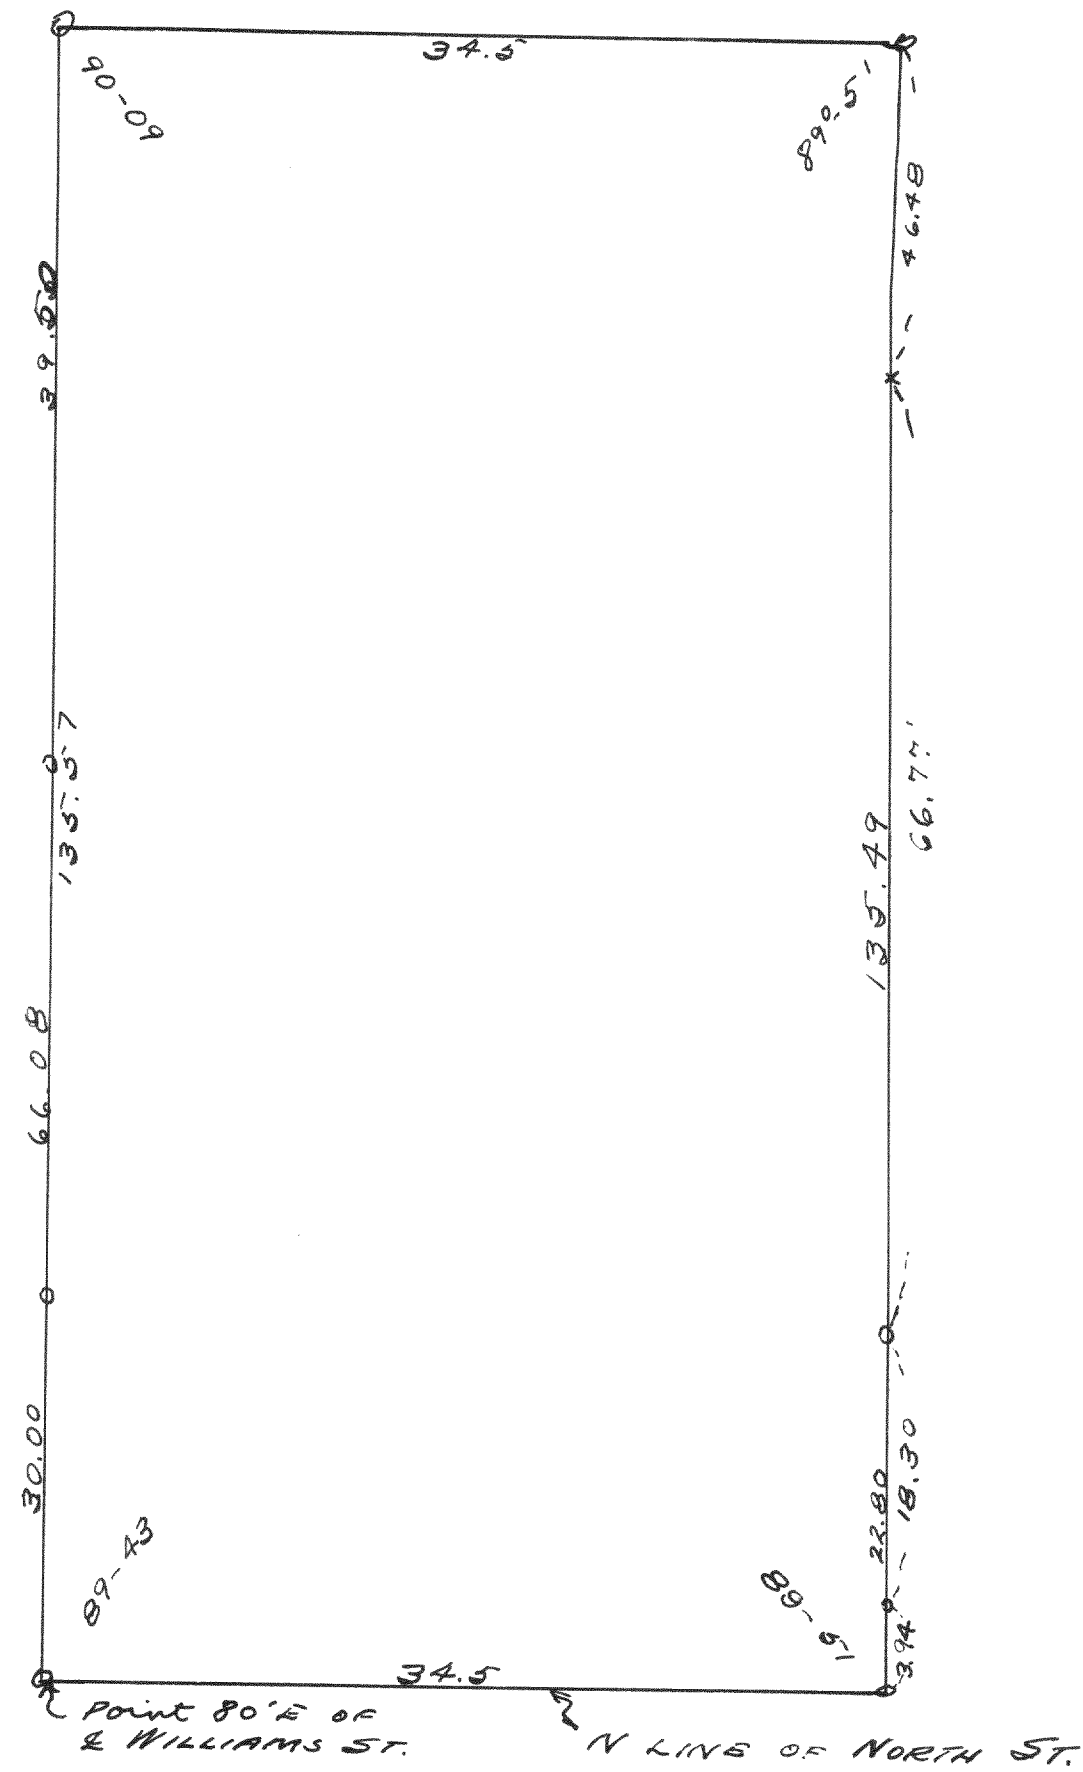


Survey of a parcel of land in
SW 1/4 25-2-17
May 1938
Lloyd L. Jensen
by H. E. J.

SURVEY No. 937

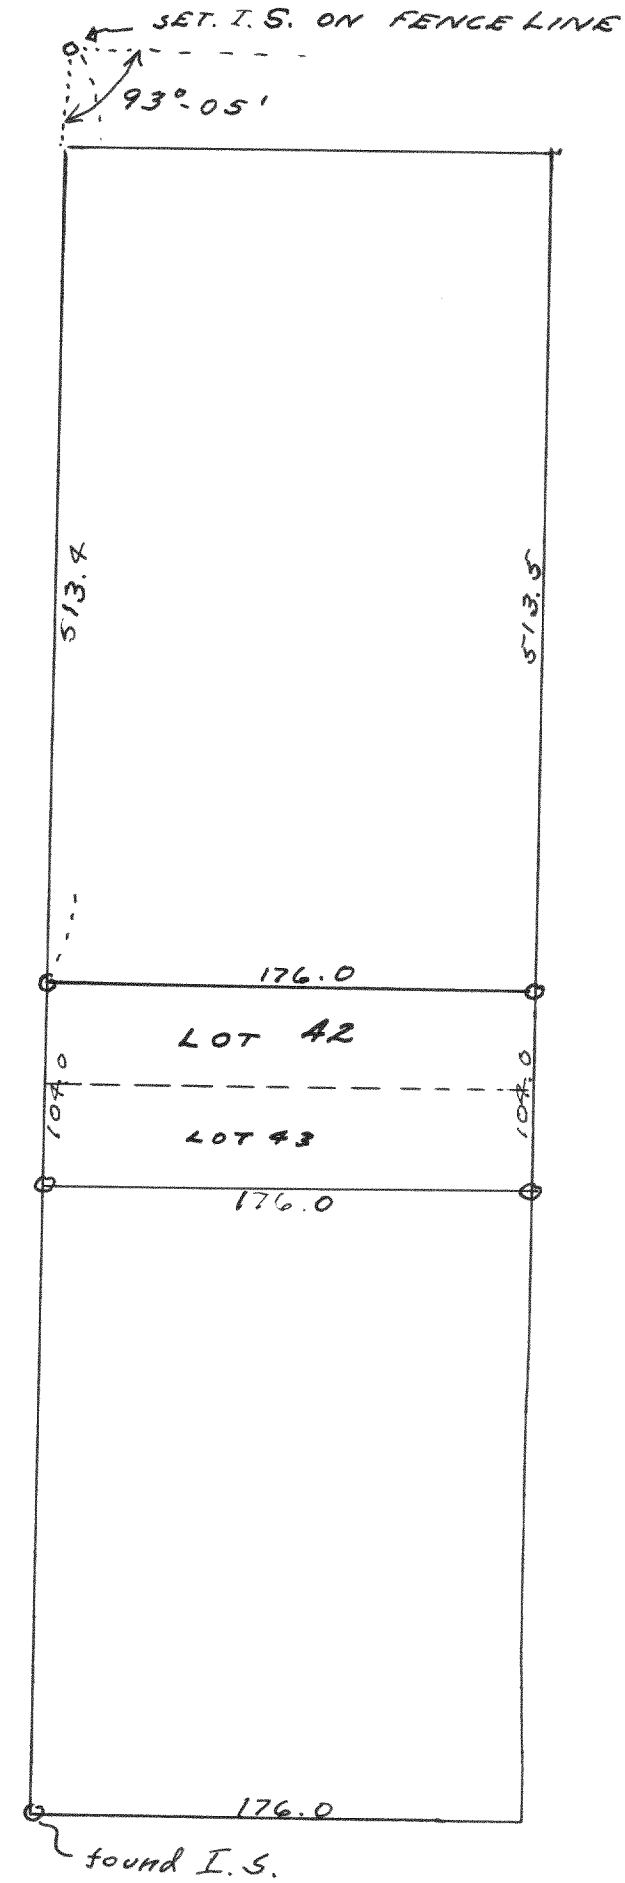

Survey of lots 42 & 43 of the
Shanahan Subd. in the Village
of Sharon
5-7-38
Lloyd L. Jensen
by H. E. J.

SURVEY No. 938

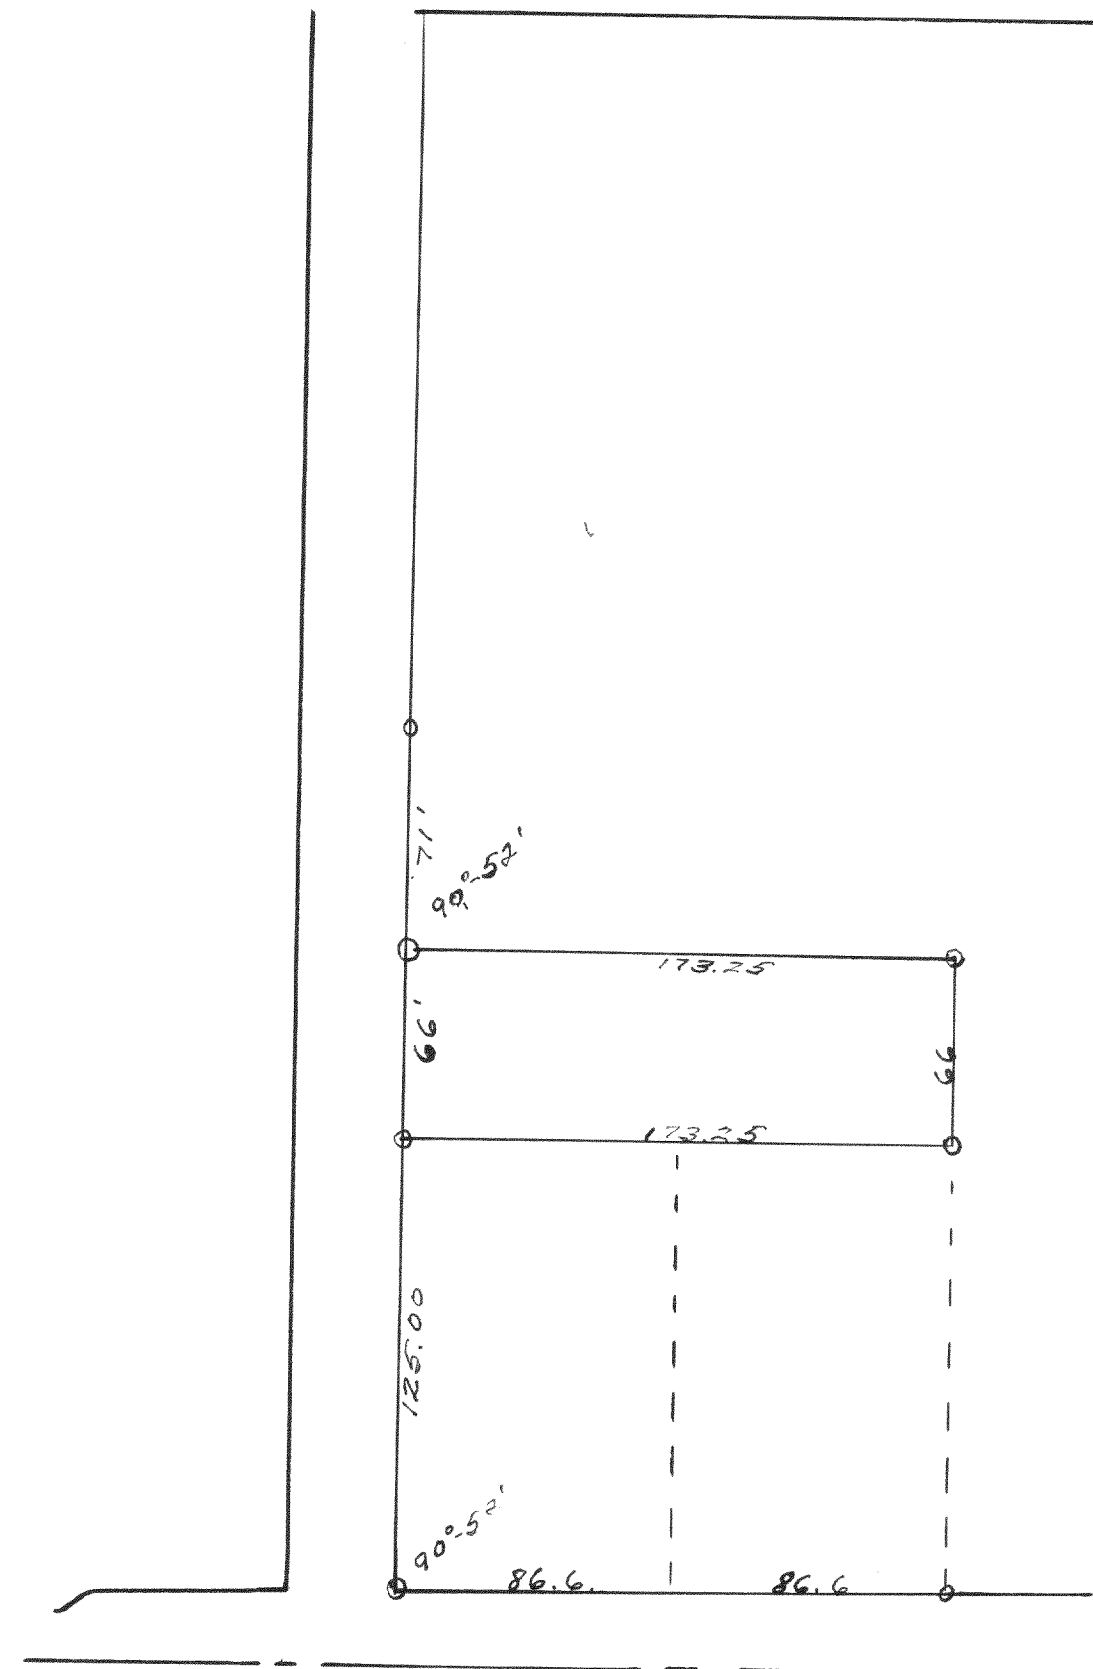

Survey of part of outlot 196
of the Assessors plat of
the Village of Marworth.