



SURVEY No. 944

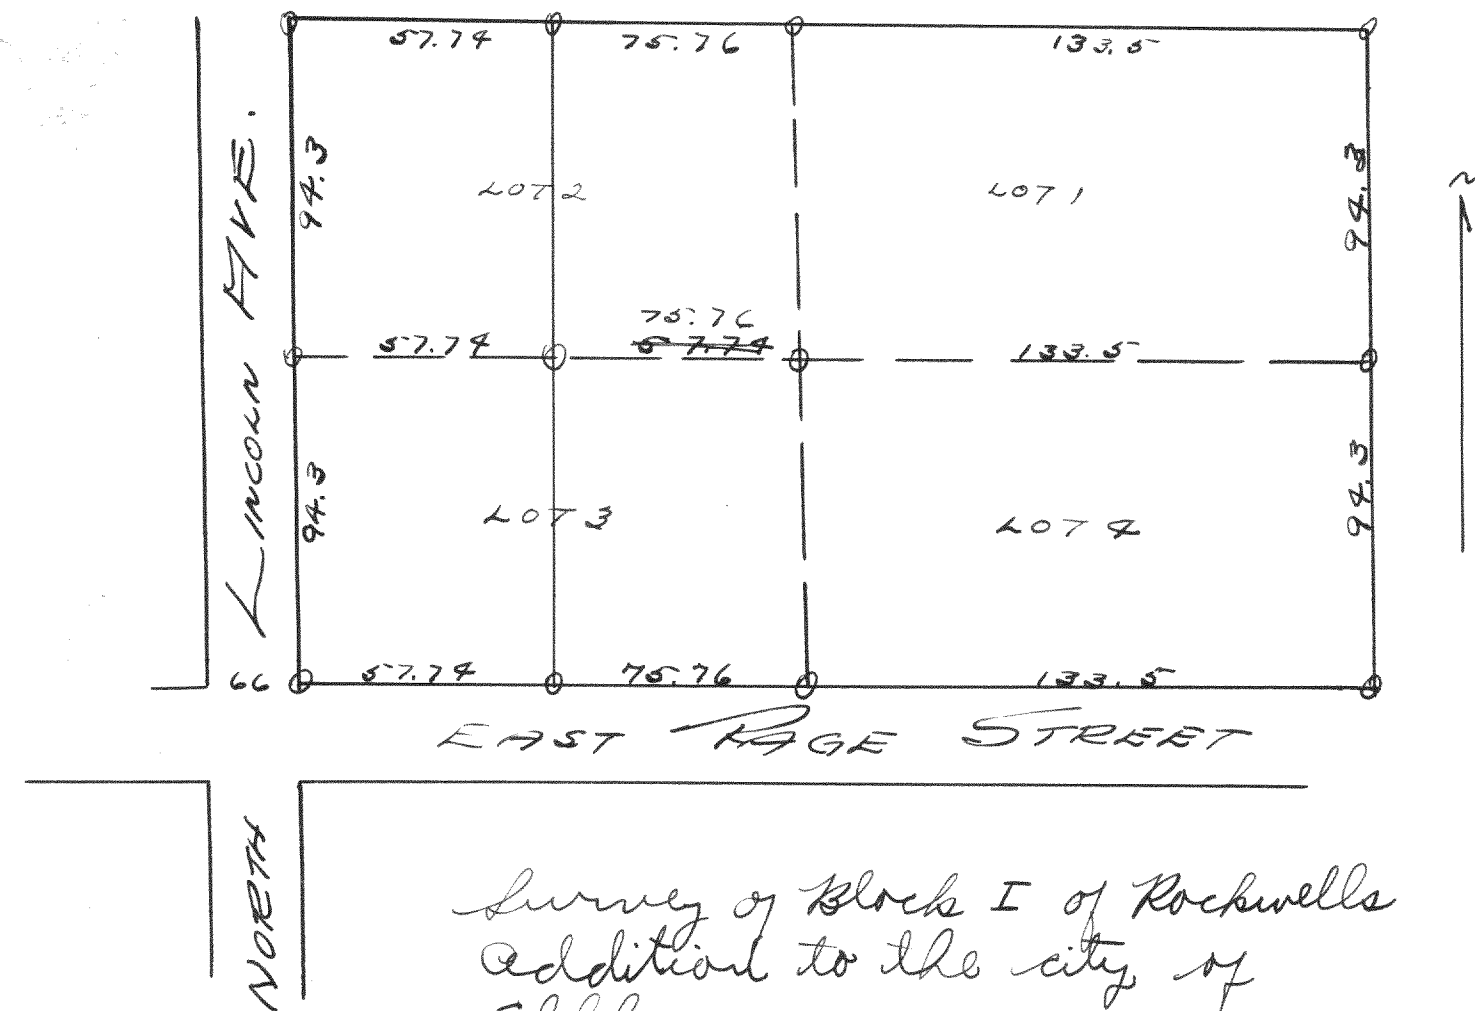

Survey of Block I of Rockwells
Addition to the city of
Elkhorn
April 1937

Lloyd L. Jensen
by H. E. J.


SURVEY No. 945

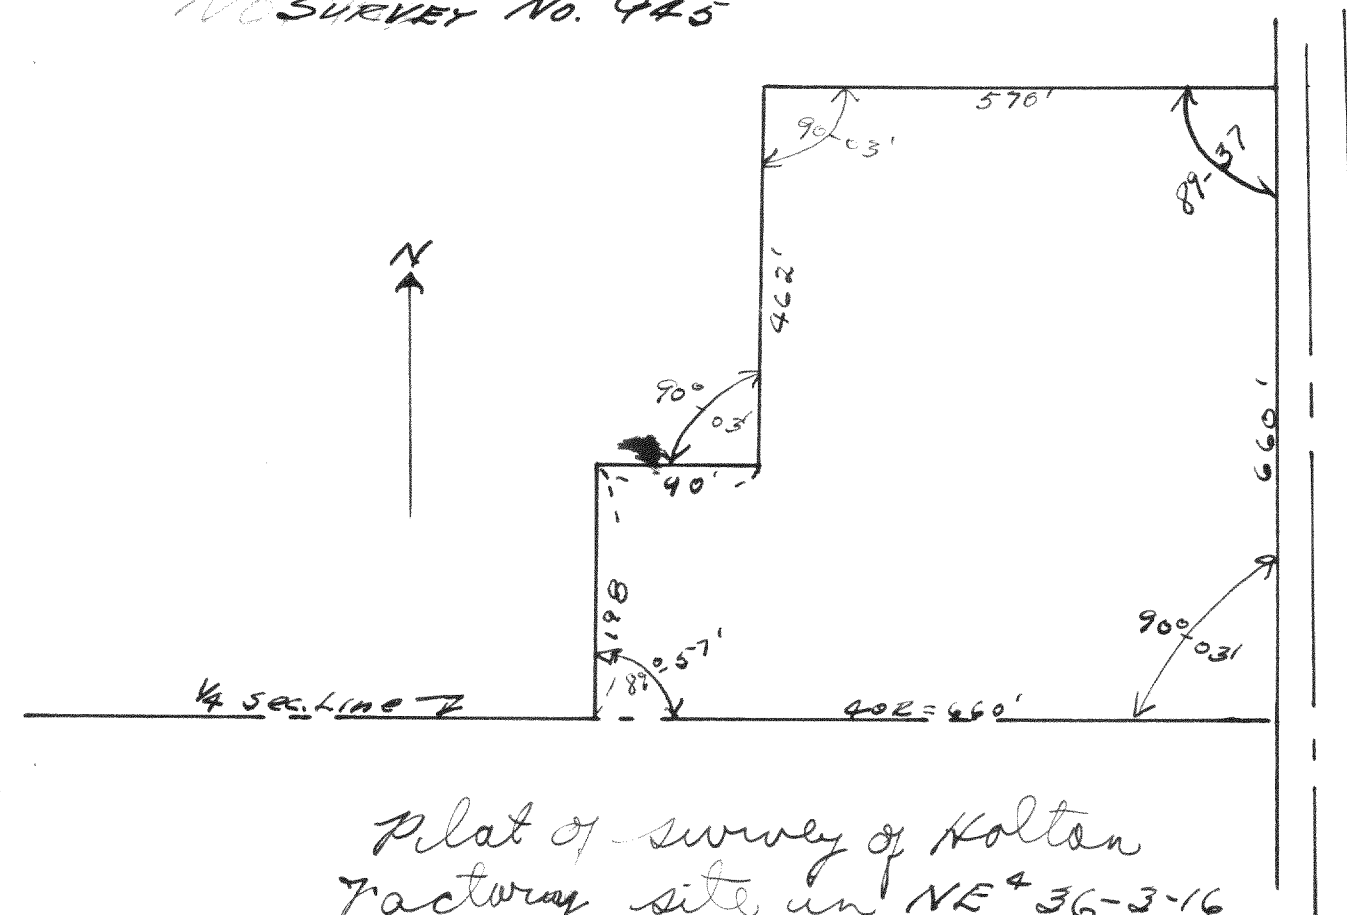

Plot of survey of Kolton
Factory site in NE 1/4 36-3-16
in the city of Elkhorn
August 1938

Lloyd L. Jensen
by H. E. J.

SURVEY No. 946

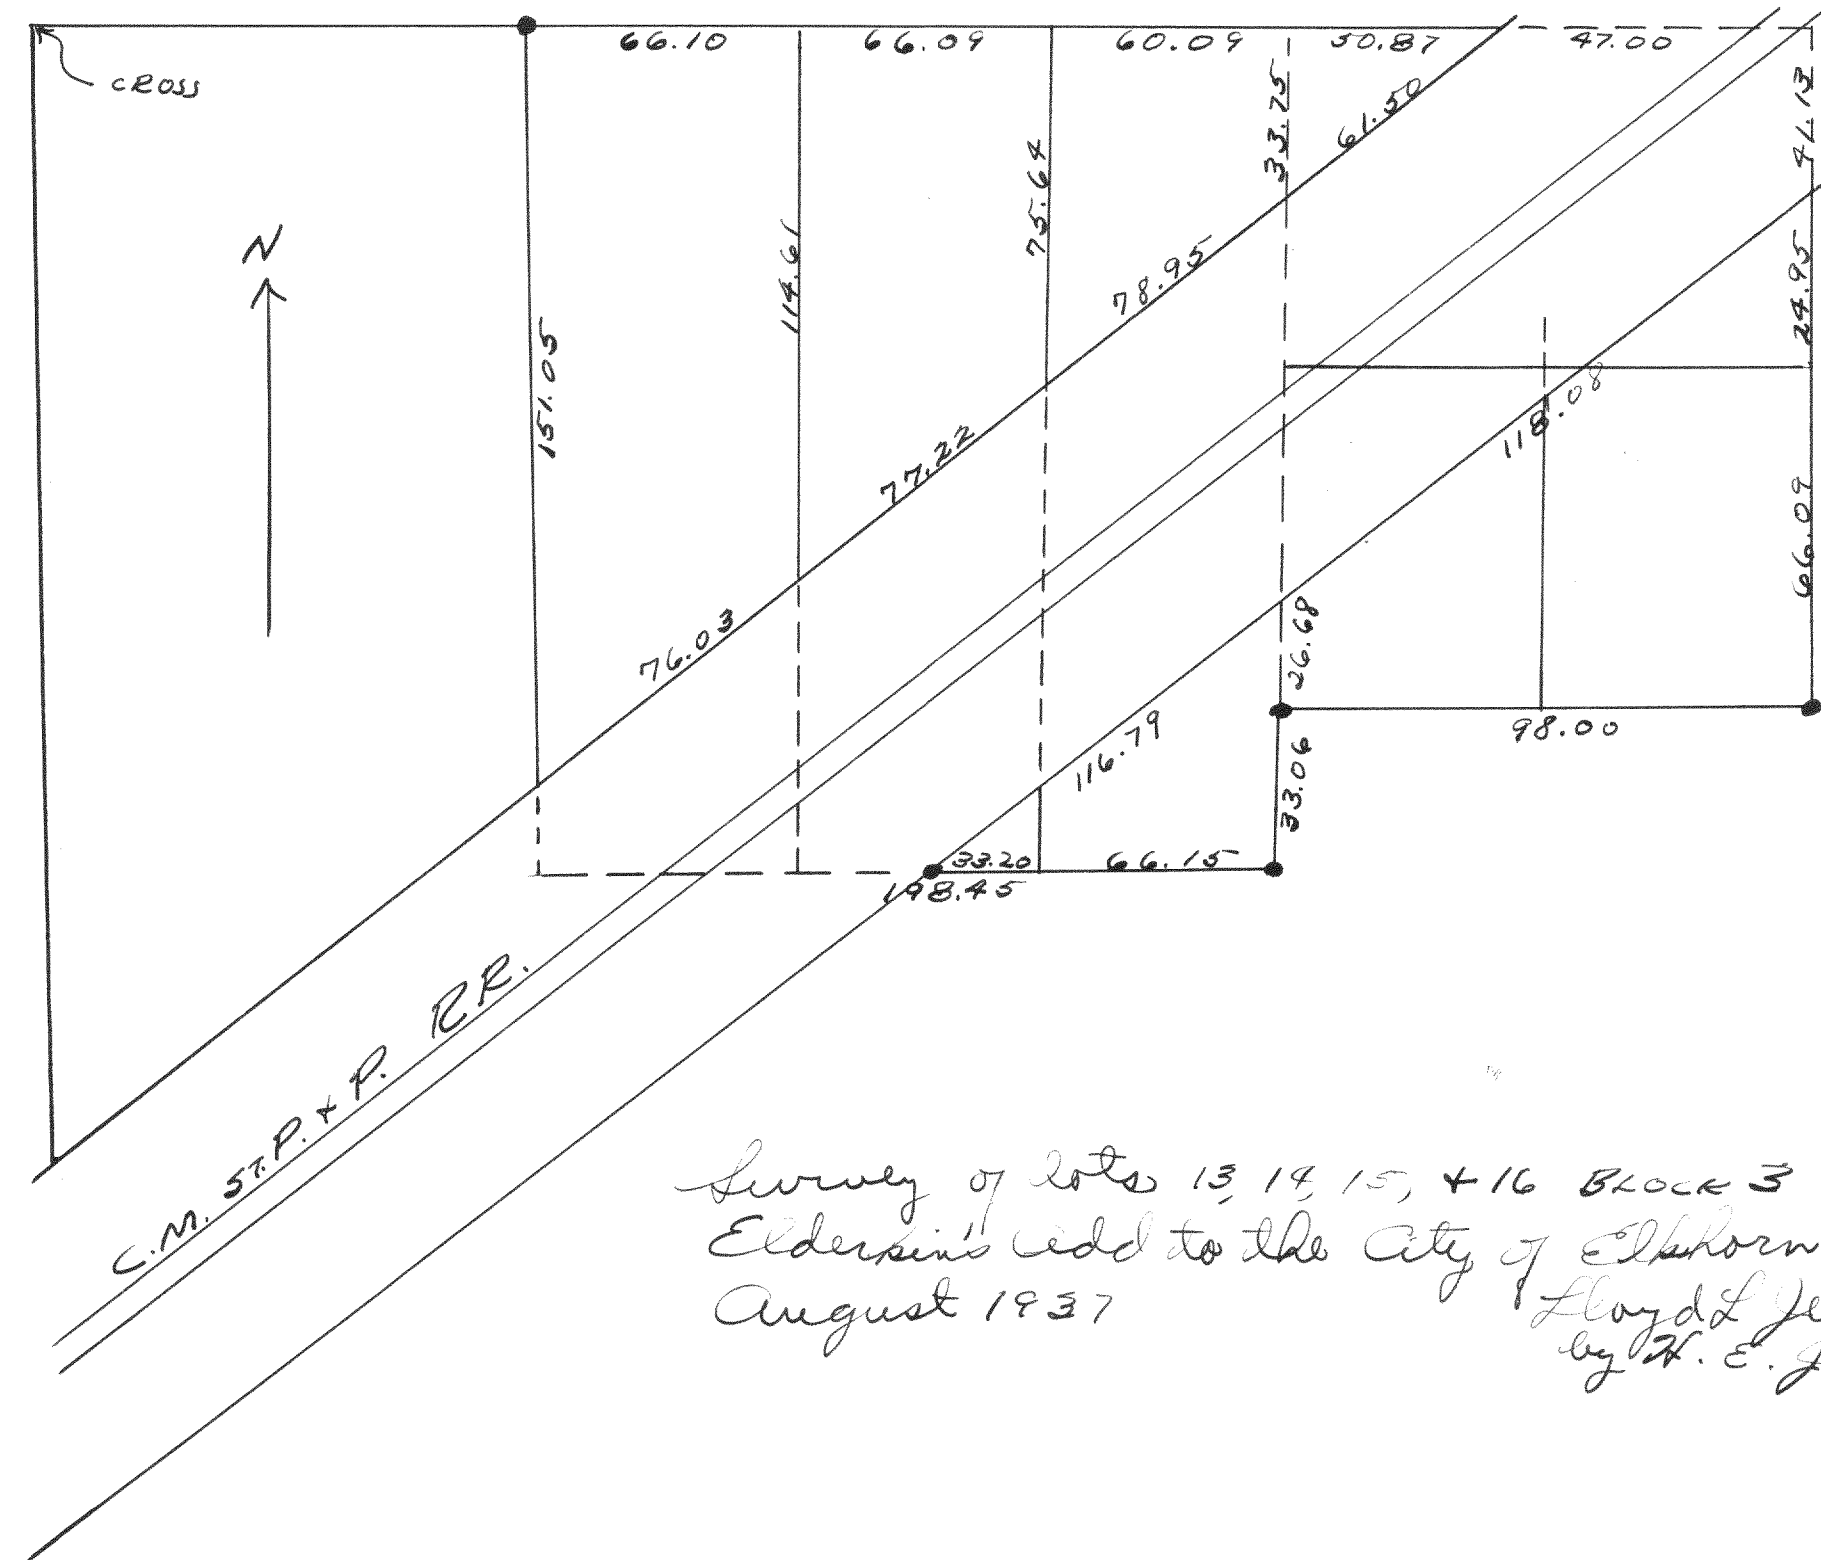

Survey of lots 13, 14, 15, & 16 Block 3
Eldersin's add to the City of Elkhorn.
August 1937

Lloyd L. Jensen
by H. E. J.