


SURVEY No. 952

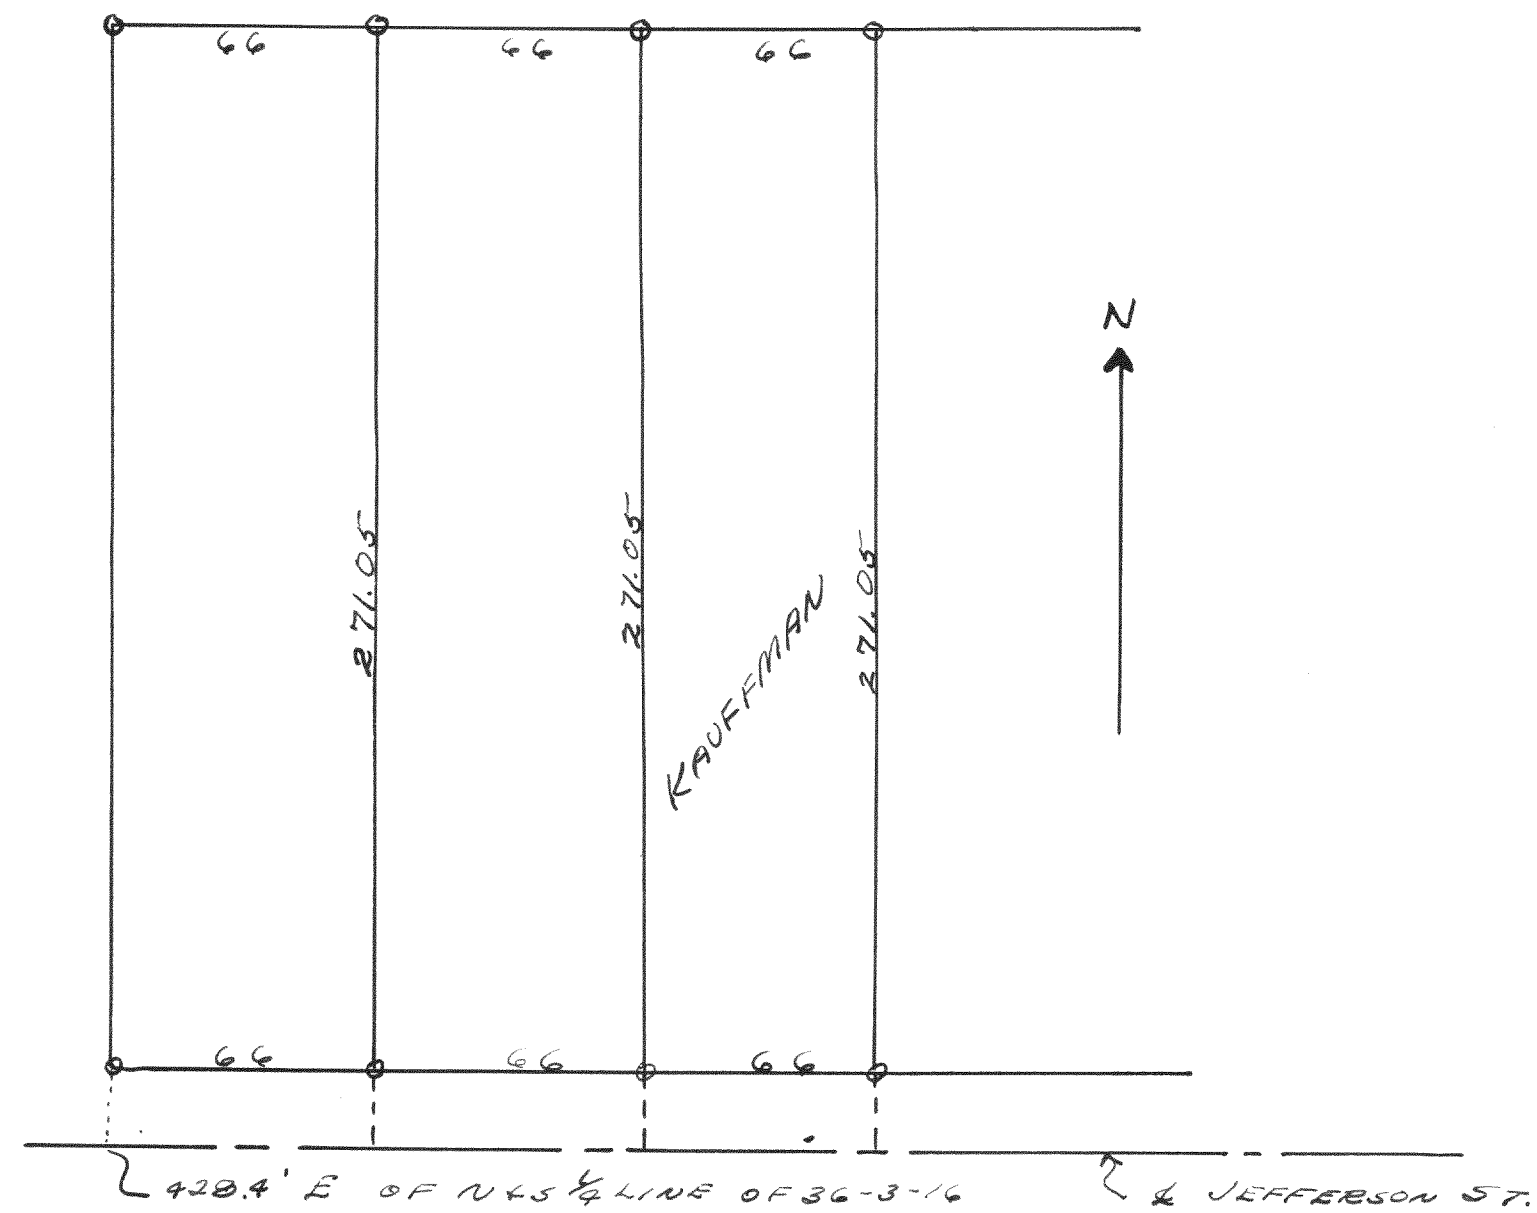


Survey for Clayton Kauffman in
City of Elkhorn sec 36-3-16

April 19, 1938

Lloyd L. Jensen
by N.E.J.

SURVEY No. 953

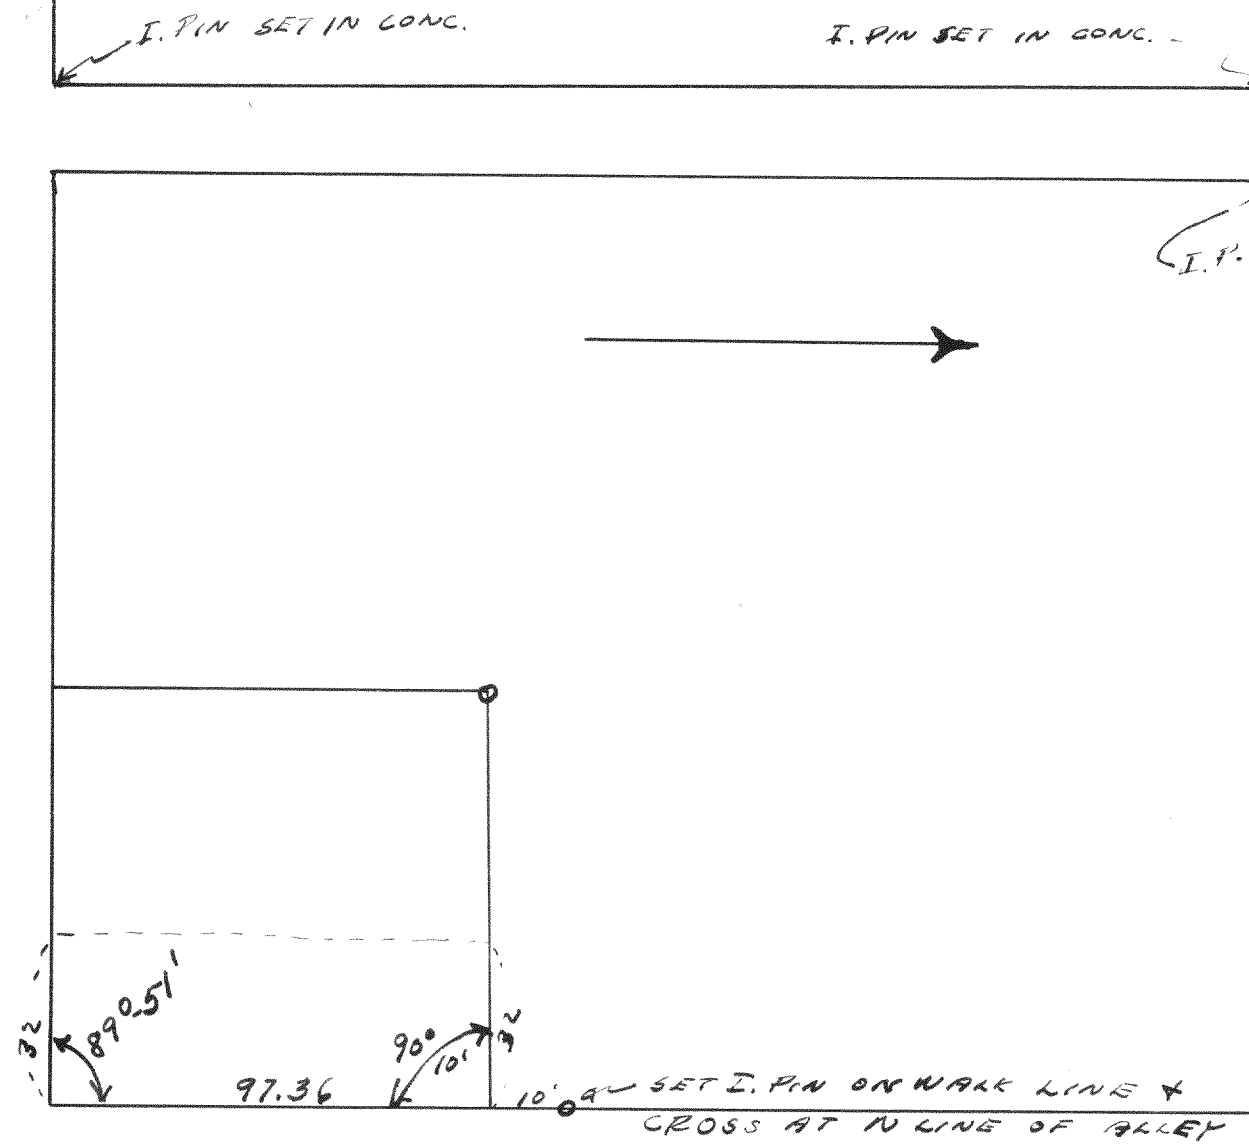

Survey of old post-office site
in block 20 of the original village
of Elkhorn.

10-30-37

Lloyd L. Jensen.