


No. 966

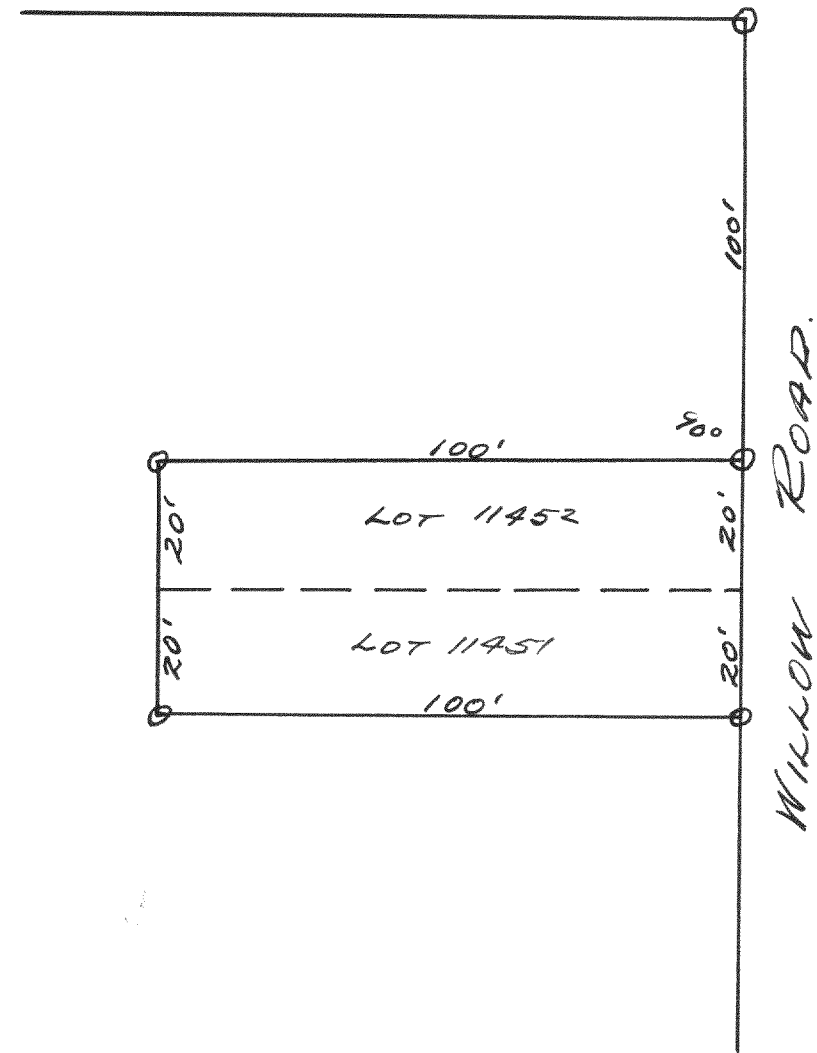


Plat of survey of lots 11451 & lot 11452
of Lake Como Beach Subd.

May 1939

Lloyd L. Jensen
N.E.J.

No. 967

319

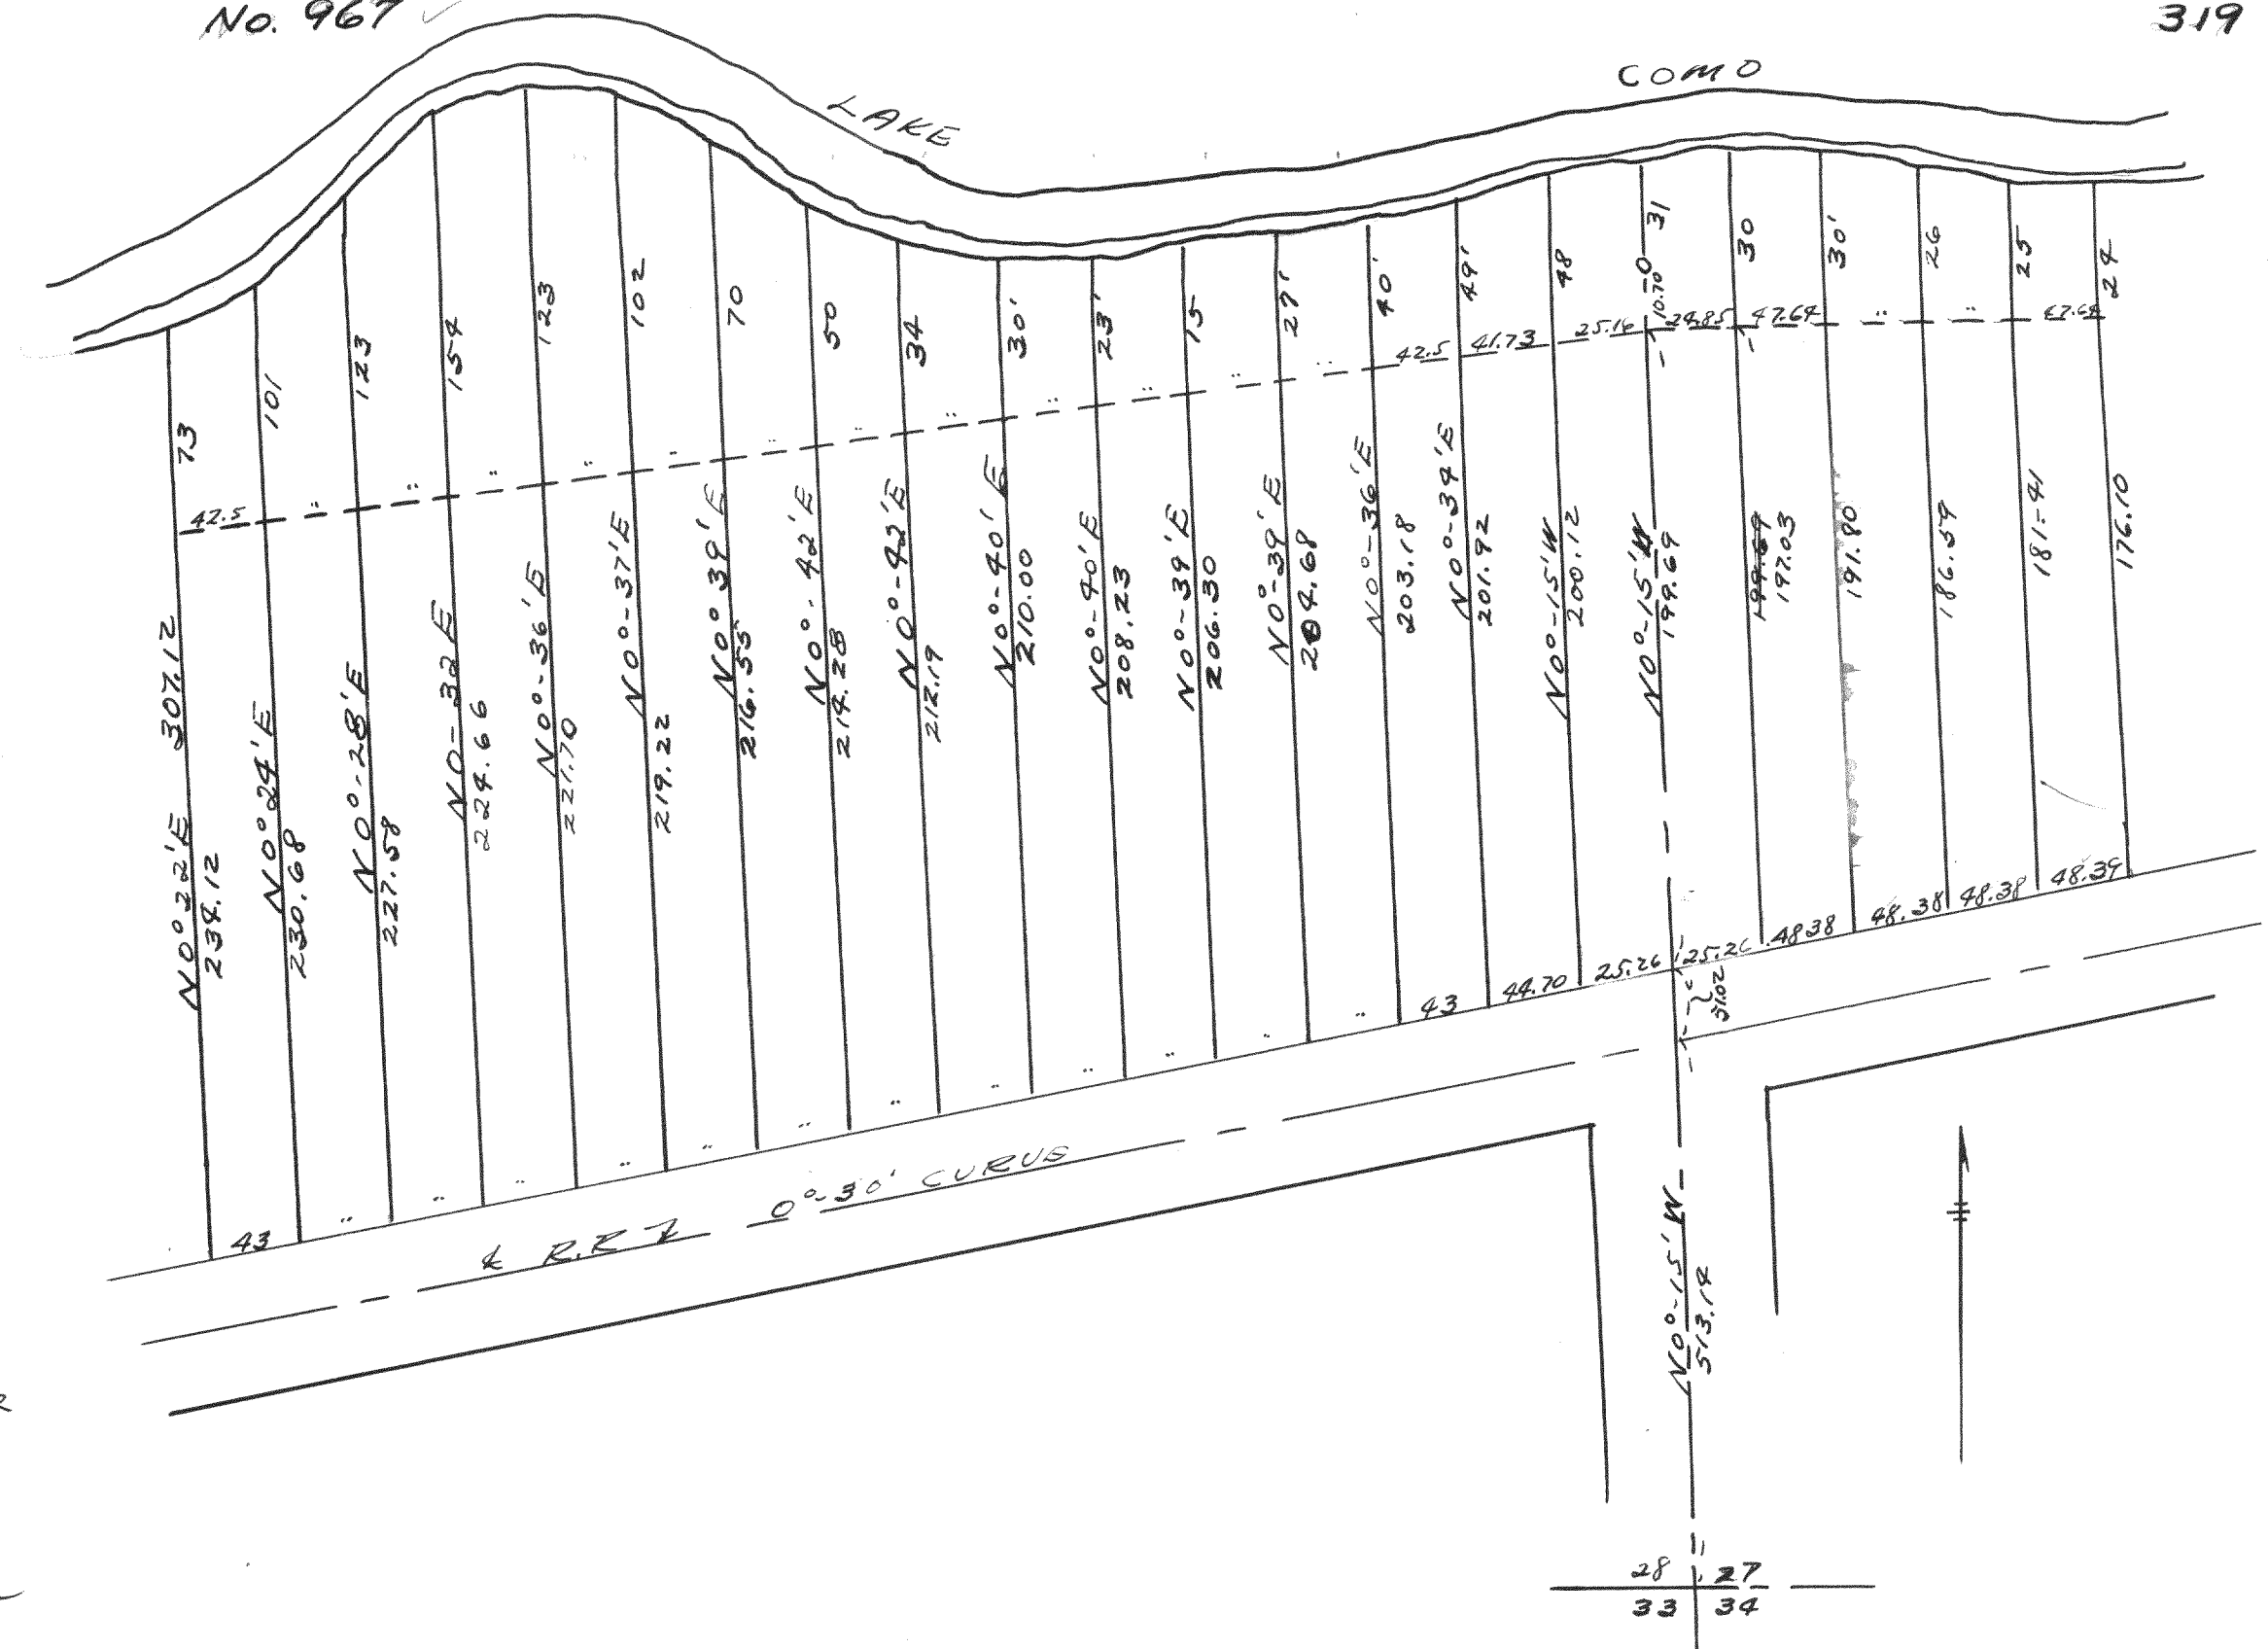

Plat of survey of part of the SE 1/4 of section 28
and part of the SW 1/4 of section 27 of T2N R17E
July, 1938
Lloyd L. Jensen
by N.E.J.