


SURVEY No. 968 ✓

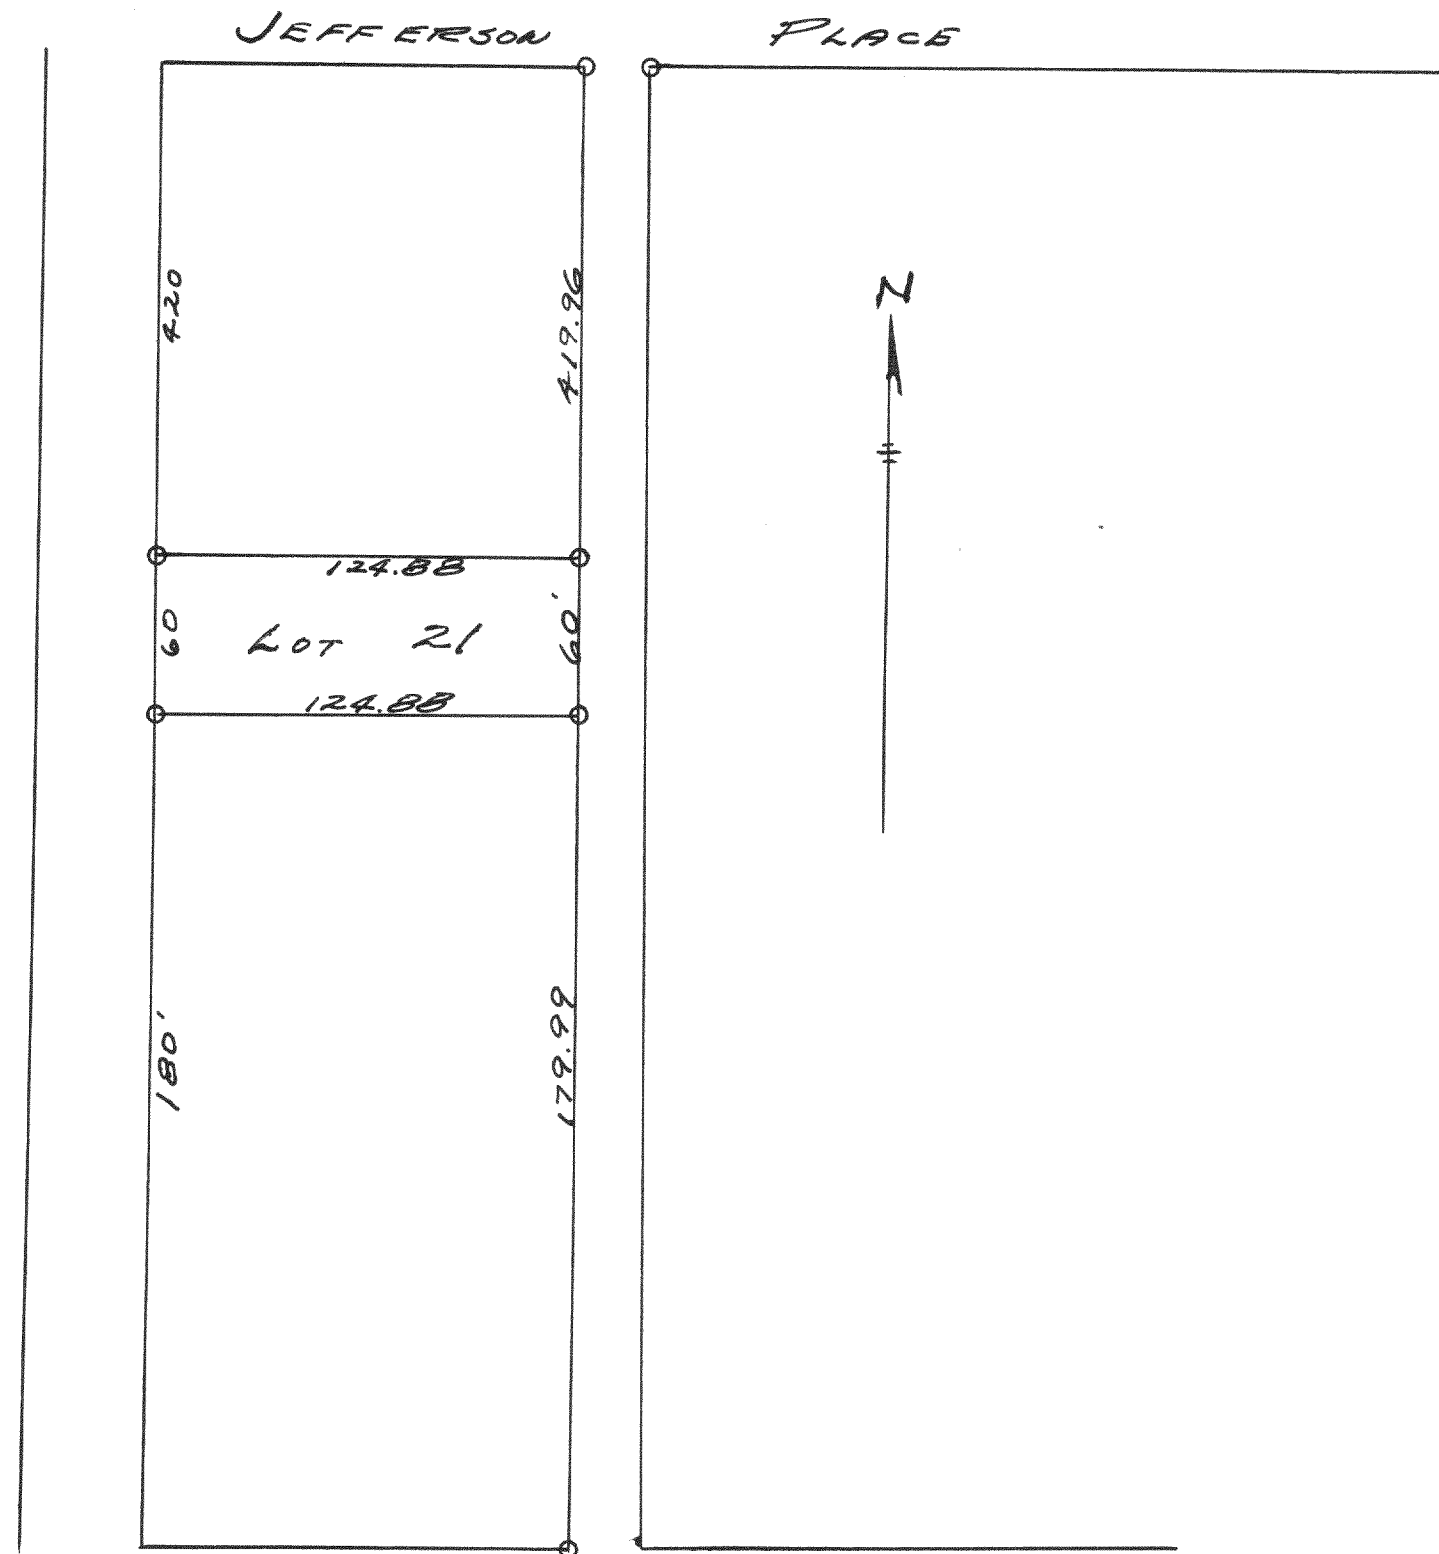


Plat of survey of Lot 21 of the original subdivision of Cedar Point Park in the Village of Wms. Bay.

May 8, 1939

Lloyd L. Jensen
by H. E. J.

SURVEY No. 969 ✓

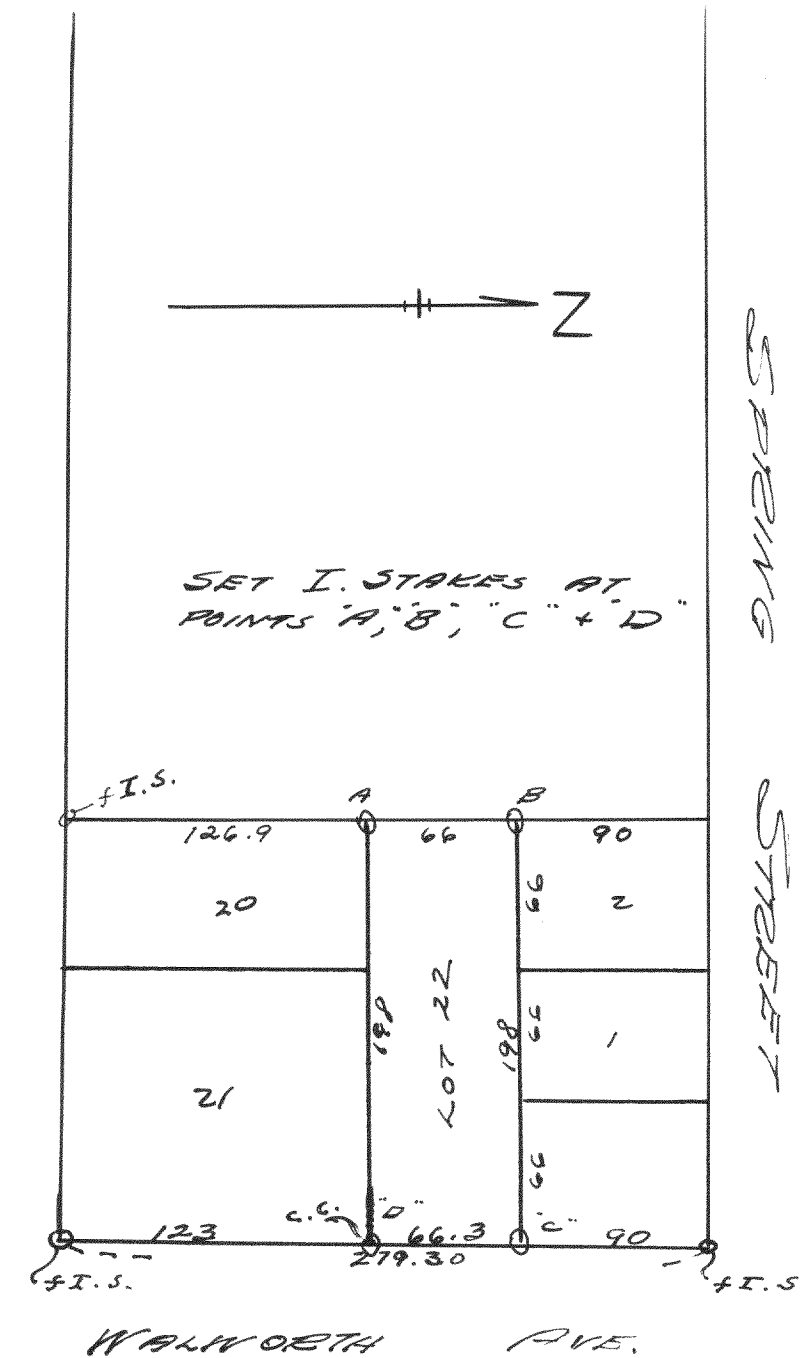

Plat of survey of Lot 22 of Johnson's Addition to the Village of Wms. Bay.

Jan., 1939

Lloyd L. Jensen
by H. E. J.