


SURVEY NO. 976

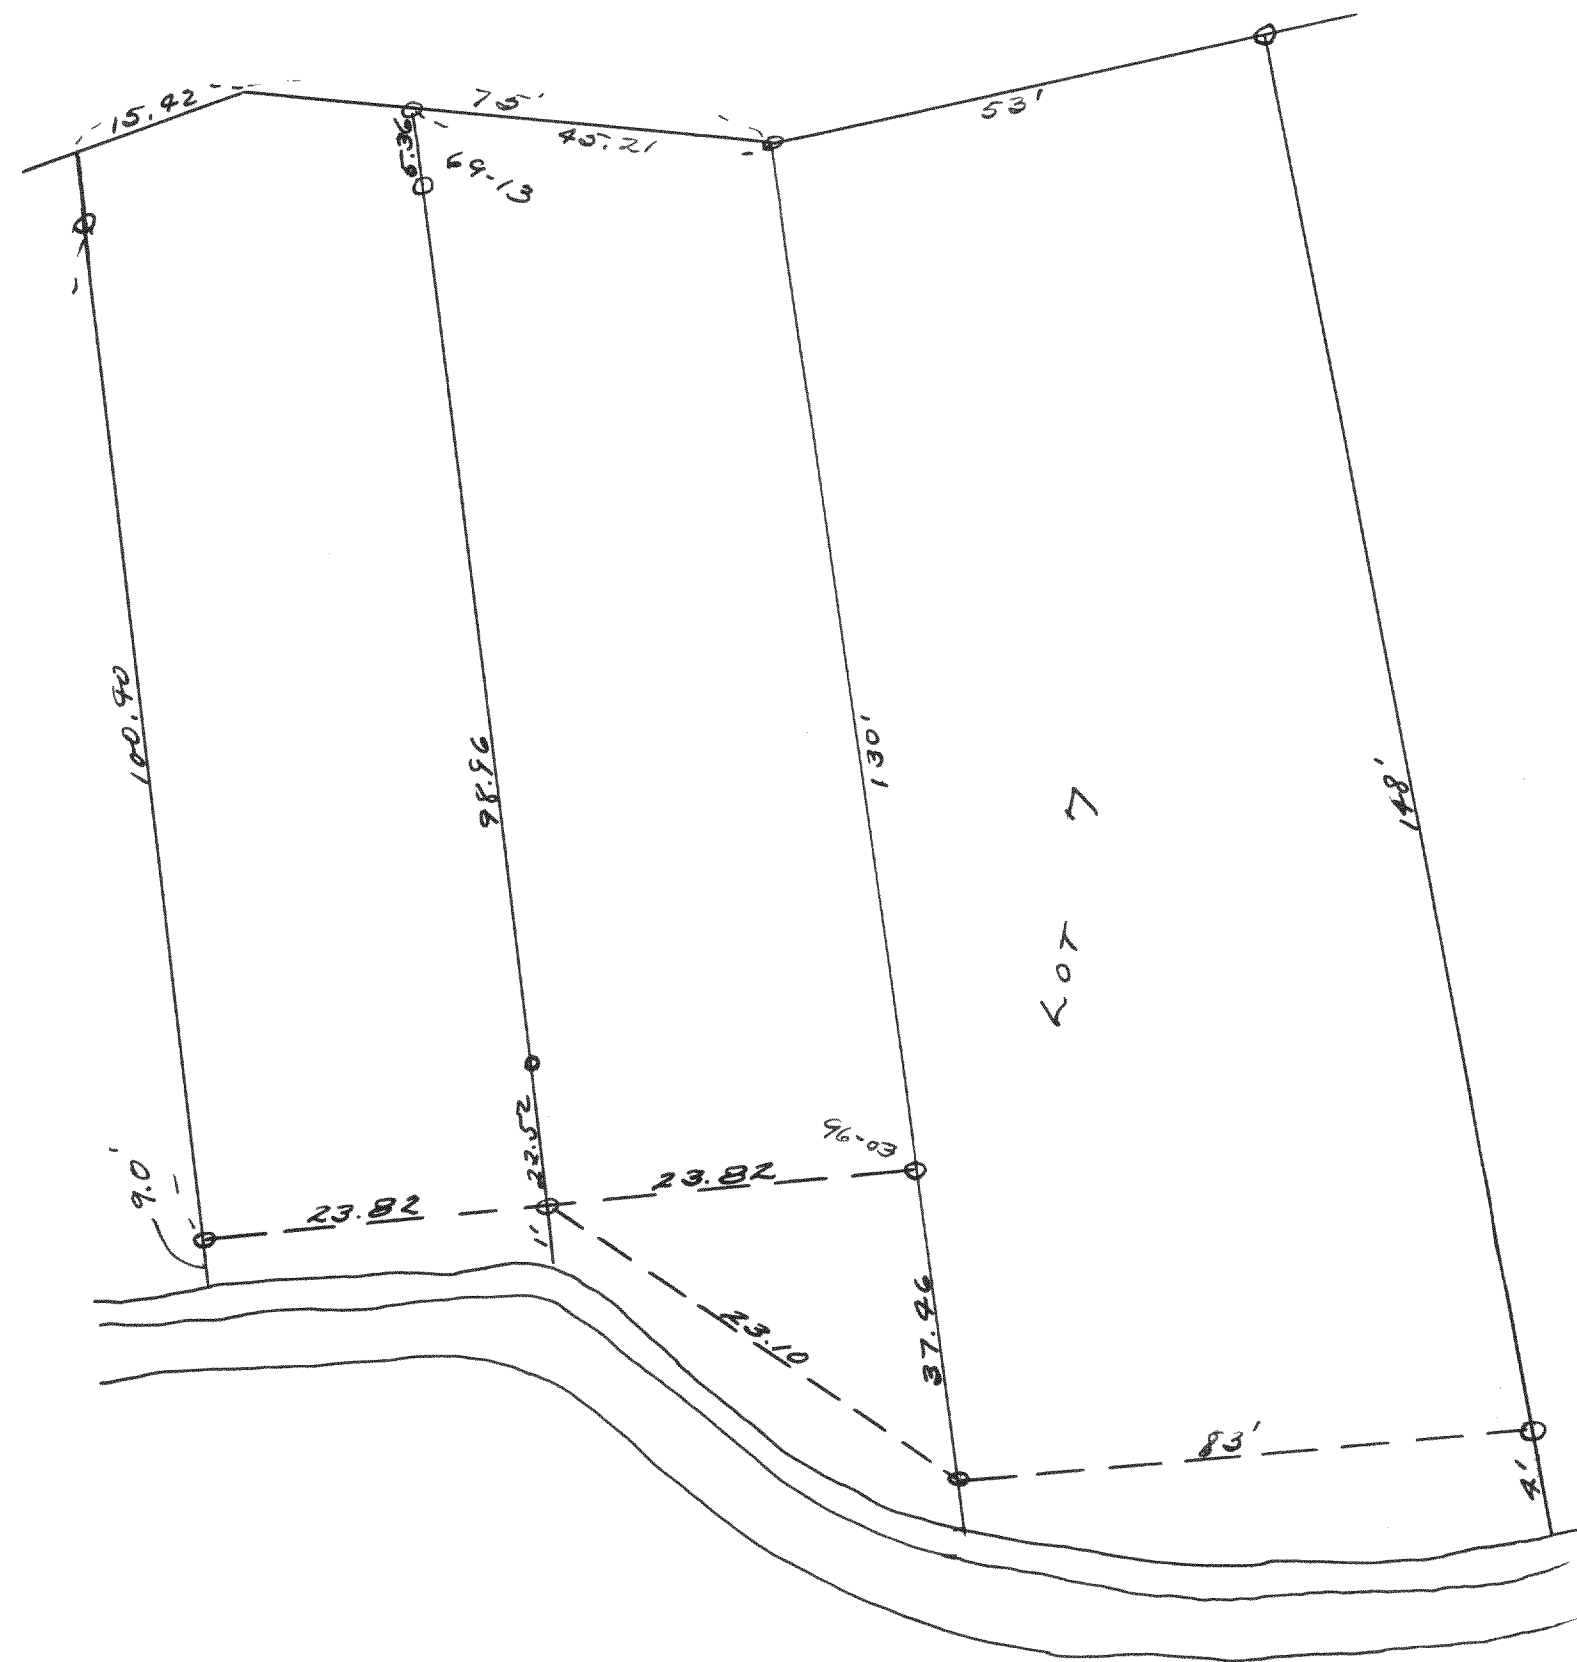


Survey of Lot 7 & dividing vacant lot
just north of Lot 7 - 4 Roughwood Park.

622-39

Lloyd L. Jensen
by K.E.L.

SURVEY NO. 977

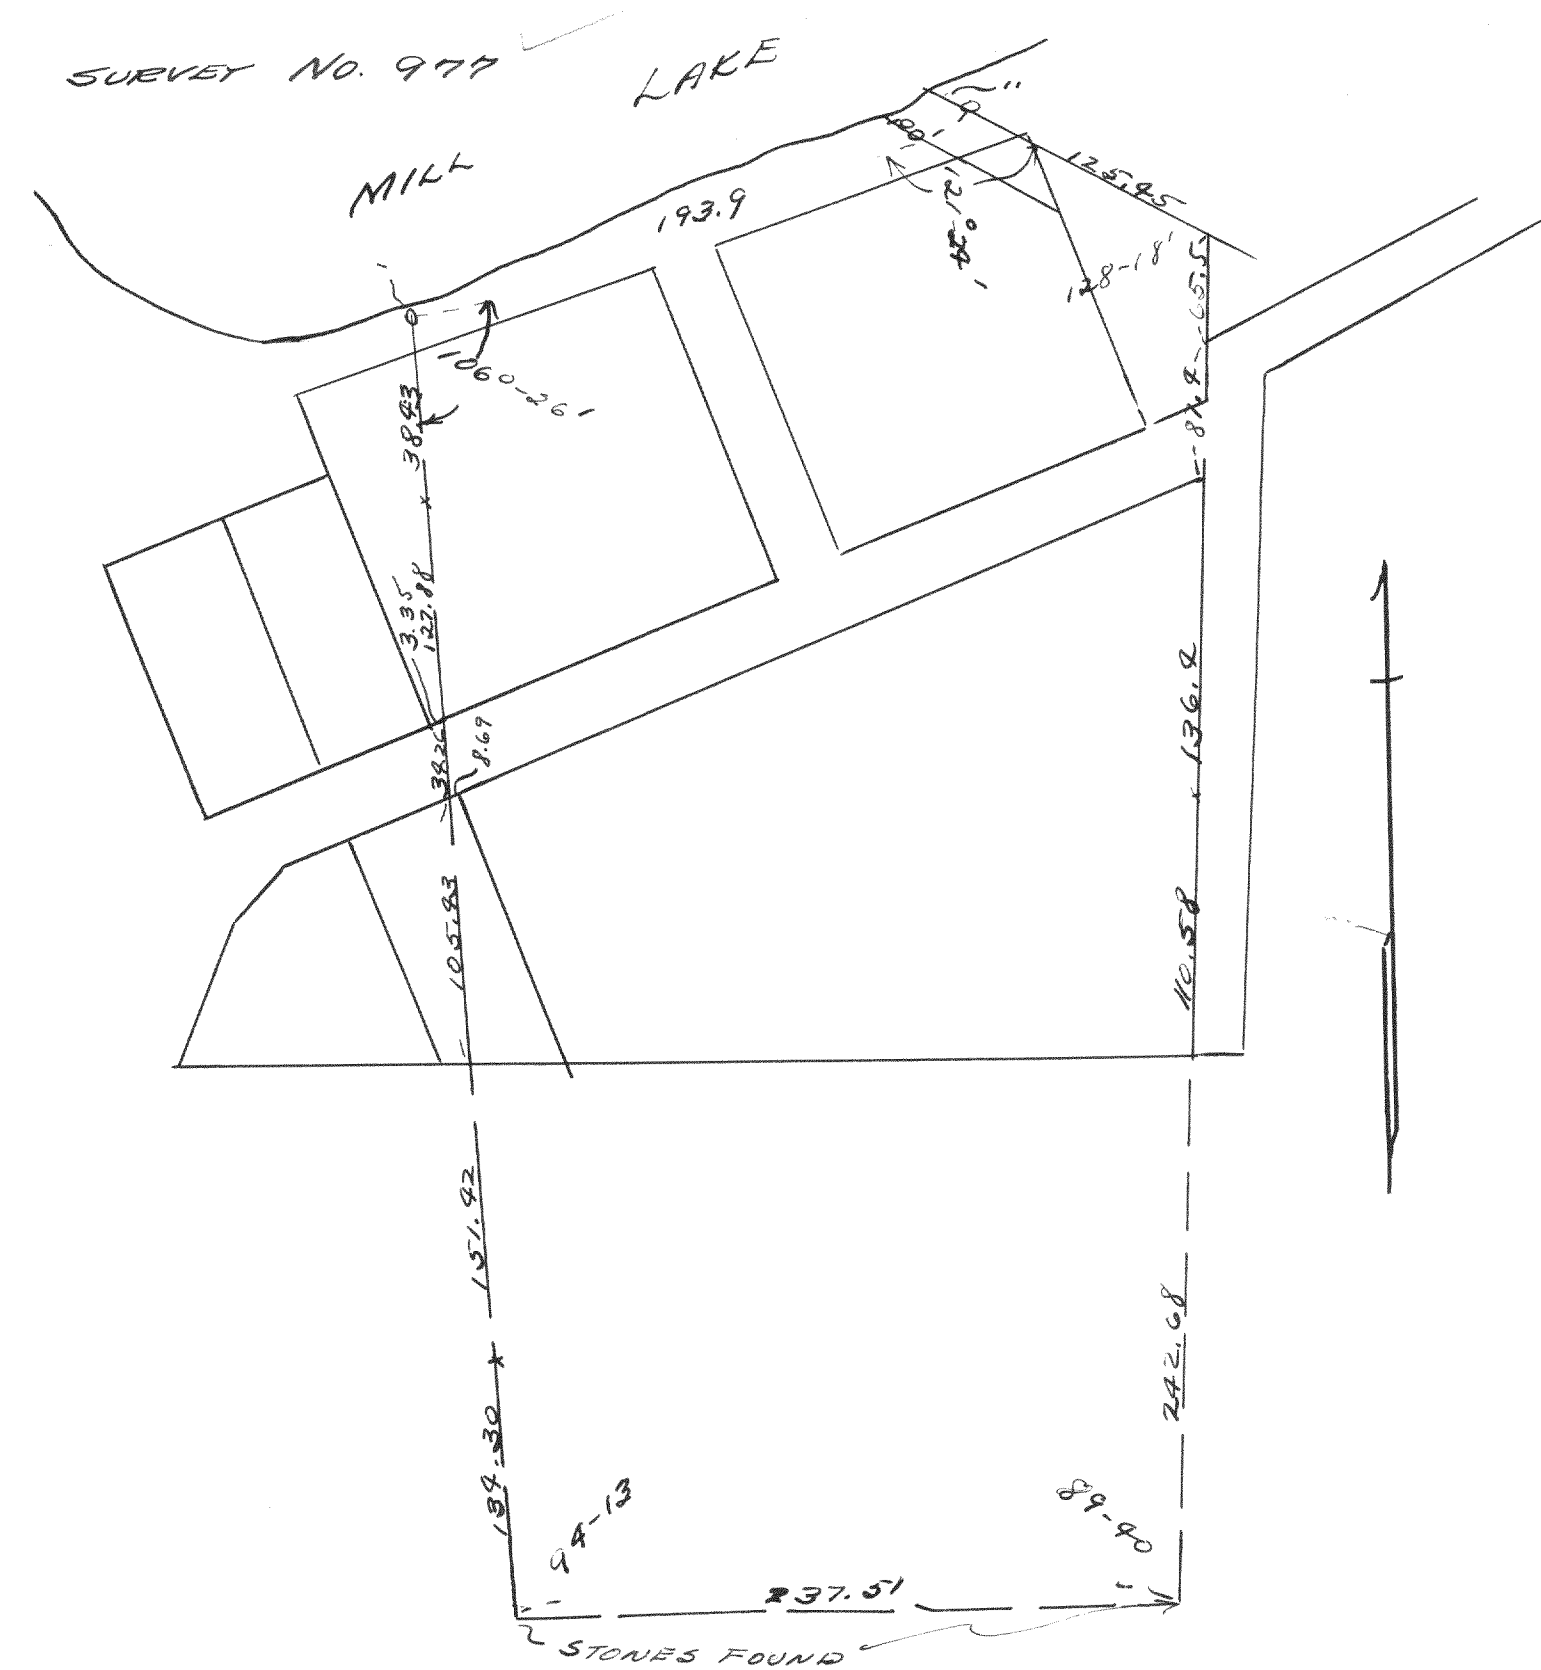

Plot of Survey of Landerdale
Heights & adjoining land.

July 1938

Lloyd L. Jensen
by K.E.L.