




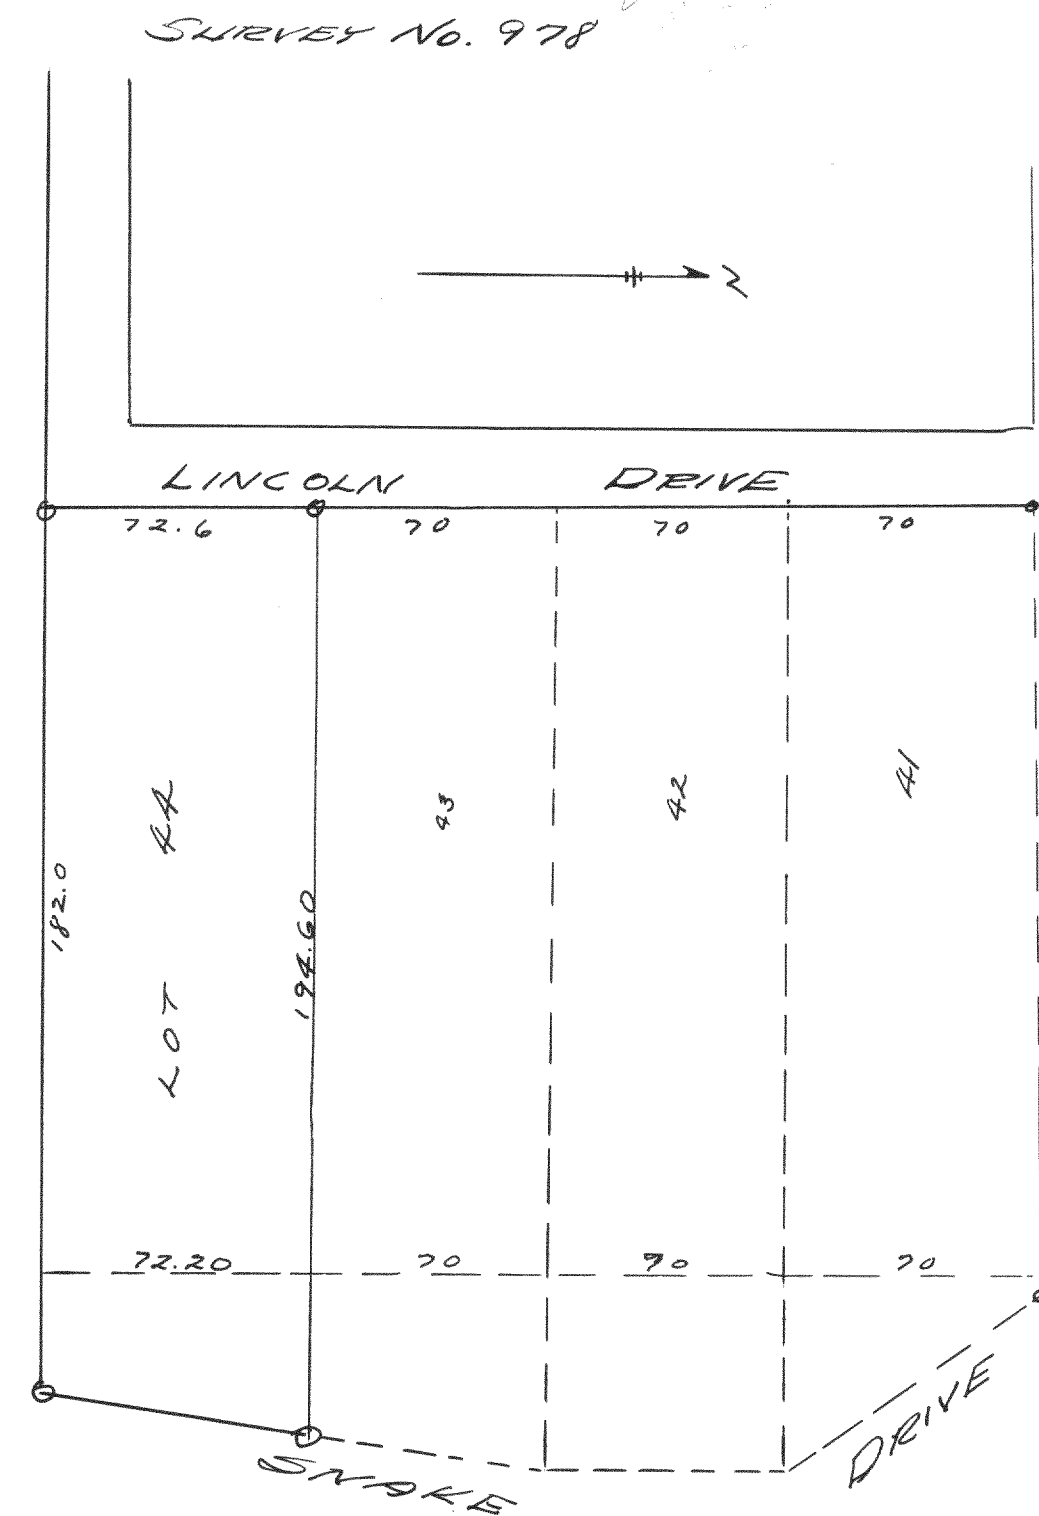

Plat of survey of Lot 44 of
Lackey Bros. Subdivision
in the Village of Wms. Bay.
June, 1939
Lloyd L. Jensen
by H. C. J.

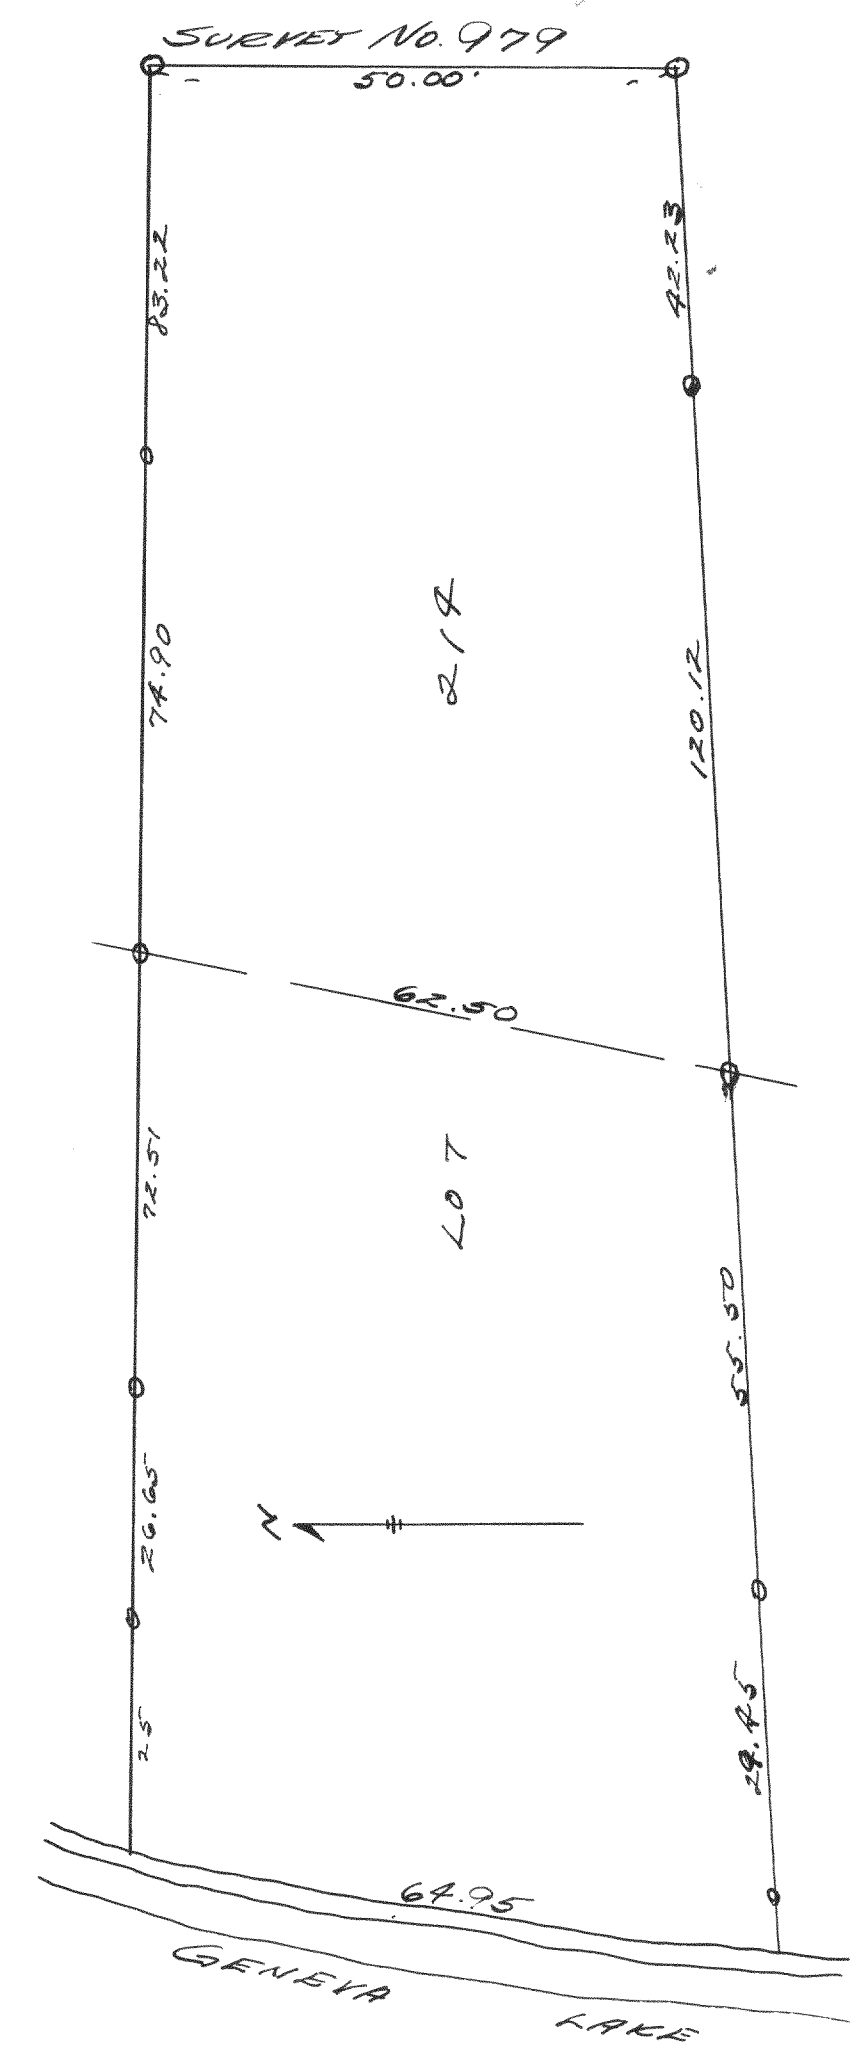

Plat of survey of lot 217 of the
3RD add to Cedar Point Park,
in the Village of Wms. Bay.
June, 1939
Lloyd L. Jensen
by H. C. J.

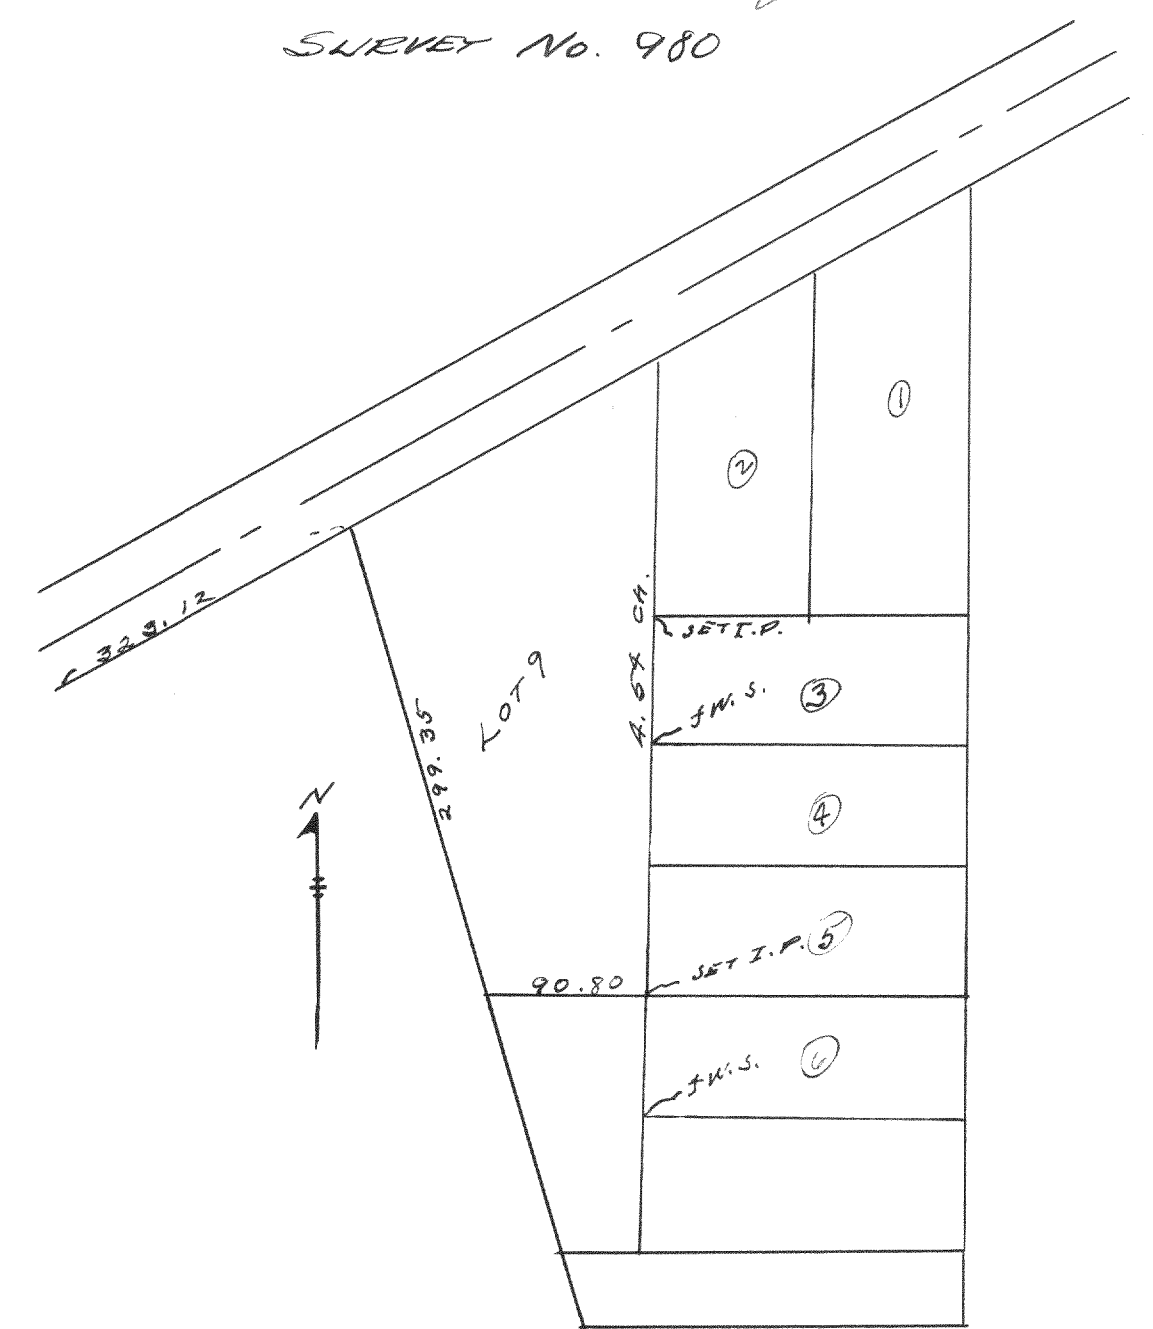

Plat of survey of that part
of lot 9 which lies north of
the north line of lot 6
extended. All in Cairns
add. to the city of Whitewater
April 1939
Lloyd L. Jensen
by H. C. J.