



SURVEY No. 983

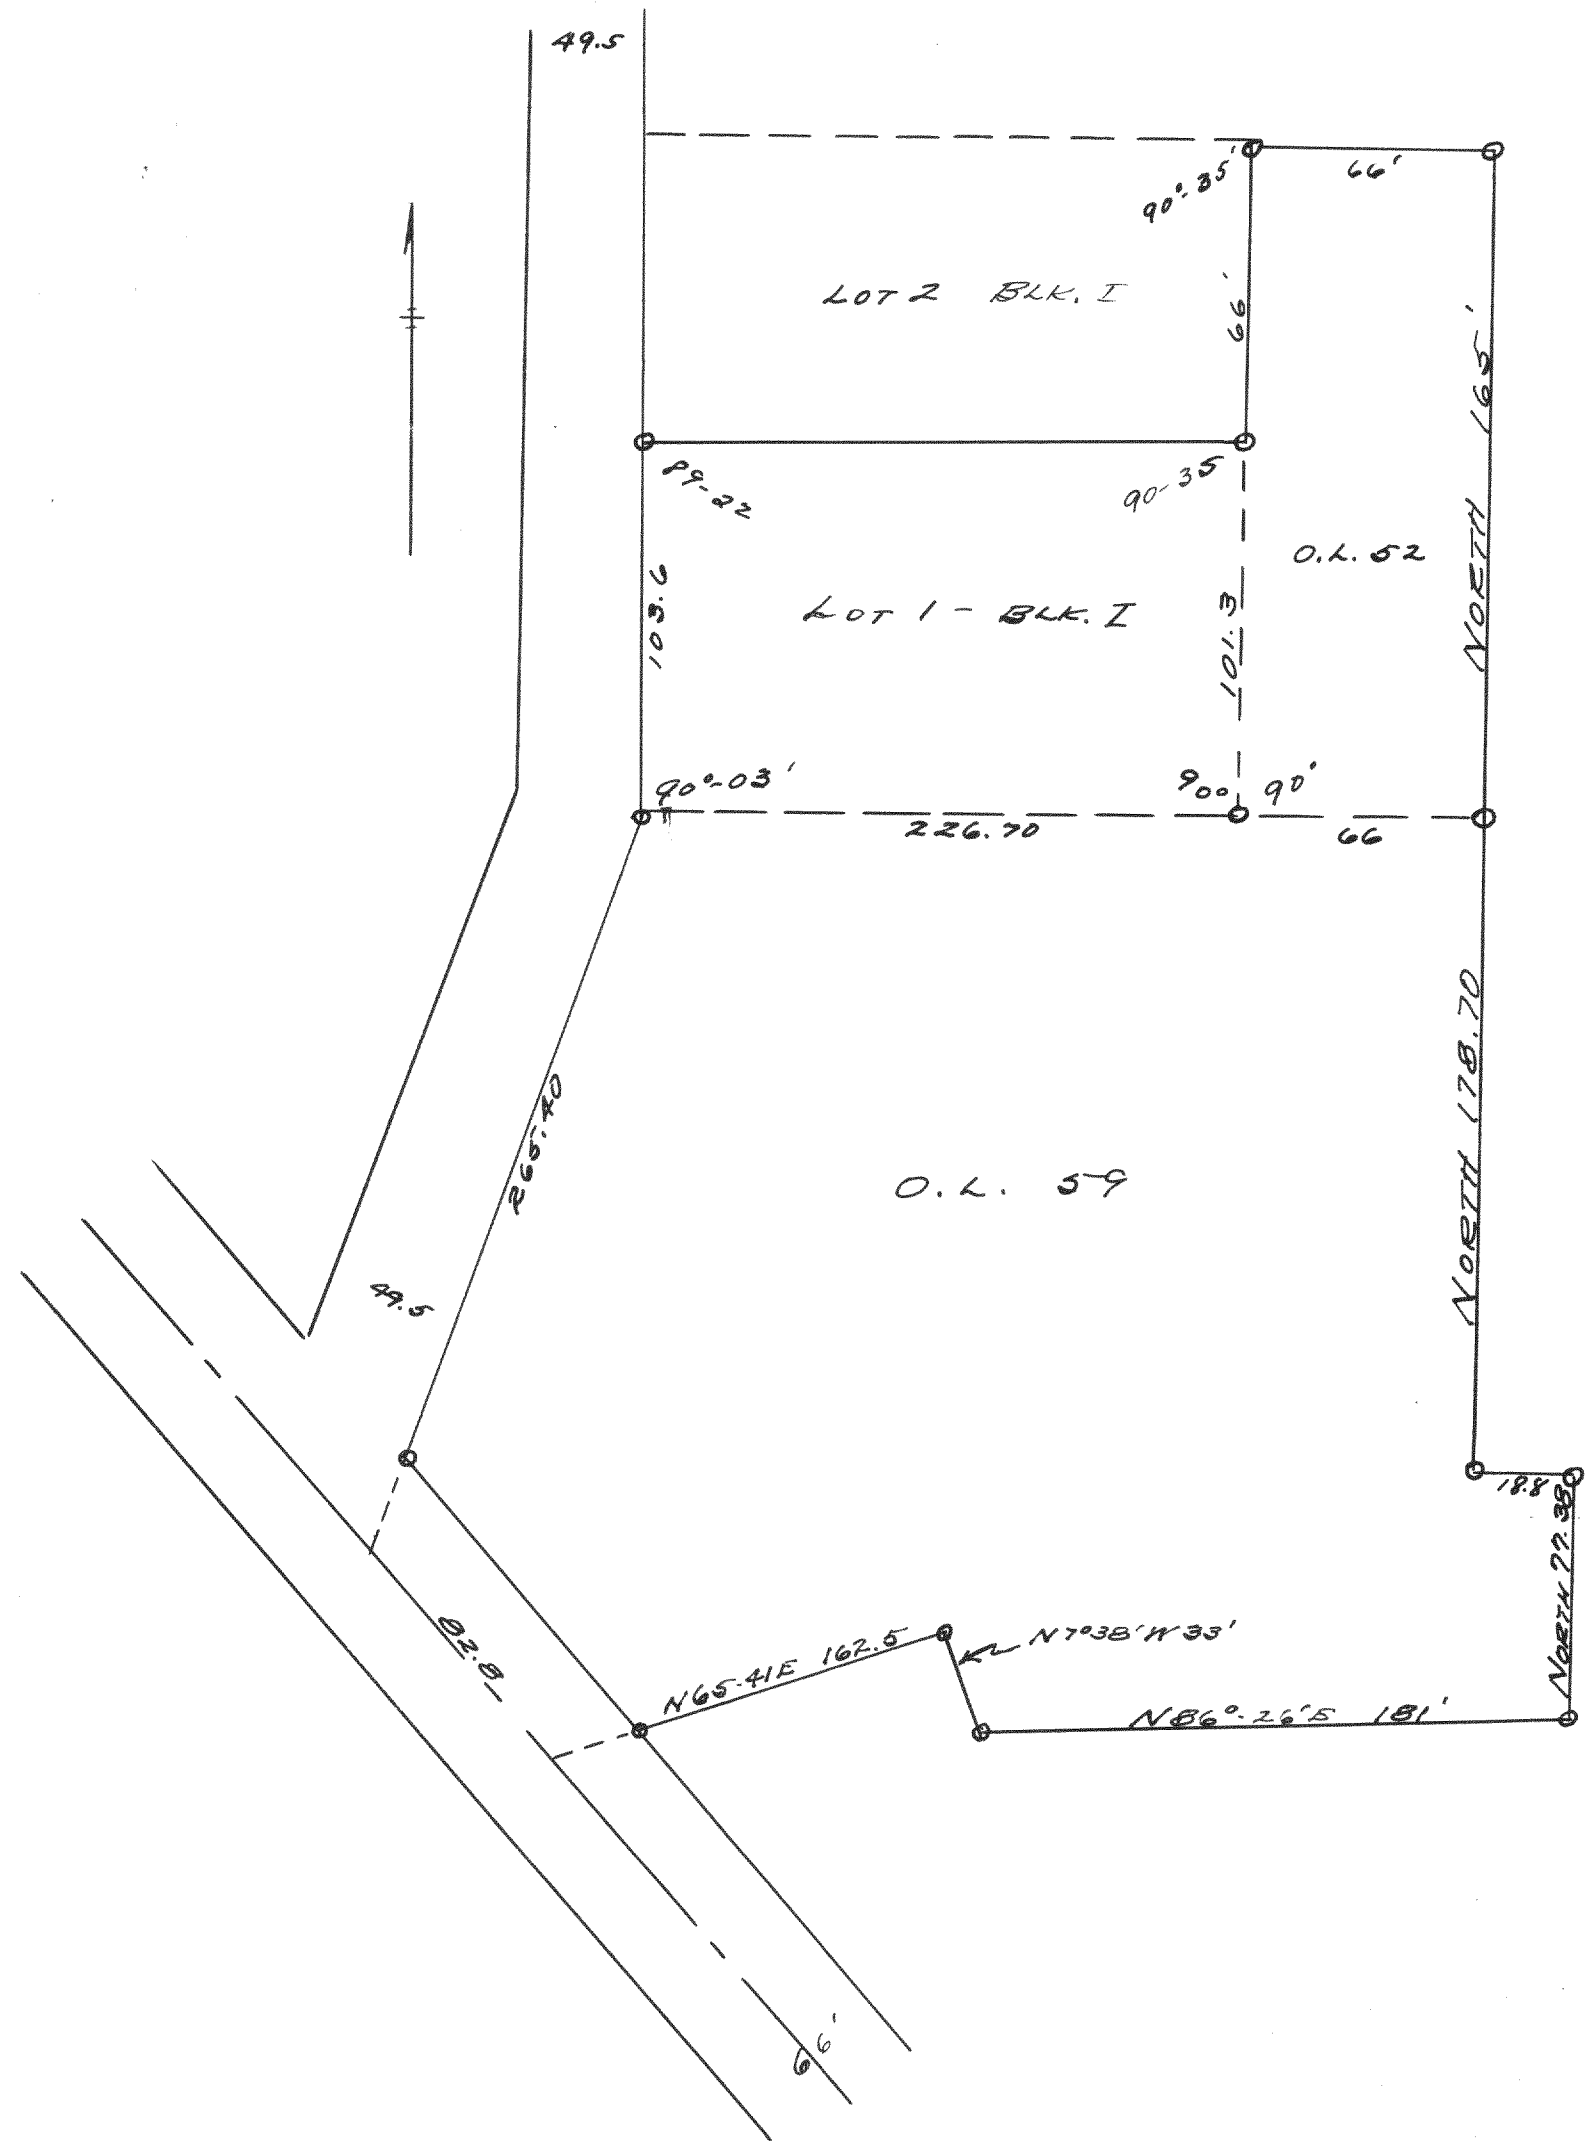

Plat of survey of outlots 52 & 59 and  
Lot I Block I of Crandall & Swinney's  
add. to the Village of Walworth  
December 5, 1938  
Lloyd L. Jensen  
by H. E. J.

SURVEY No. 984

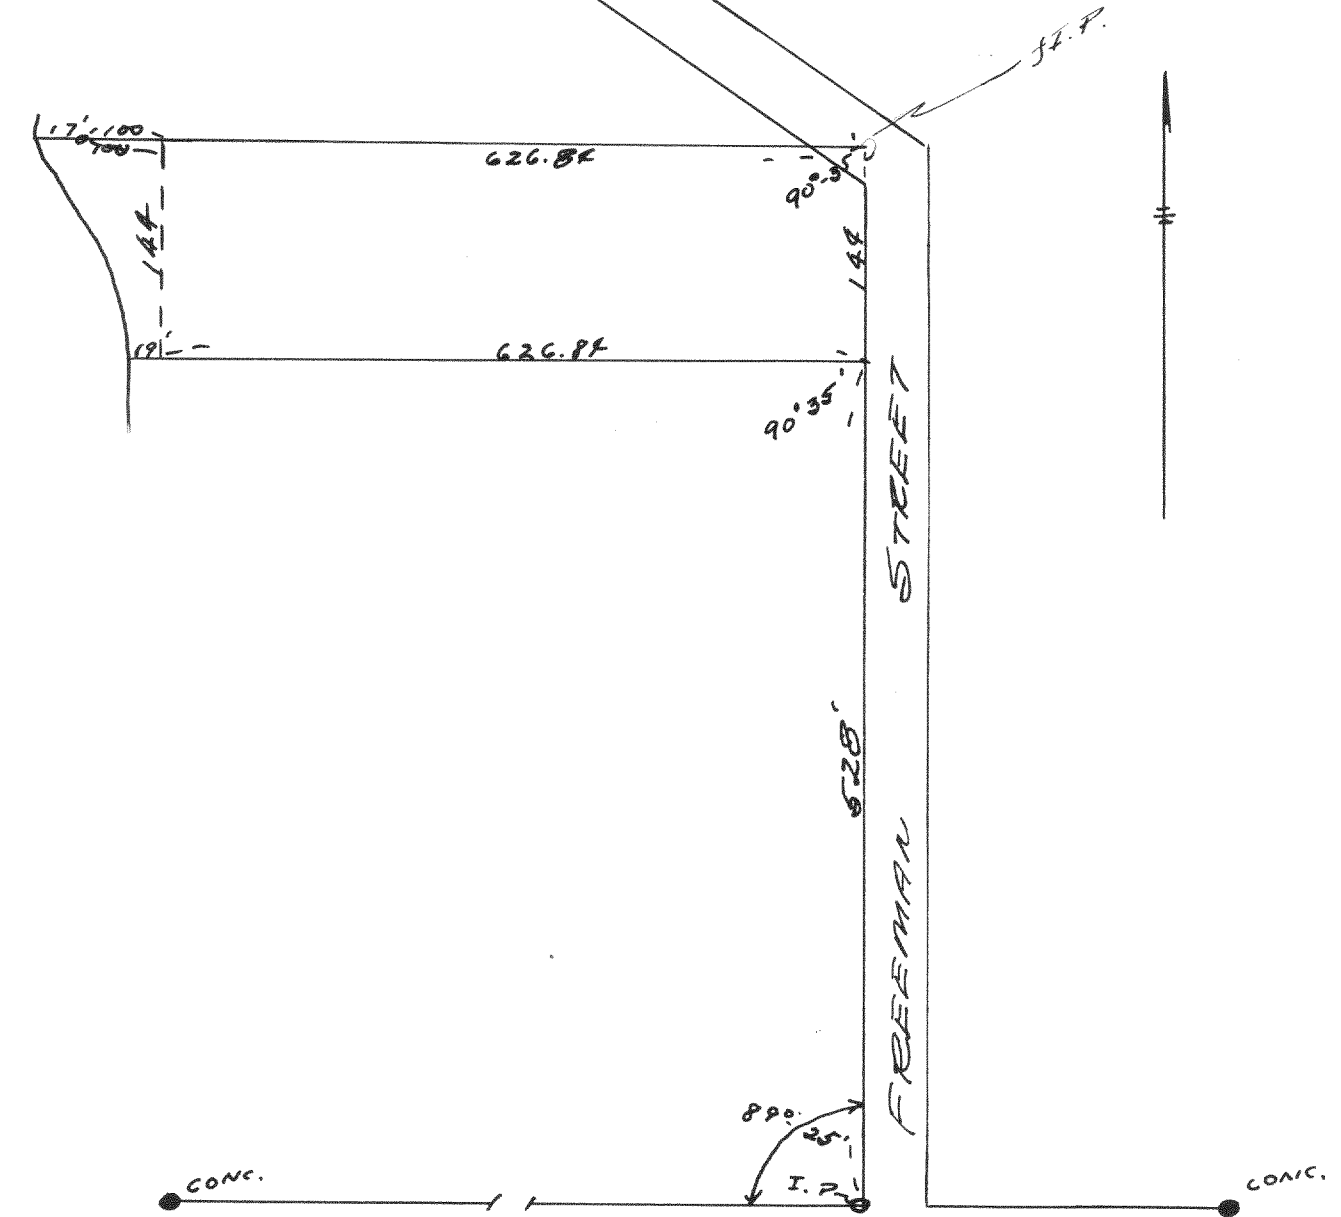

Plat of survey of part of NE 1/4  
Sec 35 IN RISE, in the Village of  
Senoia City.  
May 1939  
Lloyd L. Jensen  
by H. E. J.