



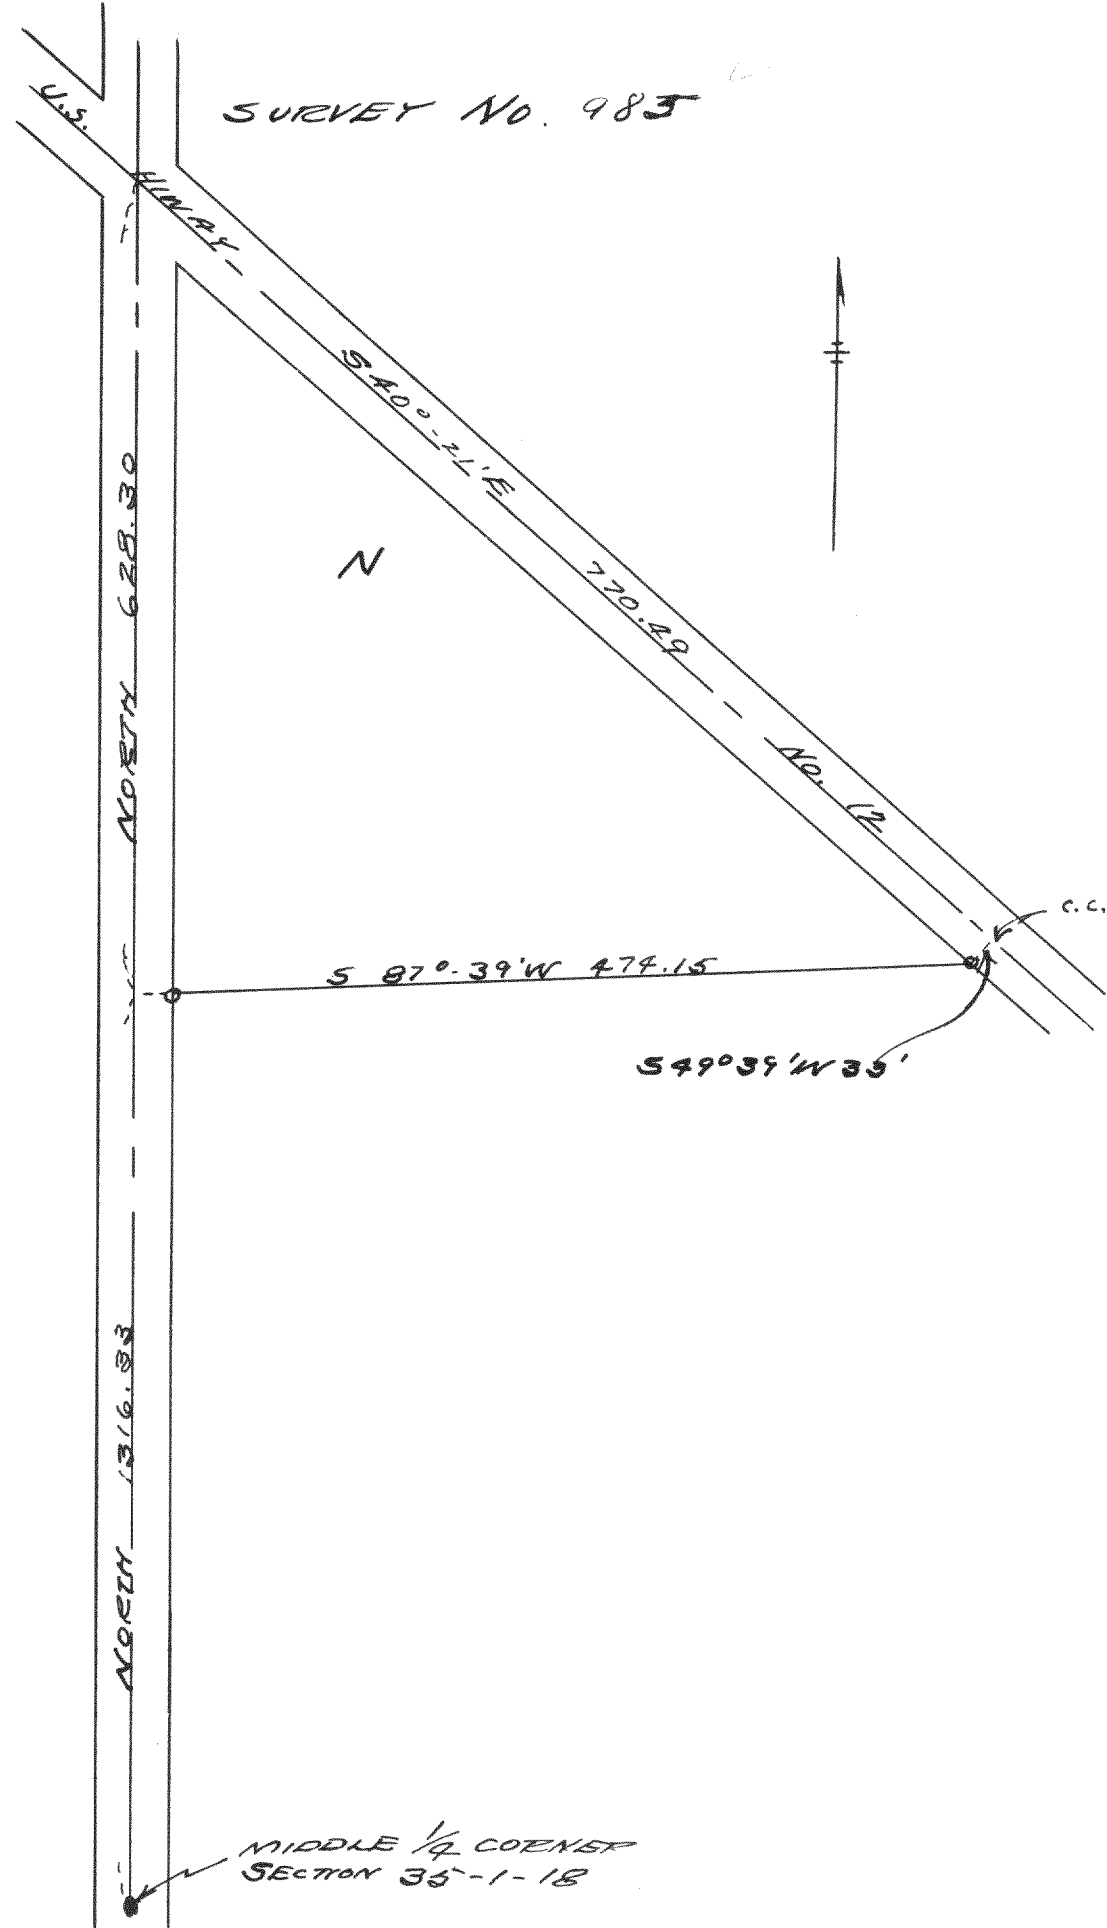

Plat of survey part of NE¹/₄
of section 35 T1N R18E
June, 1939
Lloyd L. Jensen
by K.E.J.

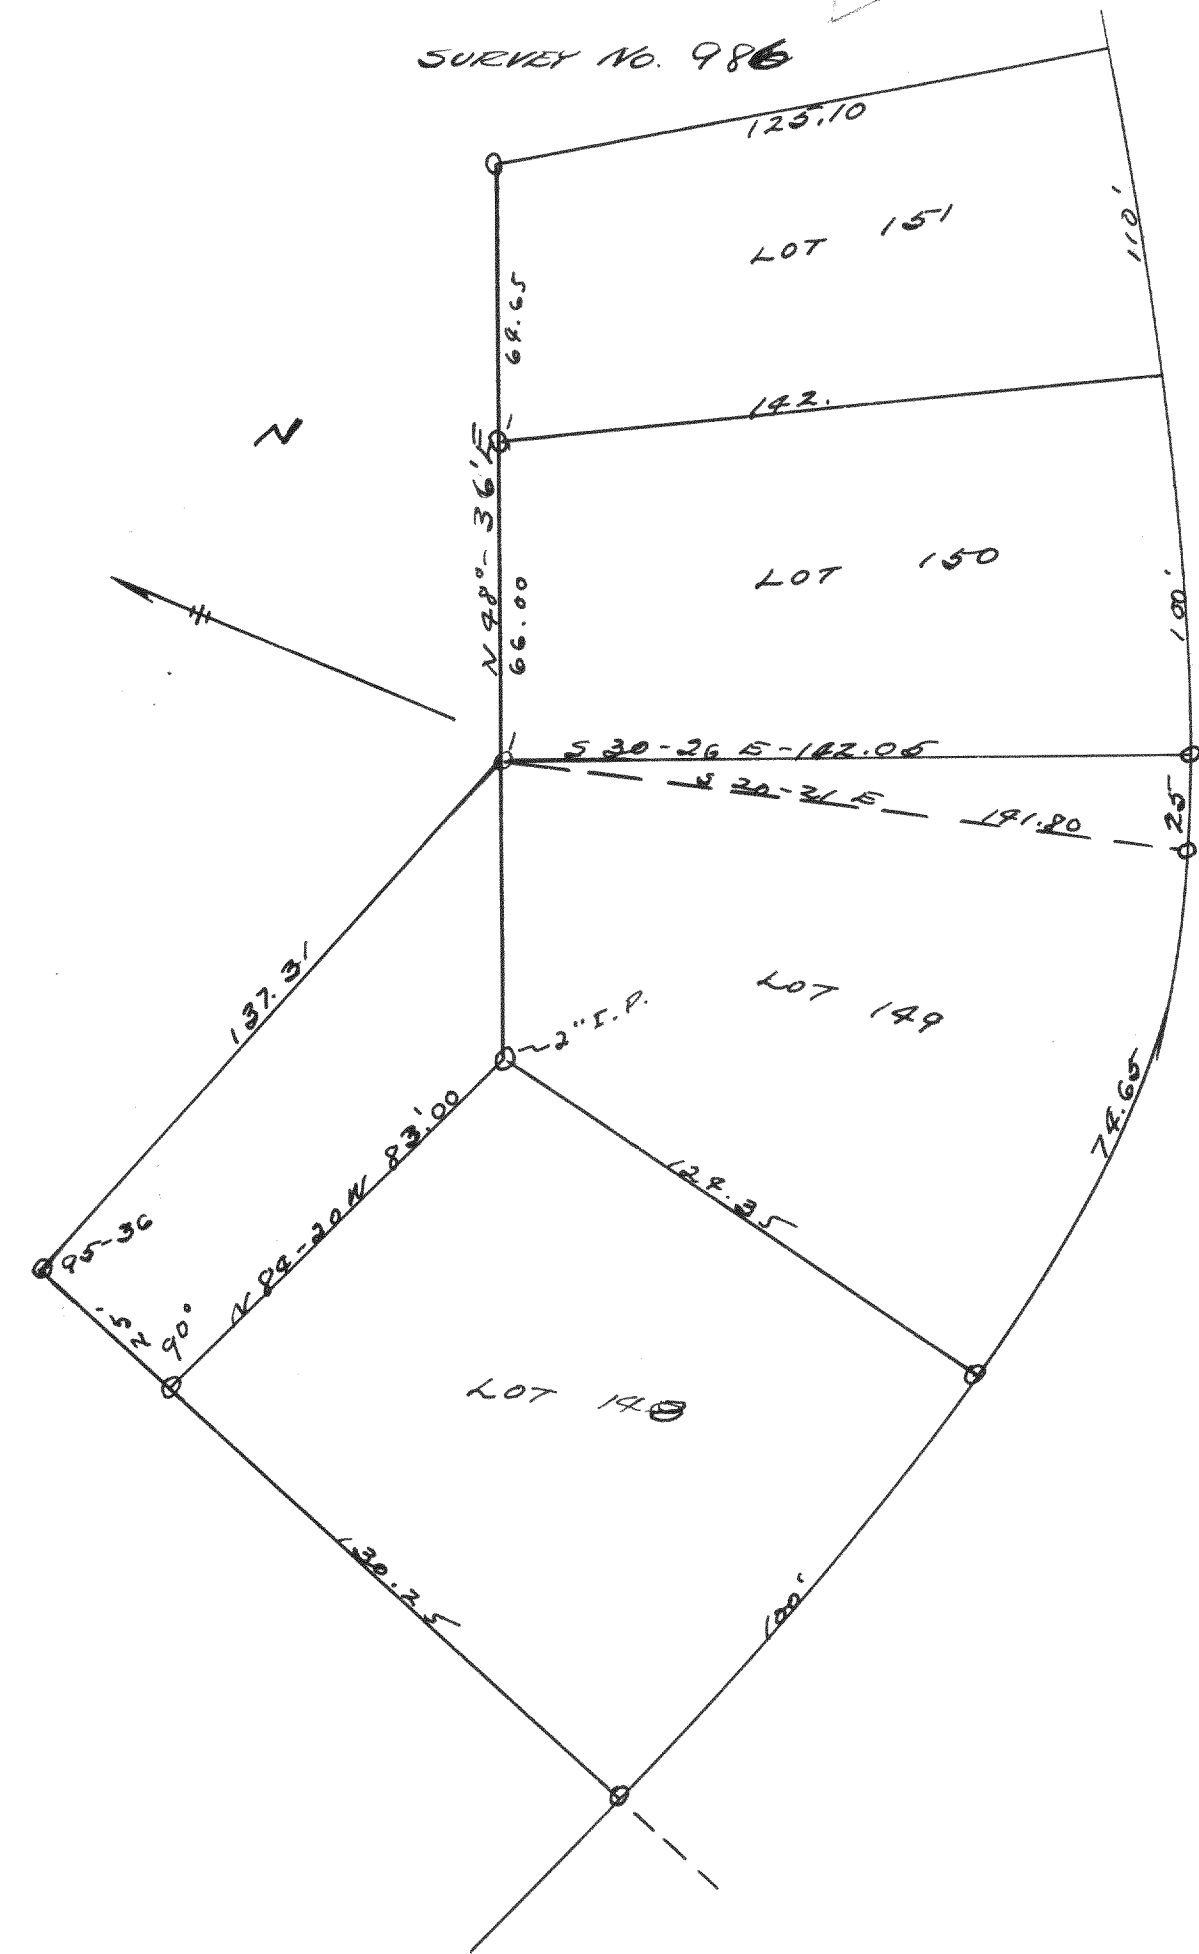

Plat of survey of lots 148 to 151
of Unit 2 of Co. Club estates in
the Village of Montand, Walworth
County Wisconsin
May 18, 1939
Lloyd L. Jensen
by K.E.J.