



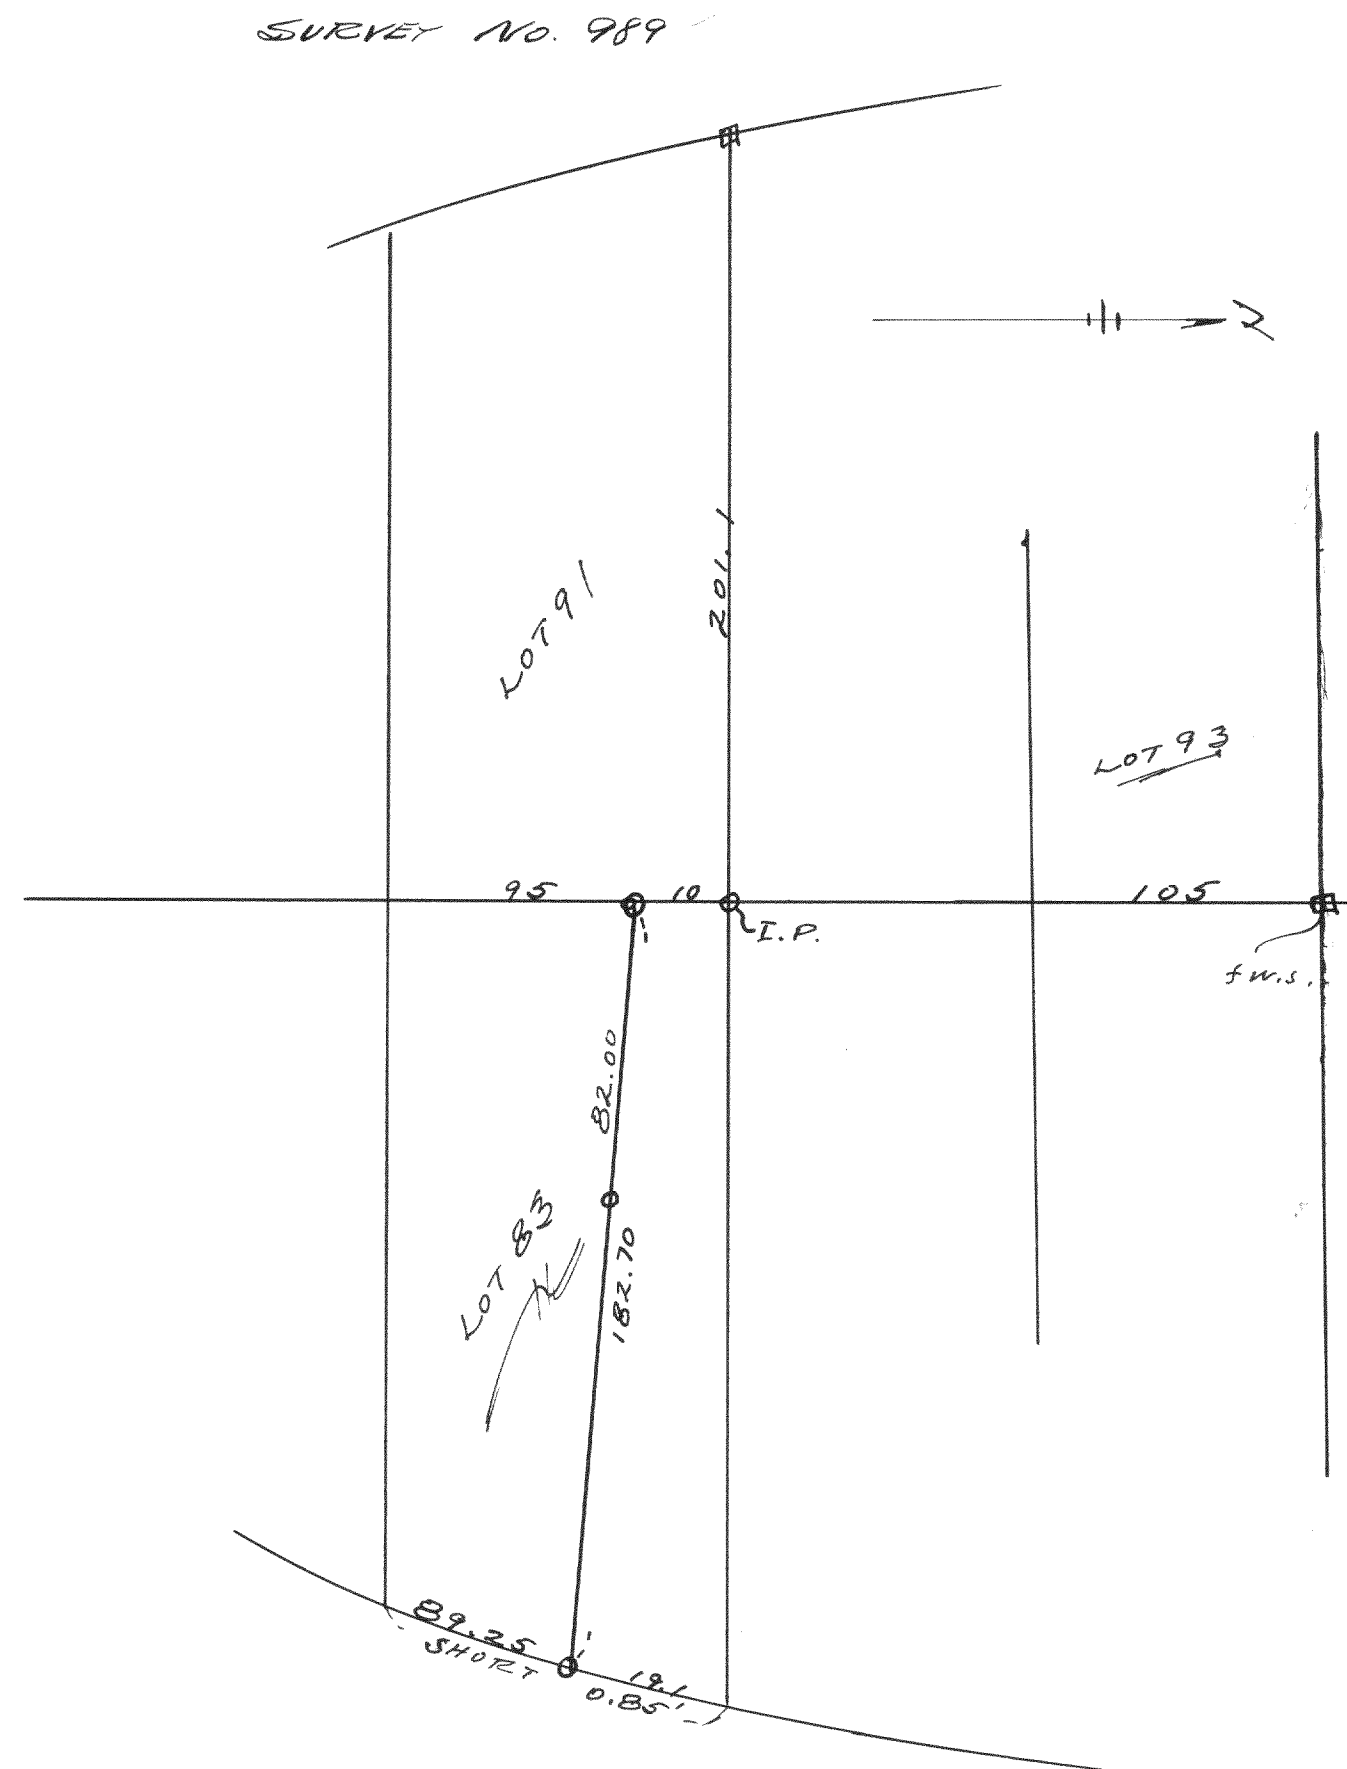

Plat of survey of part of Lot 83 of
Unit 2 of Country Club Estates, Montana
Wisconsin.

April, 1939

Lloyd L. Jensen
by H. E. J.

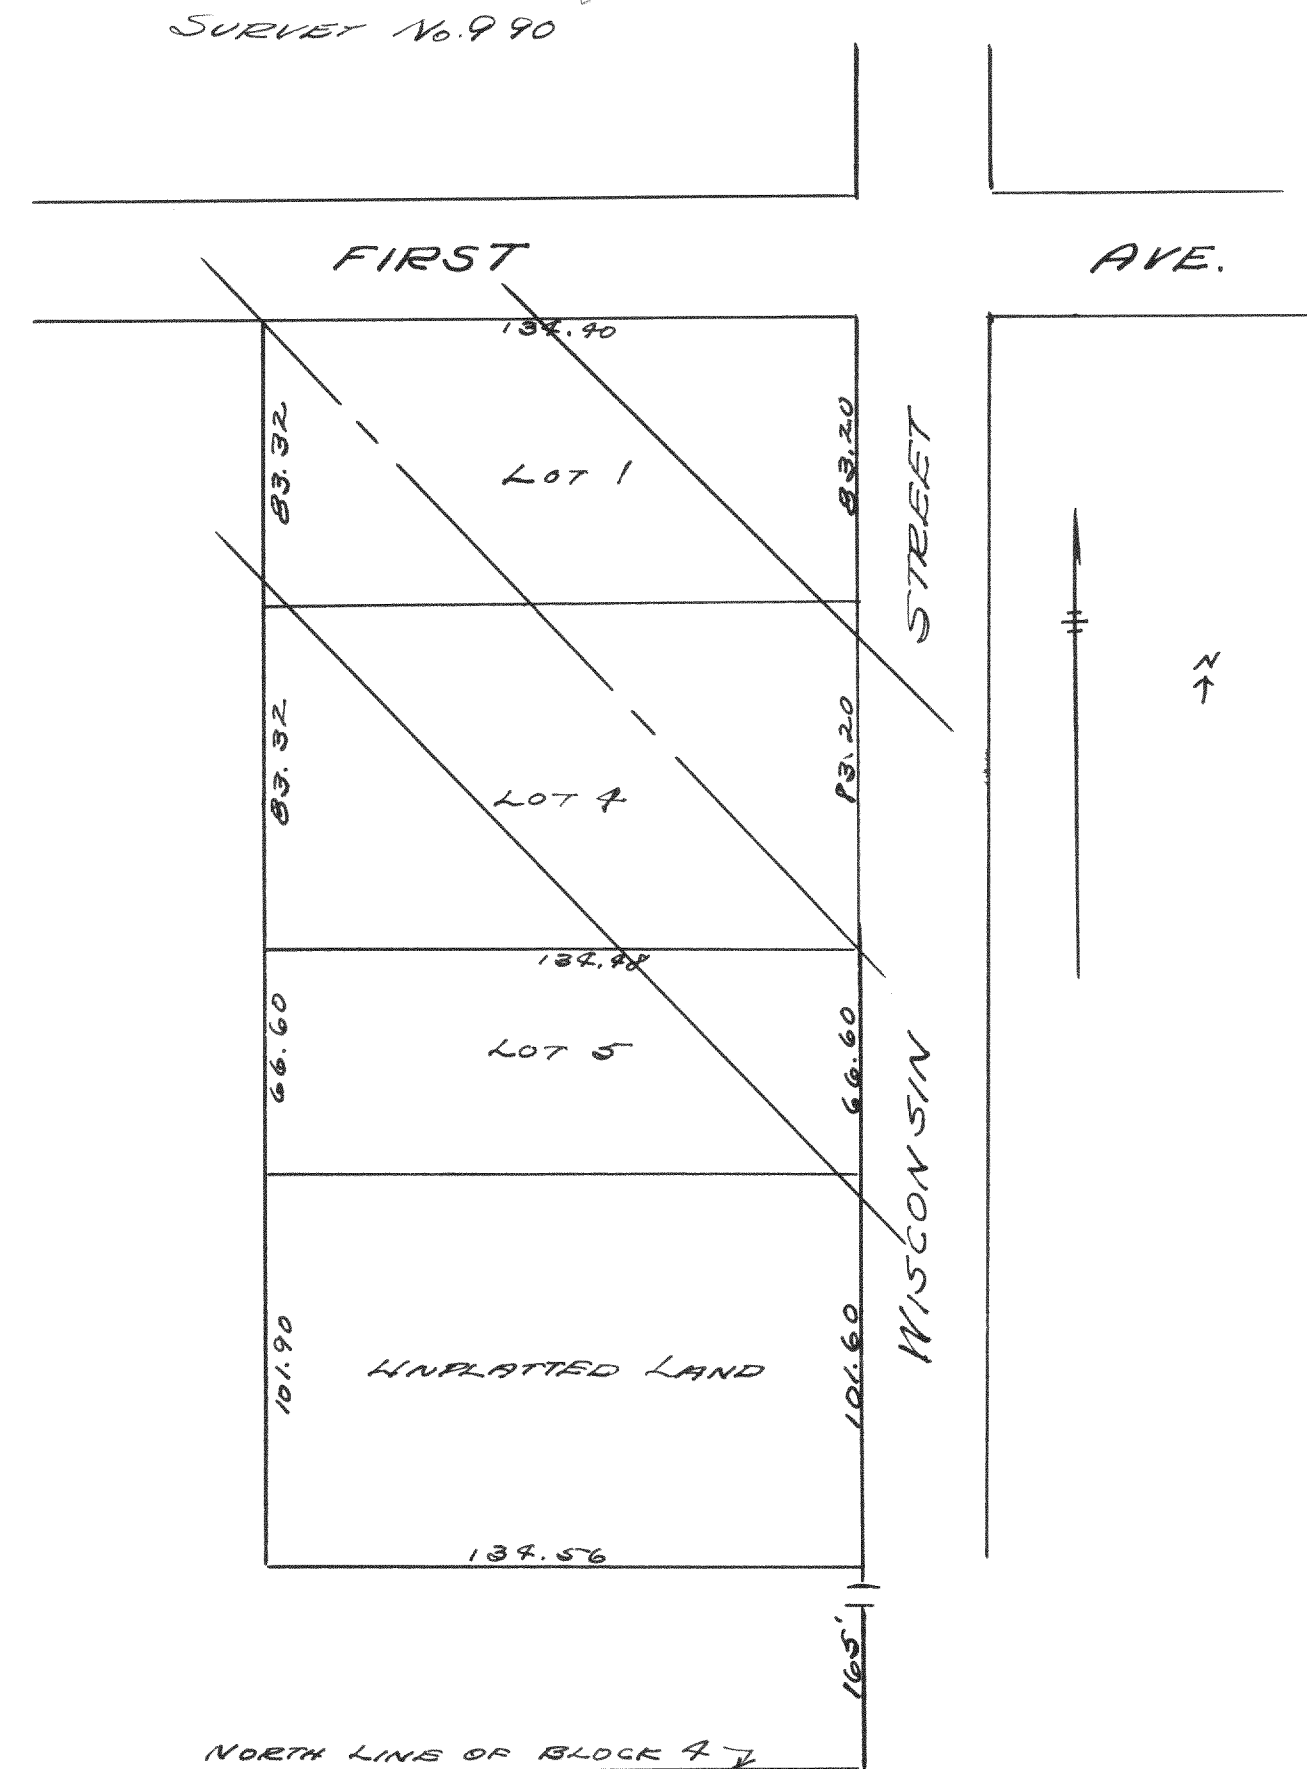

Plat of survey of Lots 1, 4 & 5 - Blk 37
of Davis' Add. and adjoining unplatted
land all in the City of Elkhorn,
Walworth County, Wisconsin.

June 12, 1939

Lloyd L. Jensen
by H. E. J.