




SURVEY No. 996

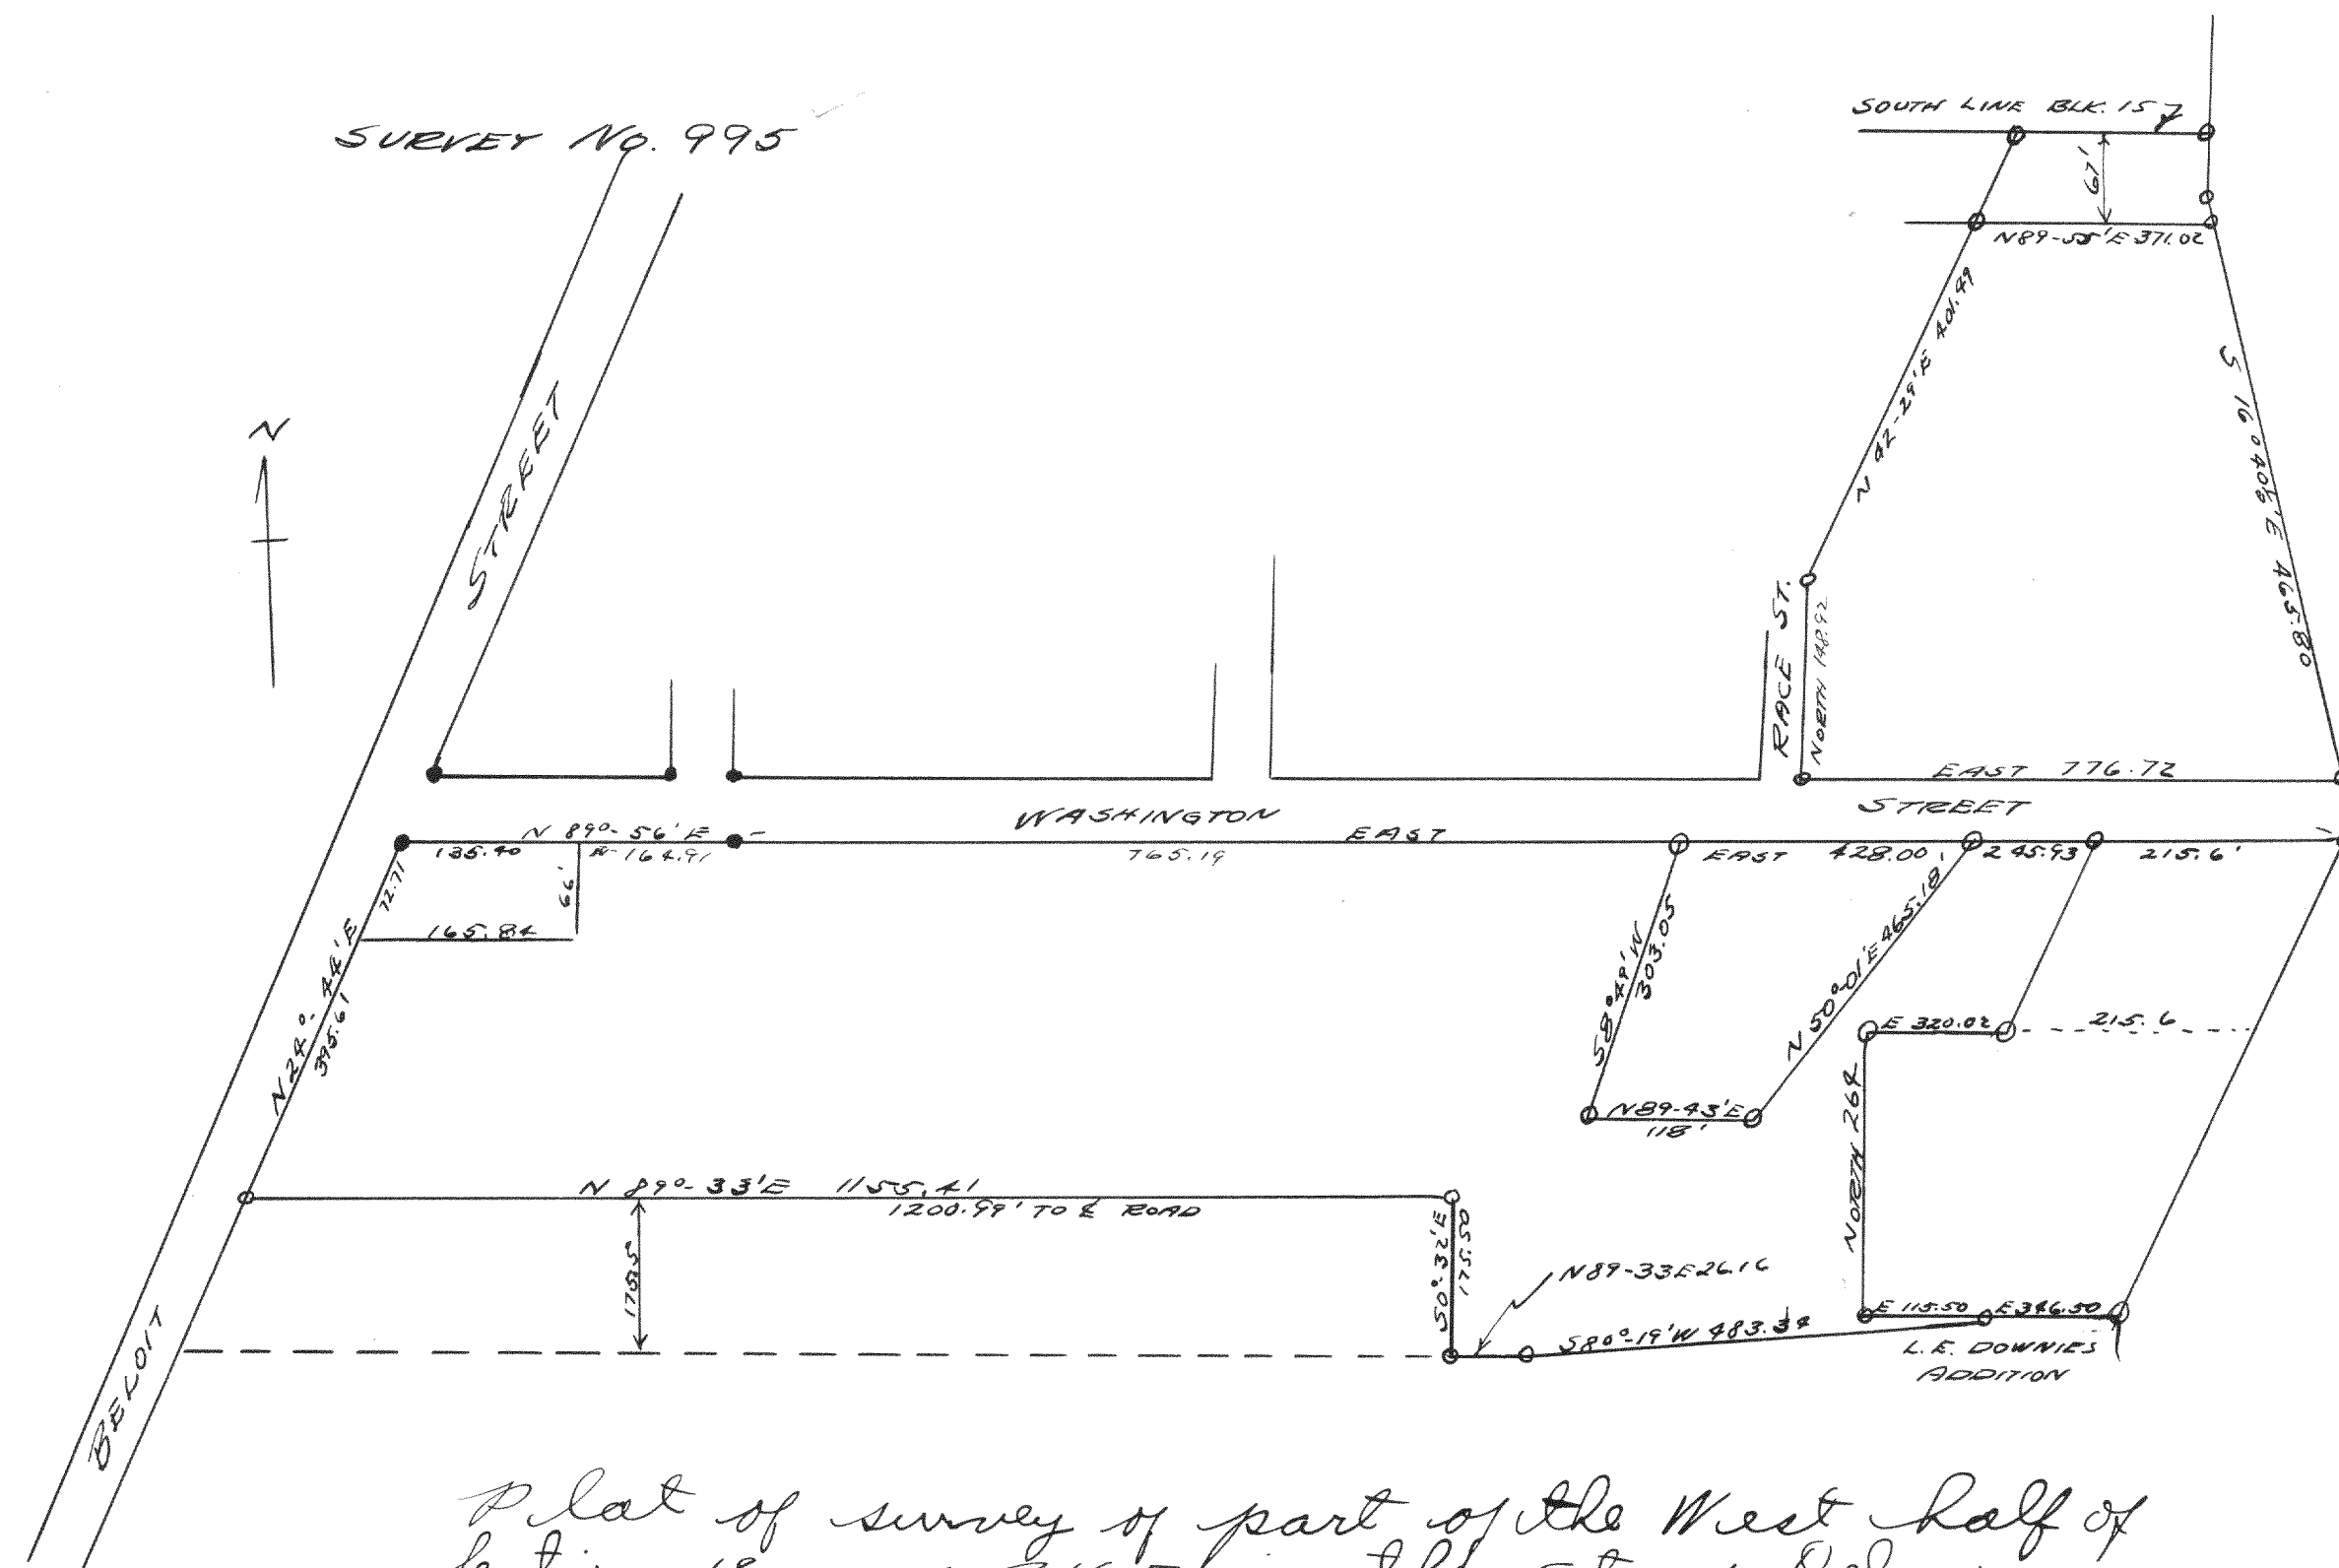