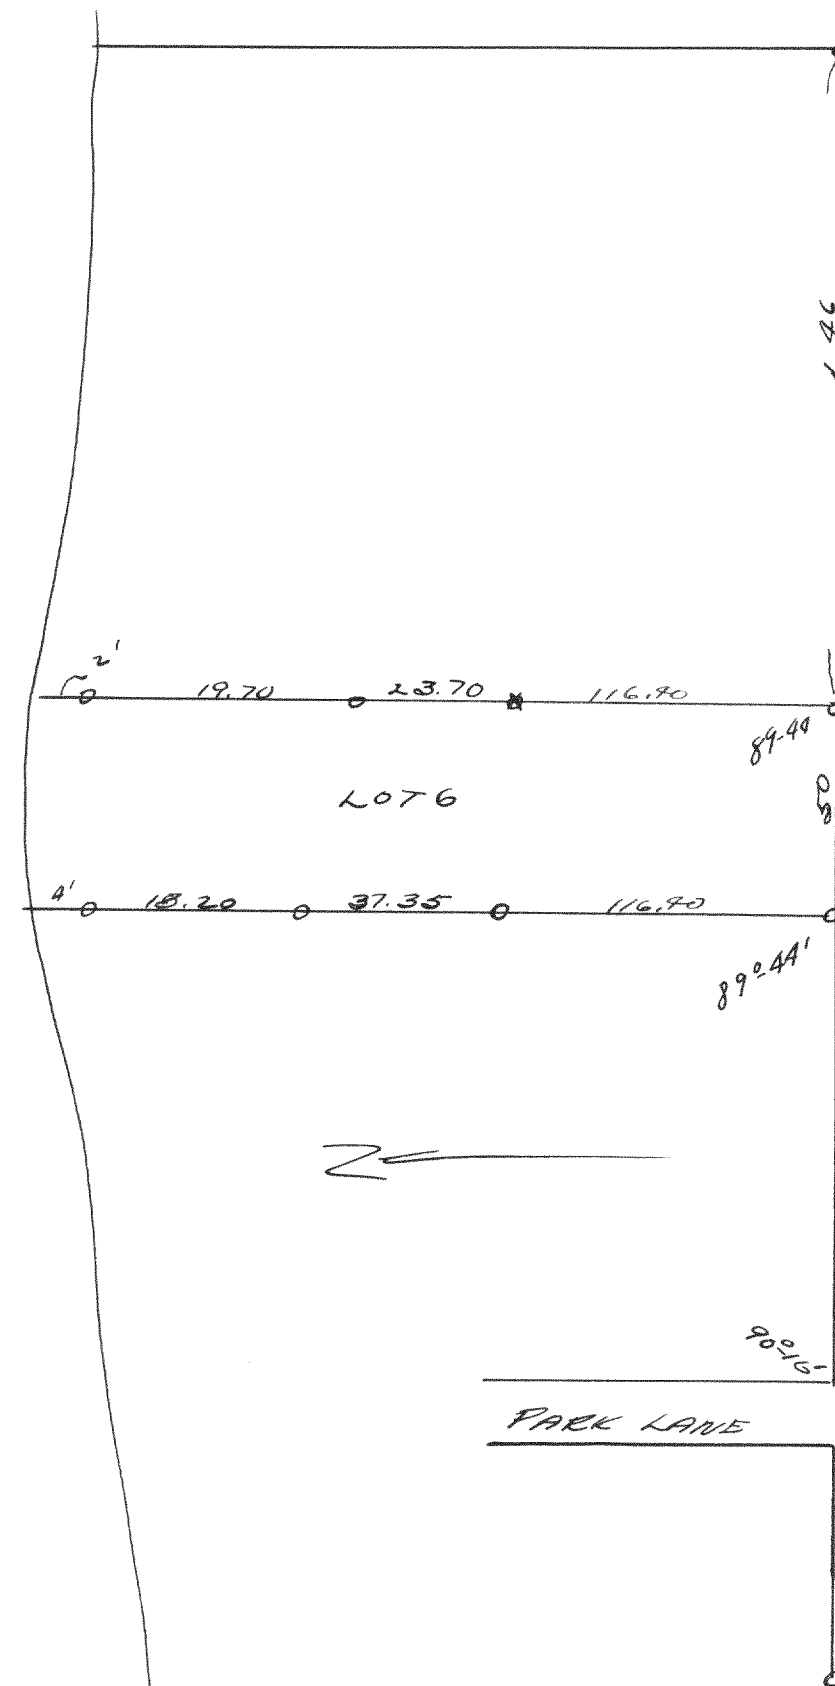
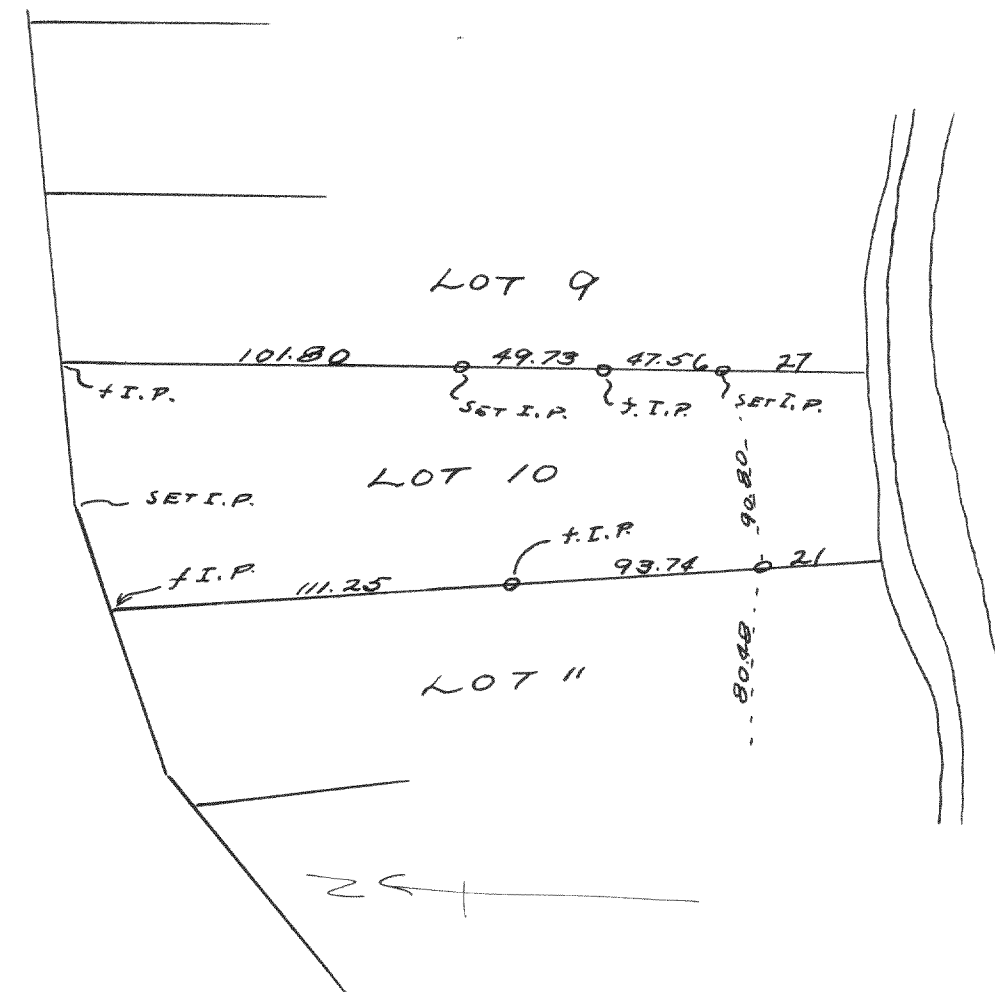


SURVEY No. ¹⁰⁰⁹~~1006~~

Plat of survey of Lot 6 of
Edgewater Terrace, Walworth
County Wisconsin (1-17)
July, 1939 Lloyd L. Jensen
by H.E.J.

SURVEY No. ¹⁰¹⁰~~1007~~

Plat of survey of Lot 10 of
Morris Park, a subd. in
the SW 1/4 of Section 26-7-16
Walworth Co. Wis.

8-5-39

Lloyd L. Jensen
by H.E.J.