



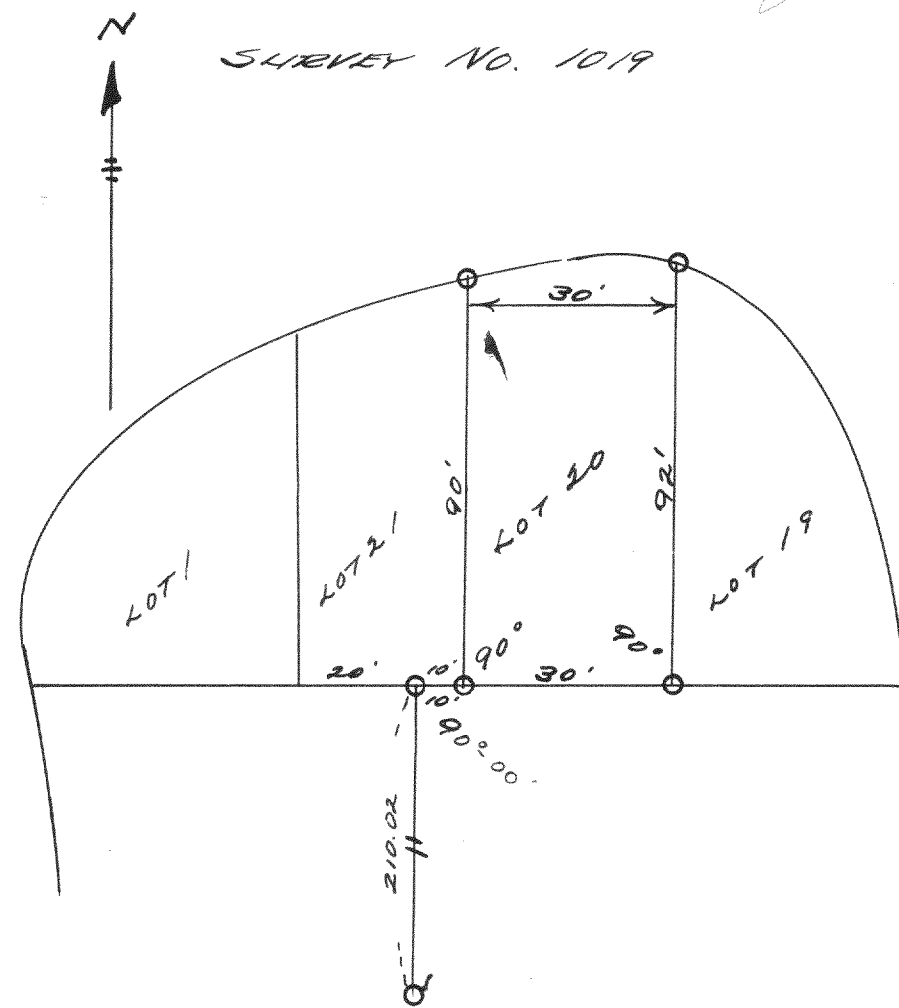


Survey of lot 20 block "O"
of Delavan Lake Assembly
Grounds, Wal. Co. Wis.
Sept 26, 1938 Lloyd L. Jensen
H. E. J.

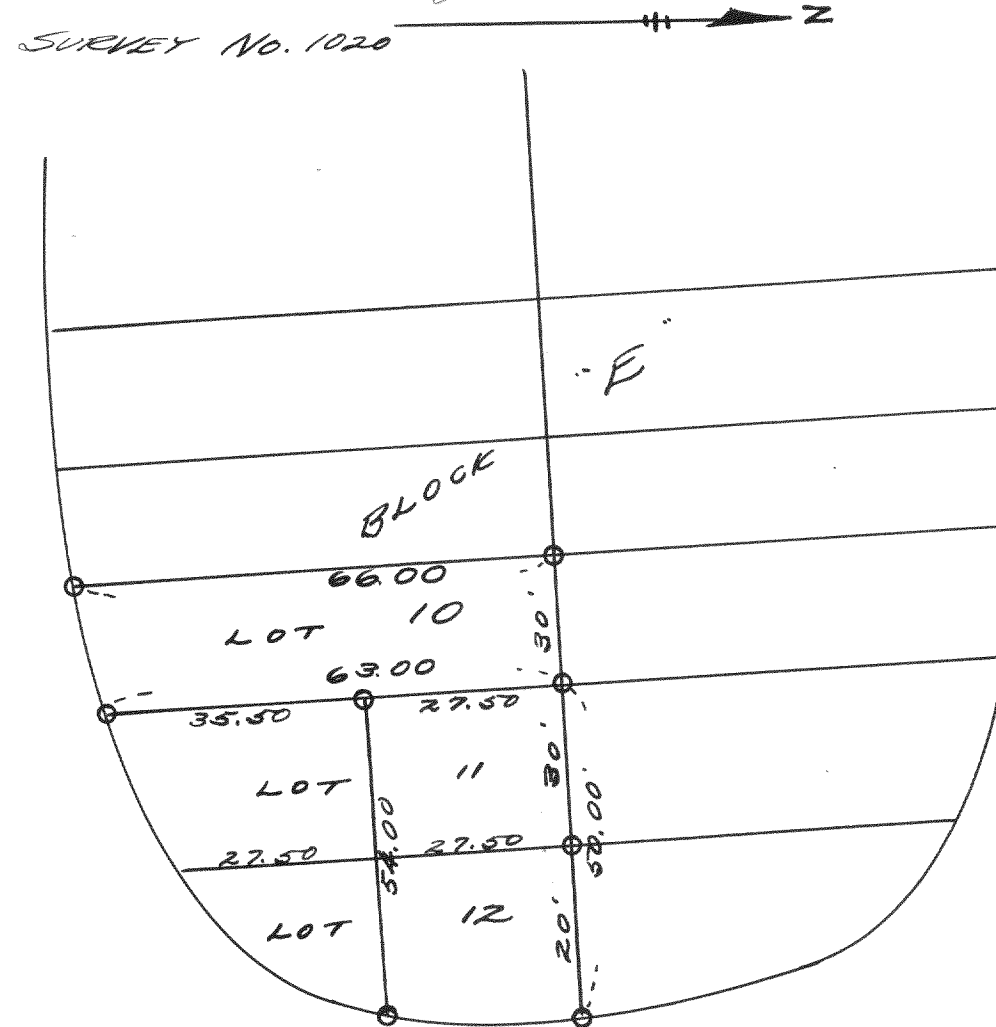

Survey of Lot 10 and the
Northerly 27.5 ft. of lots
11 and 12 of block "E" of
Delavan Lake Assembly
Grounds.
Oct, 1939

Lloyd L. Jensen
by H. E. J.

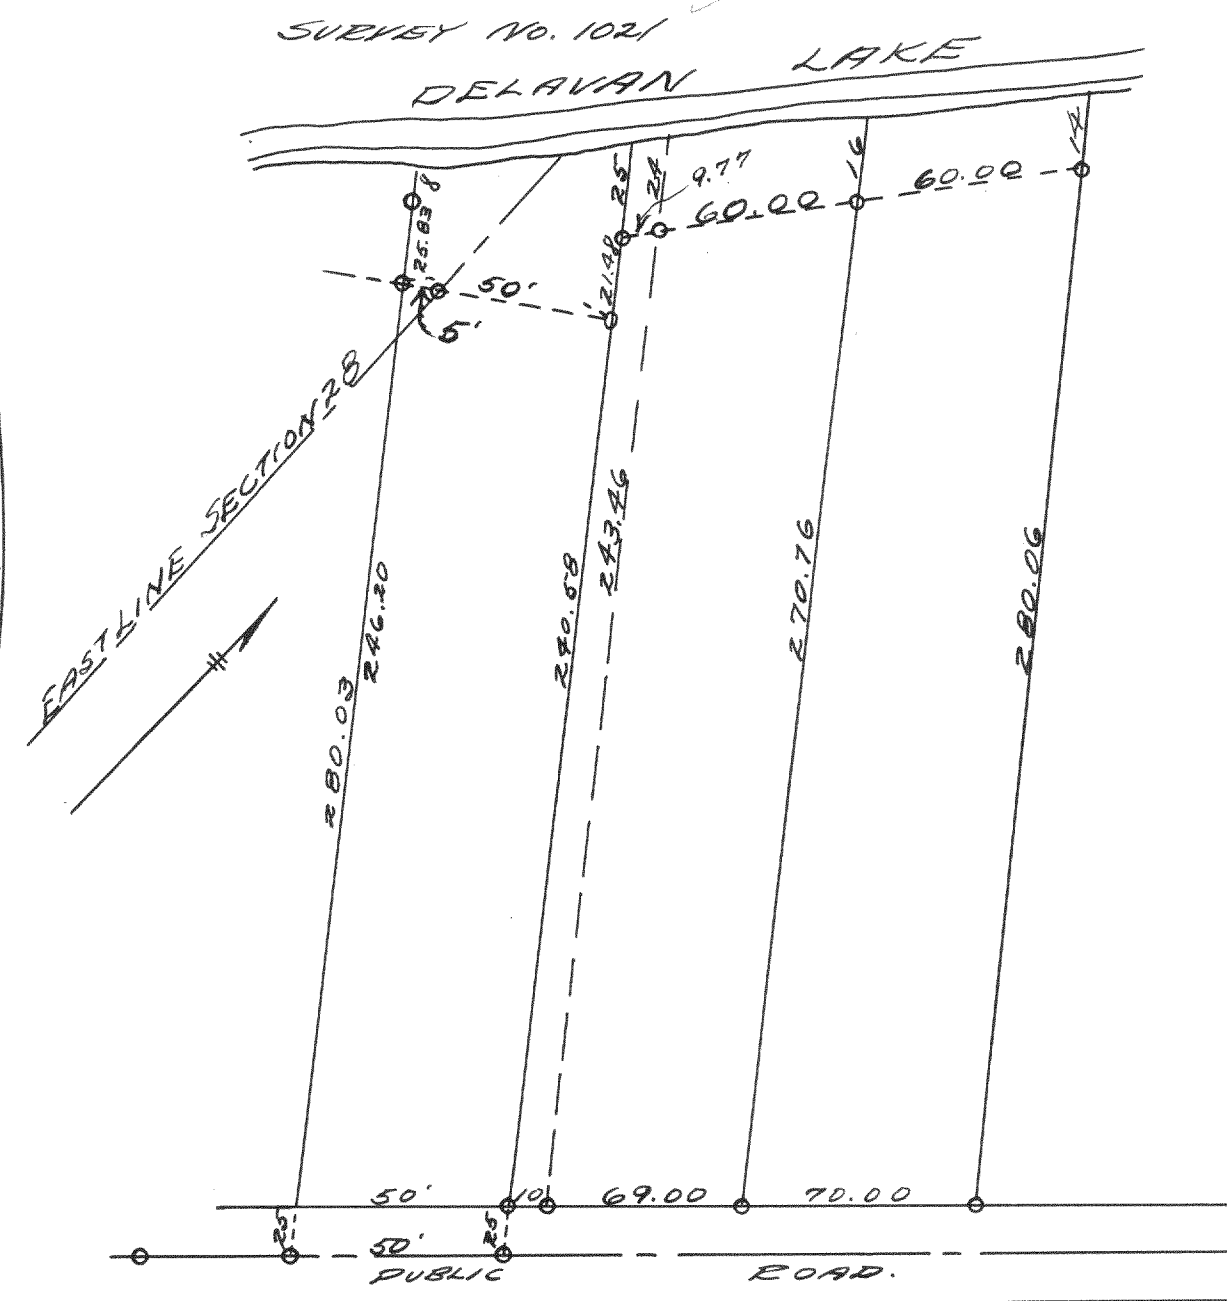

Survey of lots 3 & 4 of the Golf
Addition and an adjoining
parcel of land all located
in sections 27 & 28 of T2N
R18E Walworth County,
Wisconsin
April 29, 1939 Lloyd L. Jensen
H. E. J.