




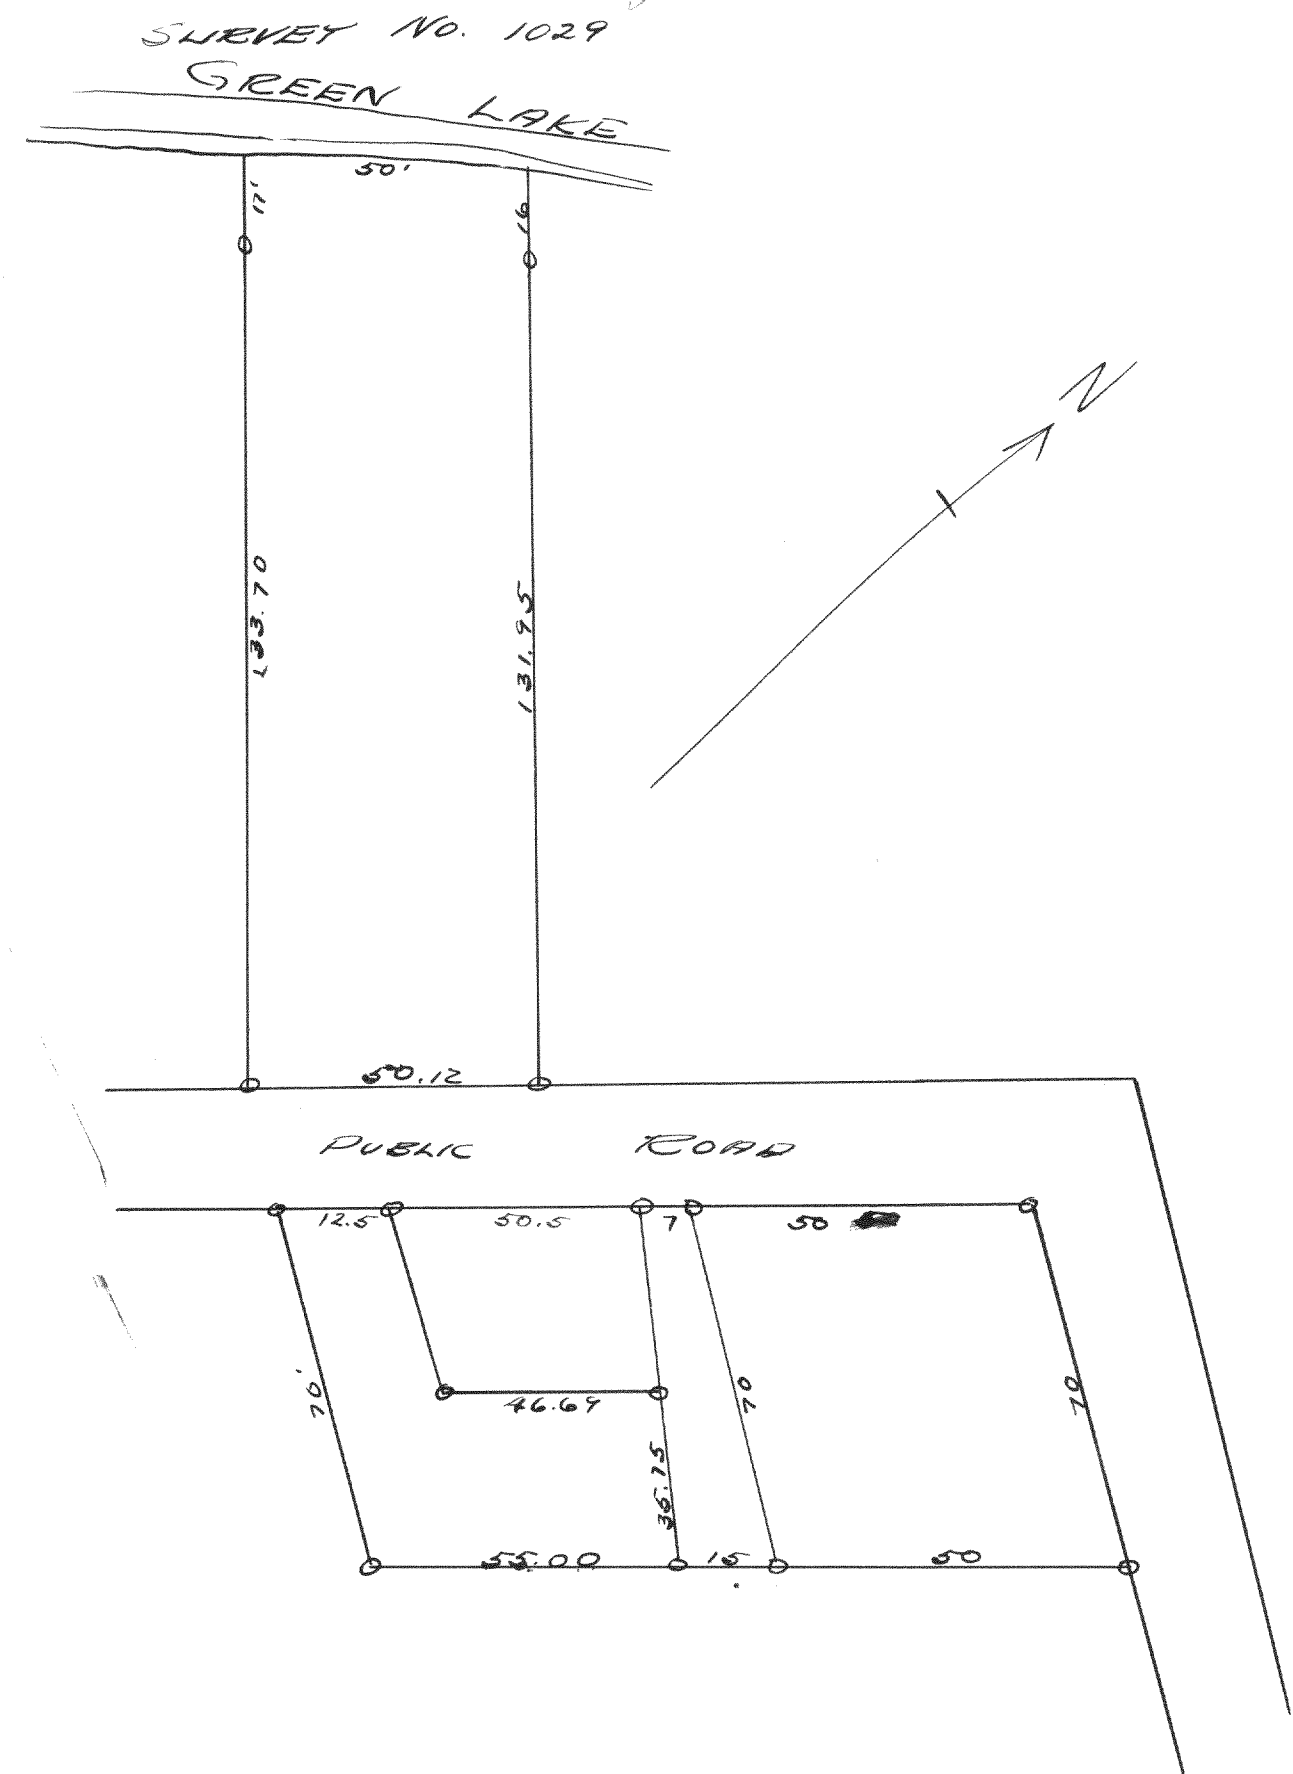

Plat of survey of lot 2 of block 2 of Green Lake Park and part of lot 5 in the E 1/2 of the SW 1/4 of Sec. 26 T4N R16E, Walworth Co. Wis.
 July 1939
 Lloyd L. Jensen
 by T.E.J.

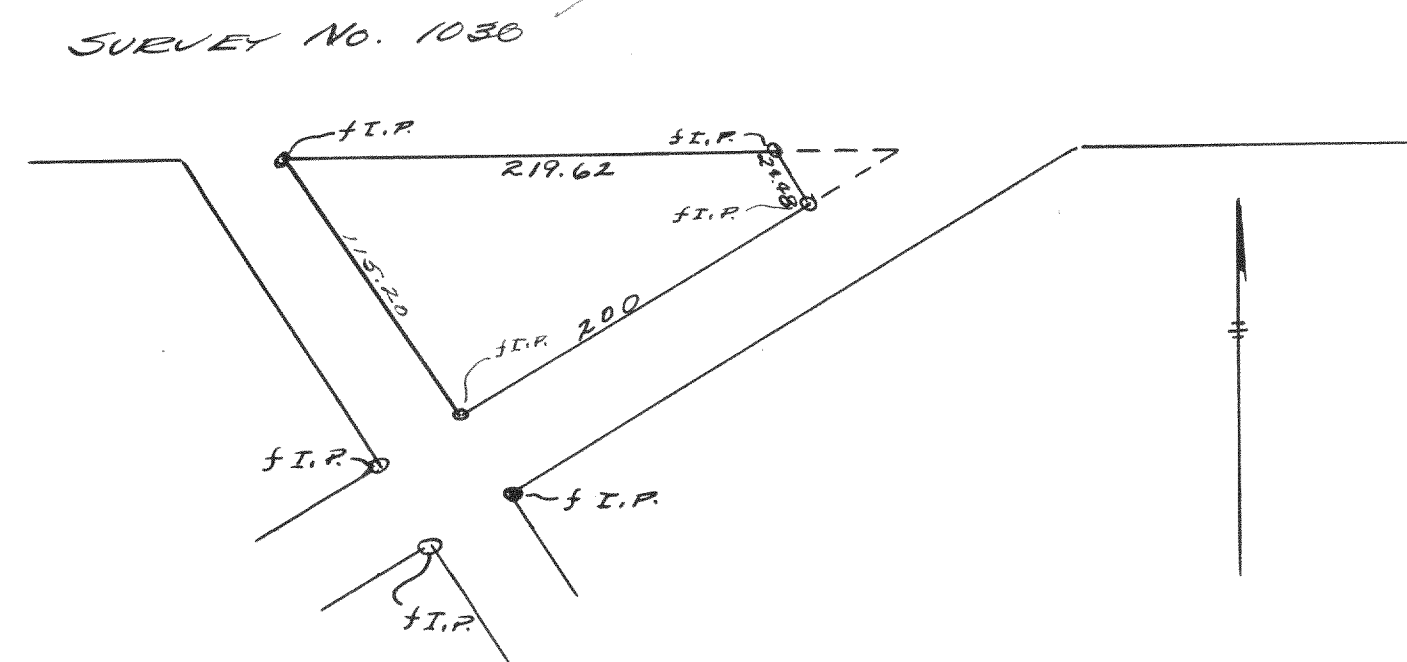

Plat of survey of blocks 5 of Delavan Lake View Crest, a subdivision located in section 31-2-16
 July, 1939
 Lloyd L. Jensen
 by T.E.J.

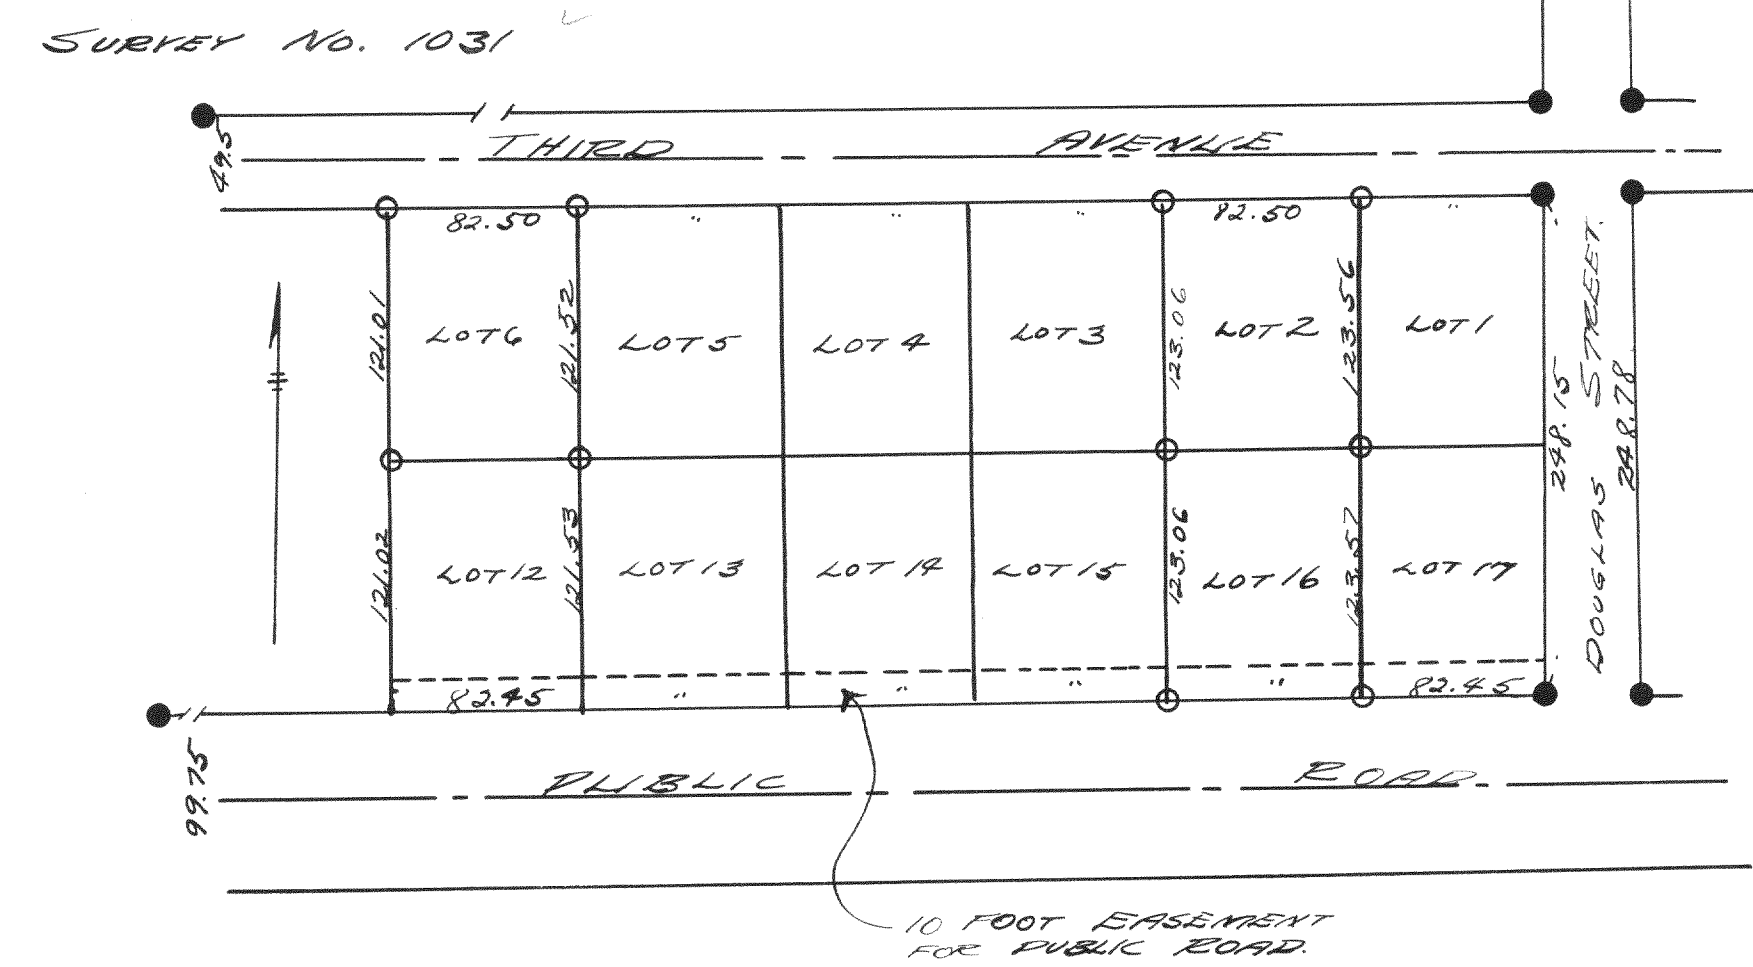

Survey of lots 2, 16 & 6 of block 9 of the original Village of Montand, Wal. Co. Wis.
 February 1939
 Lloyd L. Jensen
 by T.E.J.