

Record of Survey.

DESCRIPTION

35

OF SECTION, QUARTER SECTION AND QUARTER QUARTER SECTION CORNERS

H. C. MILLER CO. MFG. STATIONERS, MILWAUKEE X15000

GOVERNMENT CORNERS				Bearing Trees	In. Dia.	Courses they bear	Links Distant					Bearing Trees	In. Dia.	Courses they bear	Links Distant					Bearing Trees	In. Dia.	Courses they bear	Links Distant					
No.																												
1.	N. W. Sec. Cor. identified,	No. 96																										
2.	N. E. Sec. Cor. identified,																											
3.	S. E. Sec. Cor. identified,																											
4.	S. W. Sec. Cor. identified,																											
5.	N. ¼ Sec. Cor. identified,																											
6.	E. ¼ Sec. Cor. identified,																											
7.	S. ¼ Sec. Cor. identified,																											
8.	W. ¼ Sec. Cor. identified,																											
Subdivision Corners																												
No.																												
1.	Center ¼ Sec. Cor.																											
2.	North ¼-¼s N. W. qr.,																											
3.	East ¼-¼s N. W. qr.,																											
4.	South ¼-¼s N. W. qr.,																											
5.	West ¼-¼s N. W. qr.,																											
6.	Center ¼-¼s N. W. qr.,																											
7.	North ¼-¼s N. E. qr.,																											
8.	East ¼-¼s N. E. qr.,																											
9.	South ¼-¼s N. E. qr.,																											
10.	Center ¼-¼s N. E. qr.,																											
11.	East ¼-¼s S. E. qr.,																											
12.	South ¼-¼s S. E. qr.,																											
13.	West ¼-¼s S. E. qr.,																											
14.	Center ¼-¼s S. E. qr.,																											
15.	South ¼-¼s S. W. qr.,																											
16.	West ¼-¼s S. W. qr.,																											
17.	Center ¼-¼s S. W. qr.																											

666.5

1333

666.5

664.8

1329.6

664.8

NAMES OF SWORN ASSISTANTS

CHAINMEN

FLAGMEN

AXMEN

no. 95 Block 20 of Marion
Township....., North of Range..... of 4 Principal Meridian
as presented by the courses and distances on the following plat, and annexed field-notes of survey:
Established the center of the section at the point of intersection of STRAIGHT quarter lines.
Established all quarter-quarter corners upon the section boundary at proportional distances between known section and quarter section corners, according to the original field-notes of the Government survey.
Established all lost corners at proportionate distances between known corners, according to the original field notes of the Government survey.

From iron stake at NW cor. of Blk. 7, west at
Right angles to Wisconsin Str. 66 feet and made pt.
for W. line of Street and at N.E. cor. of Blk. 22, found
iron stake. From this NW at Right angles to Fremont
Street, 66 feet is 66.5 feet in shed. Find stake hole
at S.W. corner of Blk. 20, drive pipe and from this
run line (on offset) over pt. 66 feet NW of NE cor.
of Blk. 22 and at intersection with W. line of Str.
Set S.E. cor. of Blk. being 4' SE and 9" SW of SE cor.
of platform of scales, 124.1 feet north of this stake
set NE cor. being 49.9" from center of track.
From SW cor. 124.1 set stake for NW cor
of Blk. 49.6" from center of track, N & S lines are
284 feet.

Surveyed by William Childs
C.S.

Recorded by Lloyd S. Jensen
C.S.
Jan 20, 1934

Plat of Section....., Township..... North, Range..... of 4 Principal Meridian Scale
80 chains to 6 inches. The figures in red ink are the lengths of the lines as stated in the field-notes of the
Government survey.

Declination of the Magnetic Meridian from the True Meridian.....

Surveyed and sub-divided..... A. D. 1....., in accordance
with the State Laws and Instructions of the Commissioner of the General Land office, and recorded on pages
..... of Register in the County Clerk's office.

Witness my hand this..... day of..... A. D. 1.....

SURVEYOR.

J. Storey

26-1-15

666.5

1333

666.5

664.8

1329.6

664.8


NAMES OF SWORN ASSISTANTS

CHAINMEN

FLAGMEN

AXMEN

Plat of part of section 26-1-15 by William
Childs - County Surveyor.
Recorded by Lloyd S. Jensen
Jan. 22, 1934 C.S.

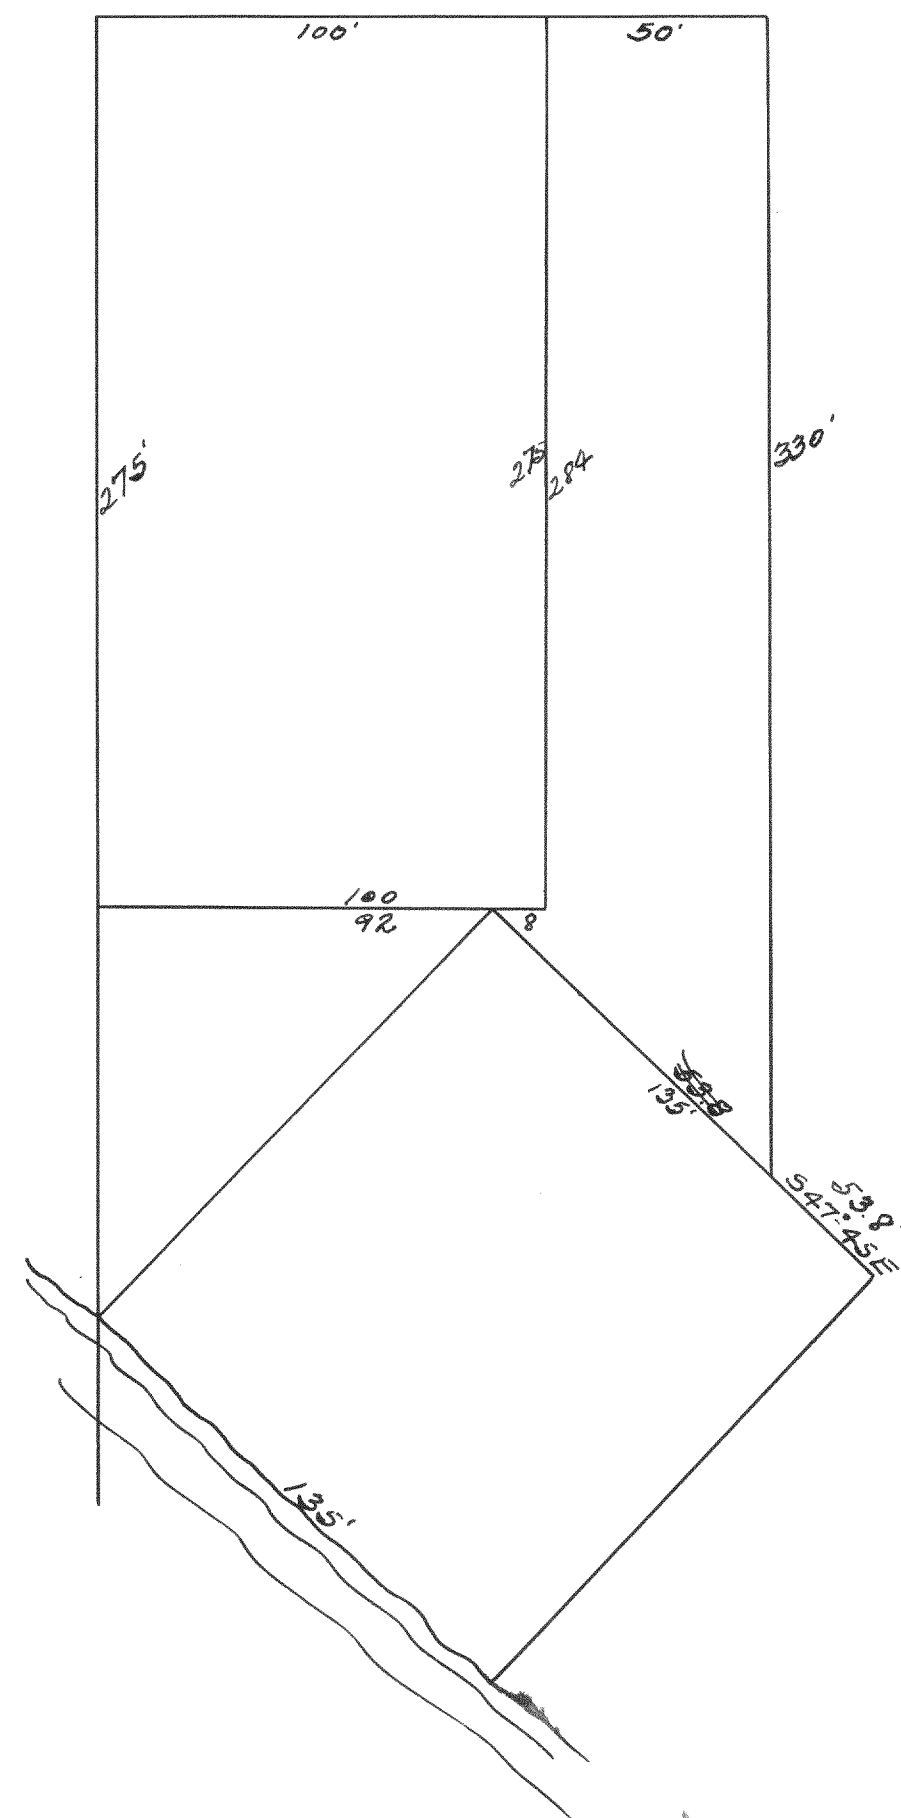

Plot of land for Anderson of Turtle Lake.
William Childs
C.S.

Recorded by Lloyd S. Jensen
C.S.
Jan 22, 1934

This is to certify, that I have this day completed a survey made by the direction of C. S. Von Sueramildt, attorney for Frank Boehm, of that portion of the northeast quarter of section 12, T3N, R15E, Walworth County, Wisconsin, lying north of the highway, and find that the amount of land in said quarter section lying west of one certain line of fence which has been adhered to for several years prior to the fall of 1906, does not exceed one-half of all of that part of the West half of the northeast quarter of said Section number 12.

Dated, August 27, 1908

William Childs
C.S.

Recorded by Lloyd S. Jensen
C.S.
Jan. 22, 1934