



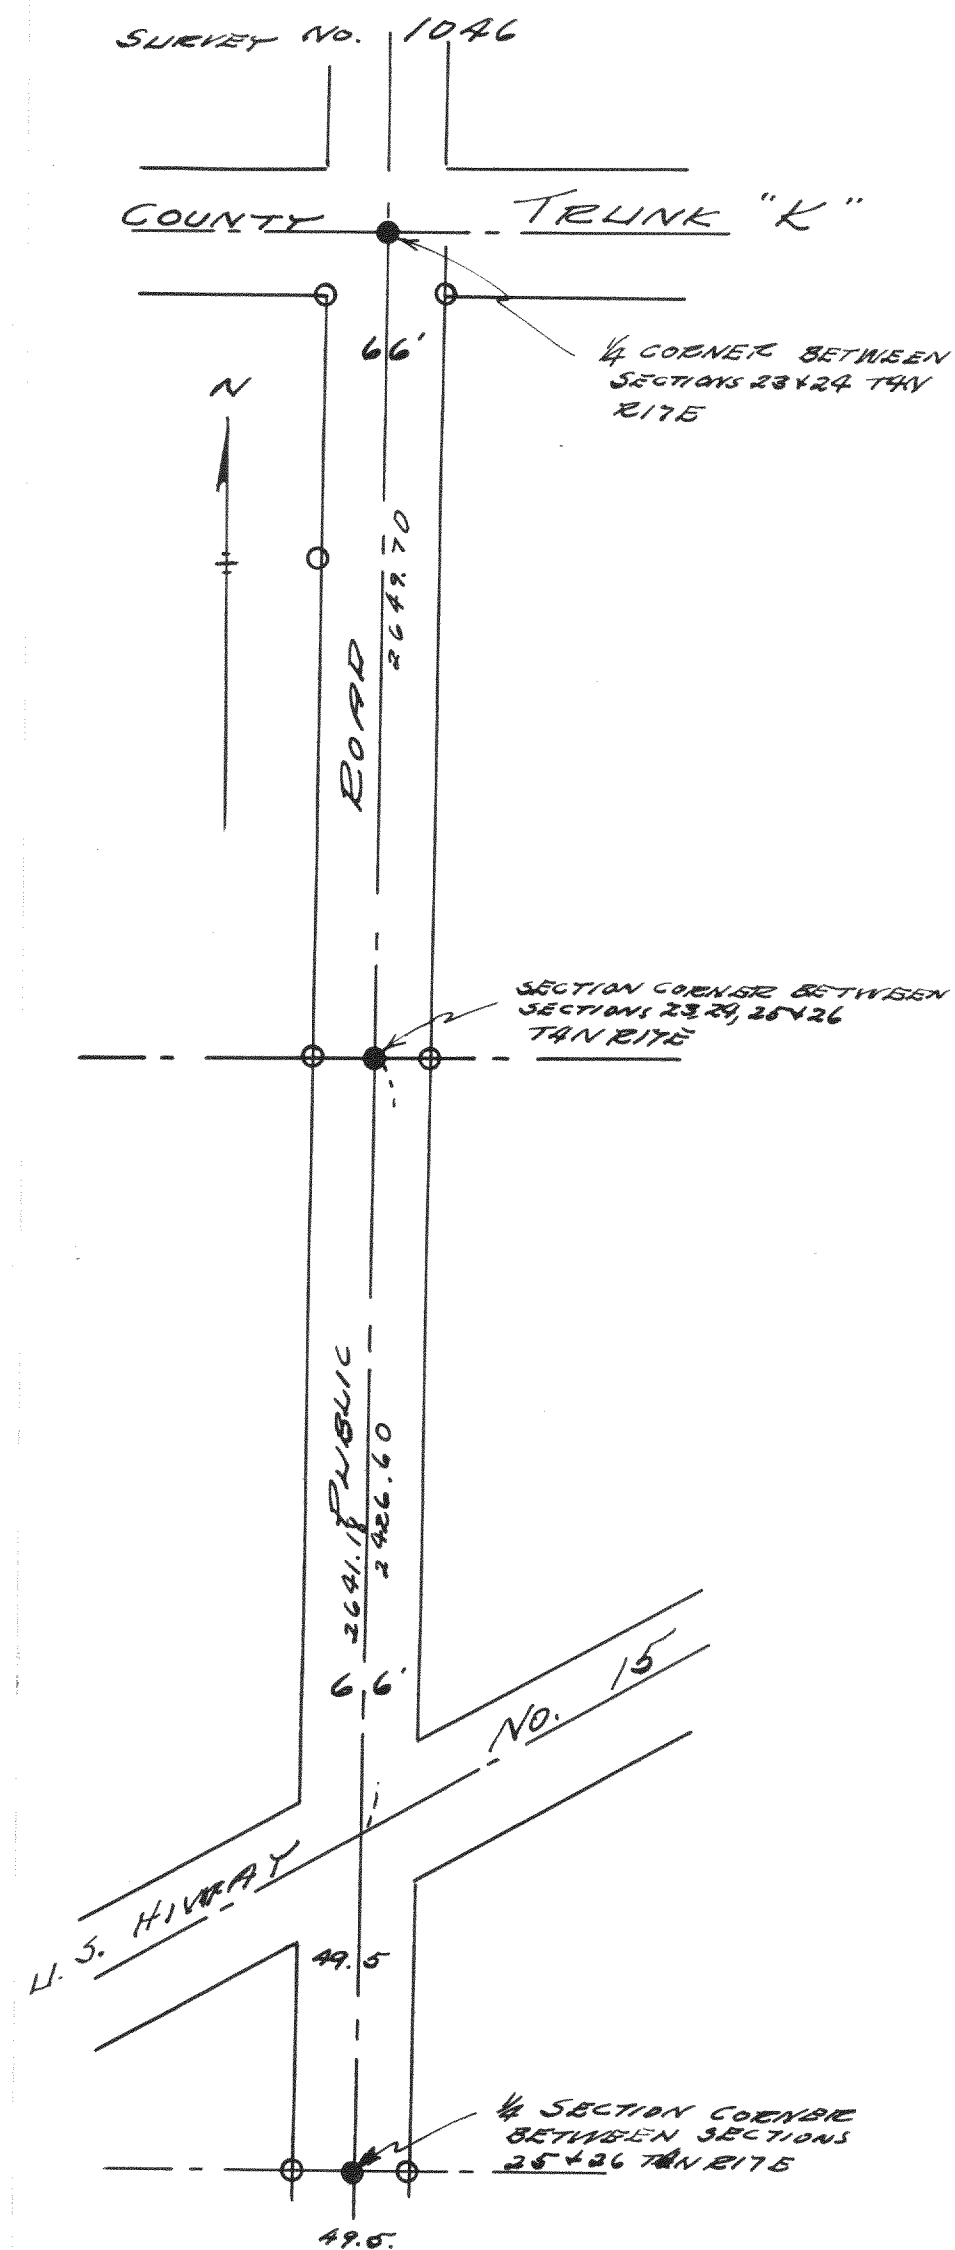

Survey made to locate road
in sections 23, 24, 25 & 26 TAN
RITE, Walworth County, Wisconsin
Nov. 1939
Lloyd L. Jensen
by F.E.J.

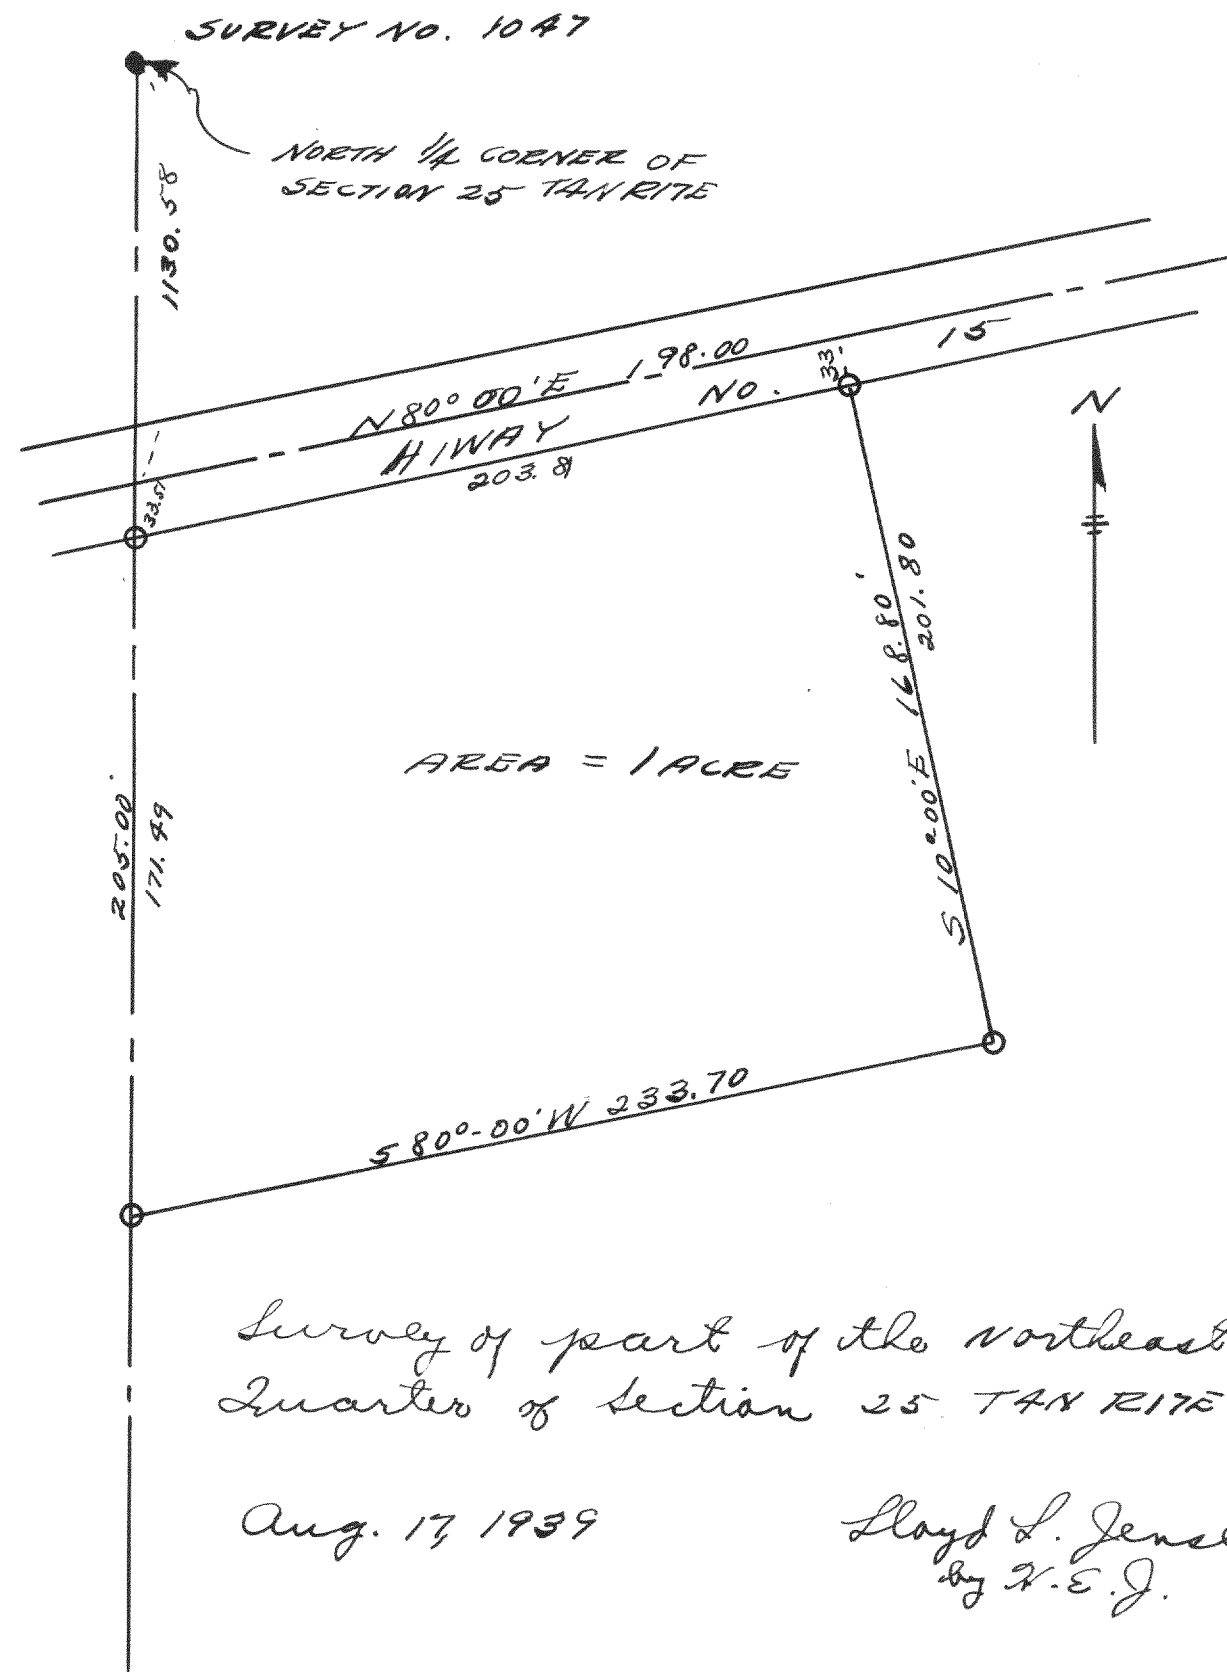

Survey of part of the Northeast
Quarter of section 25 TAN RITE

Aug. 17, 1939

Lloyd L. Jensen
by F.E.J.

